

NOTES STAGE 2 ITEMS

Three Coke Guard Rail w/  
Light Steel Posts,  
Item 538  
NB 2378+00-2385+02 LT  
SB 2378+00-2383+47 LT


Blumonic Concrete Curb,  
Item 555  
NB 2378+00-2384+50 LT

Drilling & Blasting of Solid Rock Subgrade, Item 115  
NB 2384+00-2393+00  
SB 2385+00-2393+00

PROPERTY LINE FENCE WITH STEEL POSTS ITEM 563-M00			
STA	STA	POS	
NORTHBOUND			
2378+00	2393+00	RT	
SOUTHBOUND			
2378+00	2393+00	LT	

SB CURVE DATA

$\Delta = 19^\circ 40' 30''$   
 $D = 1^\circ 00' 00''$   
 $R = 5729.58'$   
 $T = 993.53'$   
 $L = 1967.50'$   
 $E = 85.50'$   
Bank = 5/16" Per Ft

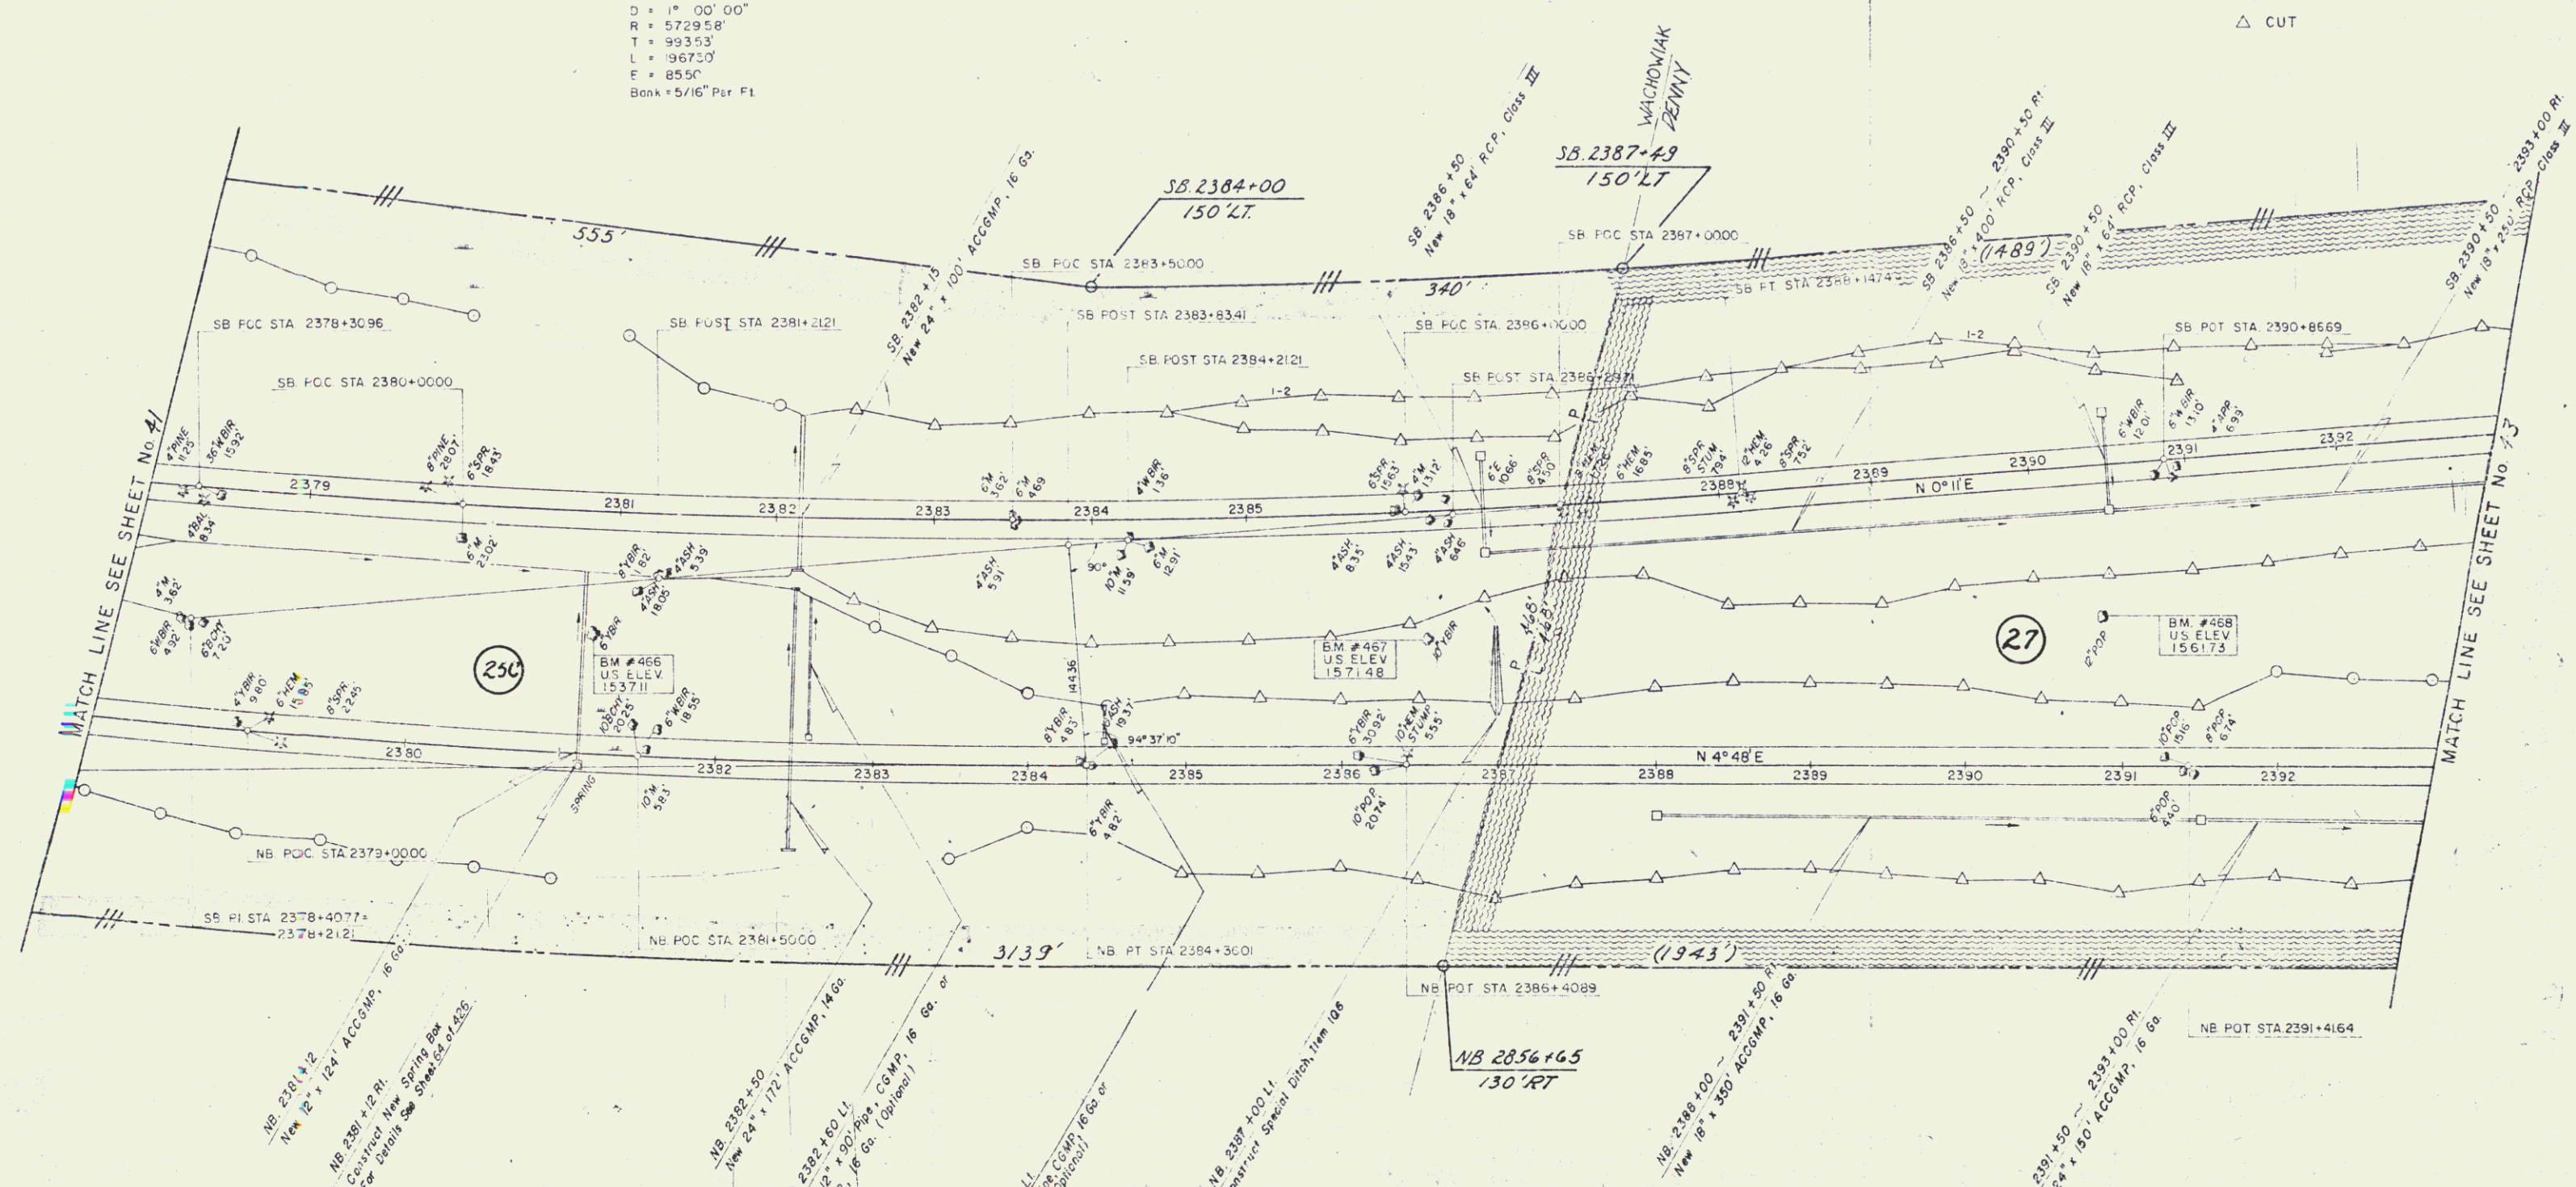

MATCH LINE SEE SHEET No. 41

MATCH LINE SEE SHEET No. 43

POSTER, GIBBELL & ASSOCIATES  
CONSULTING ENGINEERS, NEWARK, N.J.

CONTROL OF ACCESS IS COMPLETE ON THIS SHEET

PLAN SCALE  
0 20 100  
00 FEET

BROOKFIELD-WILLIAMSTOWN  
BERLIN  
189-1(40)  
SECTION No. 1  
SHEET 42 OF 50

42