

* DENOTES STAGE 2 ITEMS

Three Ccbe Guard Rail/
Light Steel Posts
Item 542
NB 2473+50-2482+00 LI
NB 2467+25-2467+00 LI
SB 2474+50-2484+00 LI


Jute Matting
Item 623
SB 2469+00-2470+00 RI
SB 2469+00-2470+00 LI

Plank Guard Rail,
Item 540
NB 2479+70 RI 40' LI


Drilling & Blasting of Solid Rock Subgrade Item 115
NB 2467+00 - 2475+25
SB 2469+25 - 2473+75
SB 2479+75 - 248+75
SB 2483+25 - 2484+00

Drilling & Blasting of Solid Rock, Item 114
SB 2483+25 - 2484+00


PRIORITY LINE FENCE WITH STEEL POSTS ITEM 583-II MUD		
STA	STA	POS.
NORTH BOUND		
2467+00	2482+00	RT
SOUTH BOUND		
2468+00	2484+00	LT

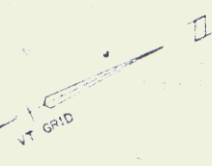

FILL
CUT

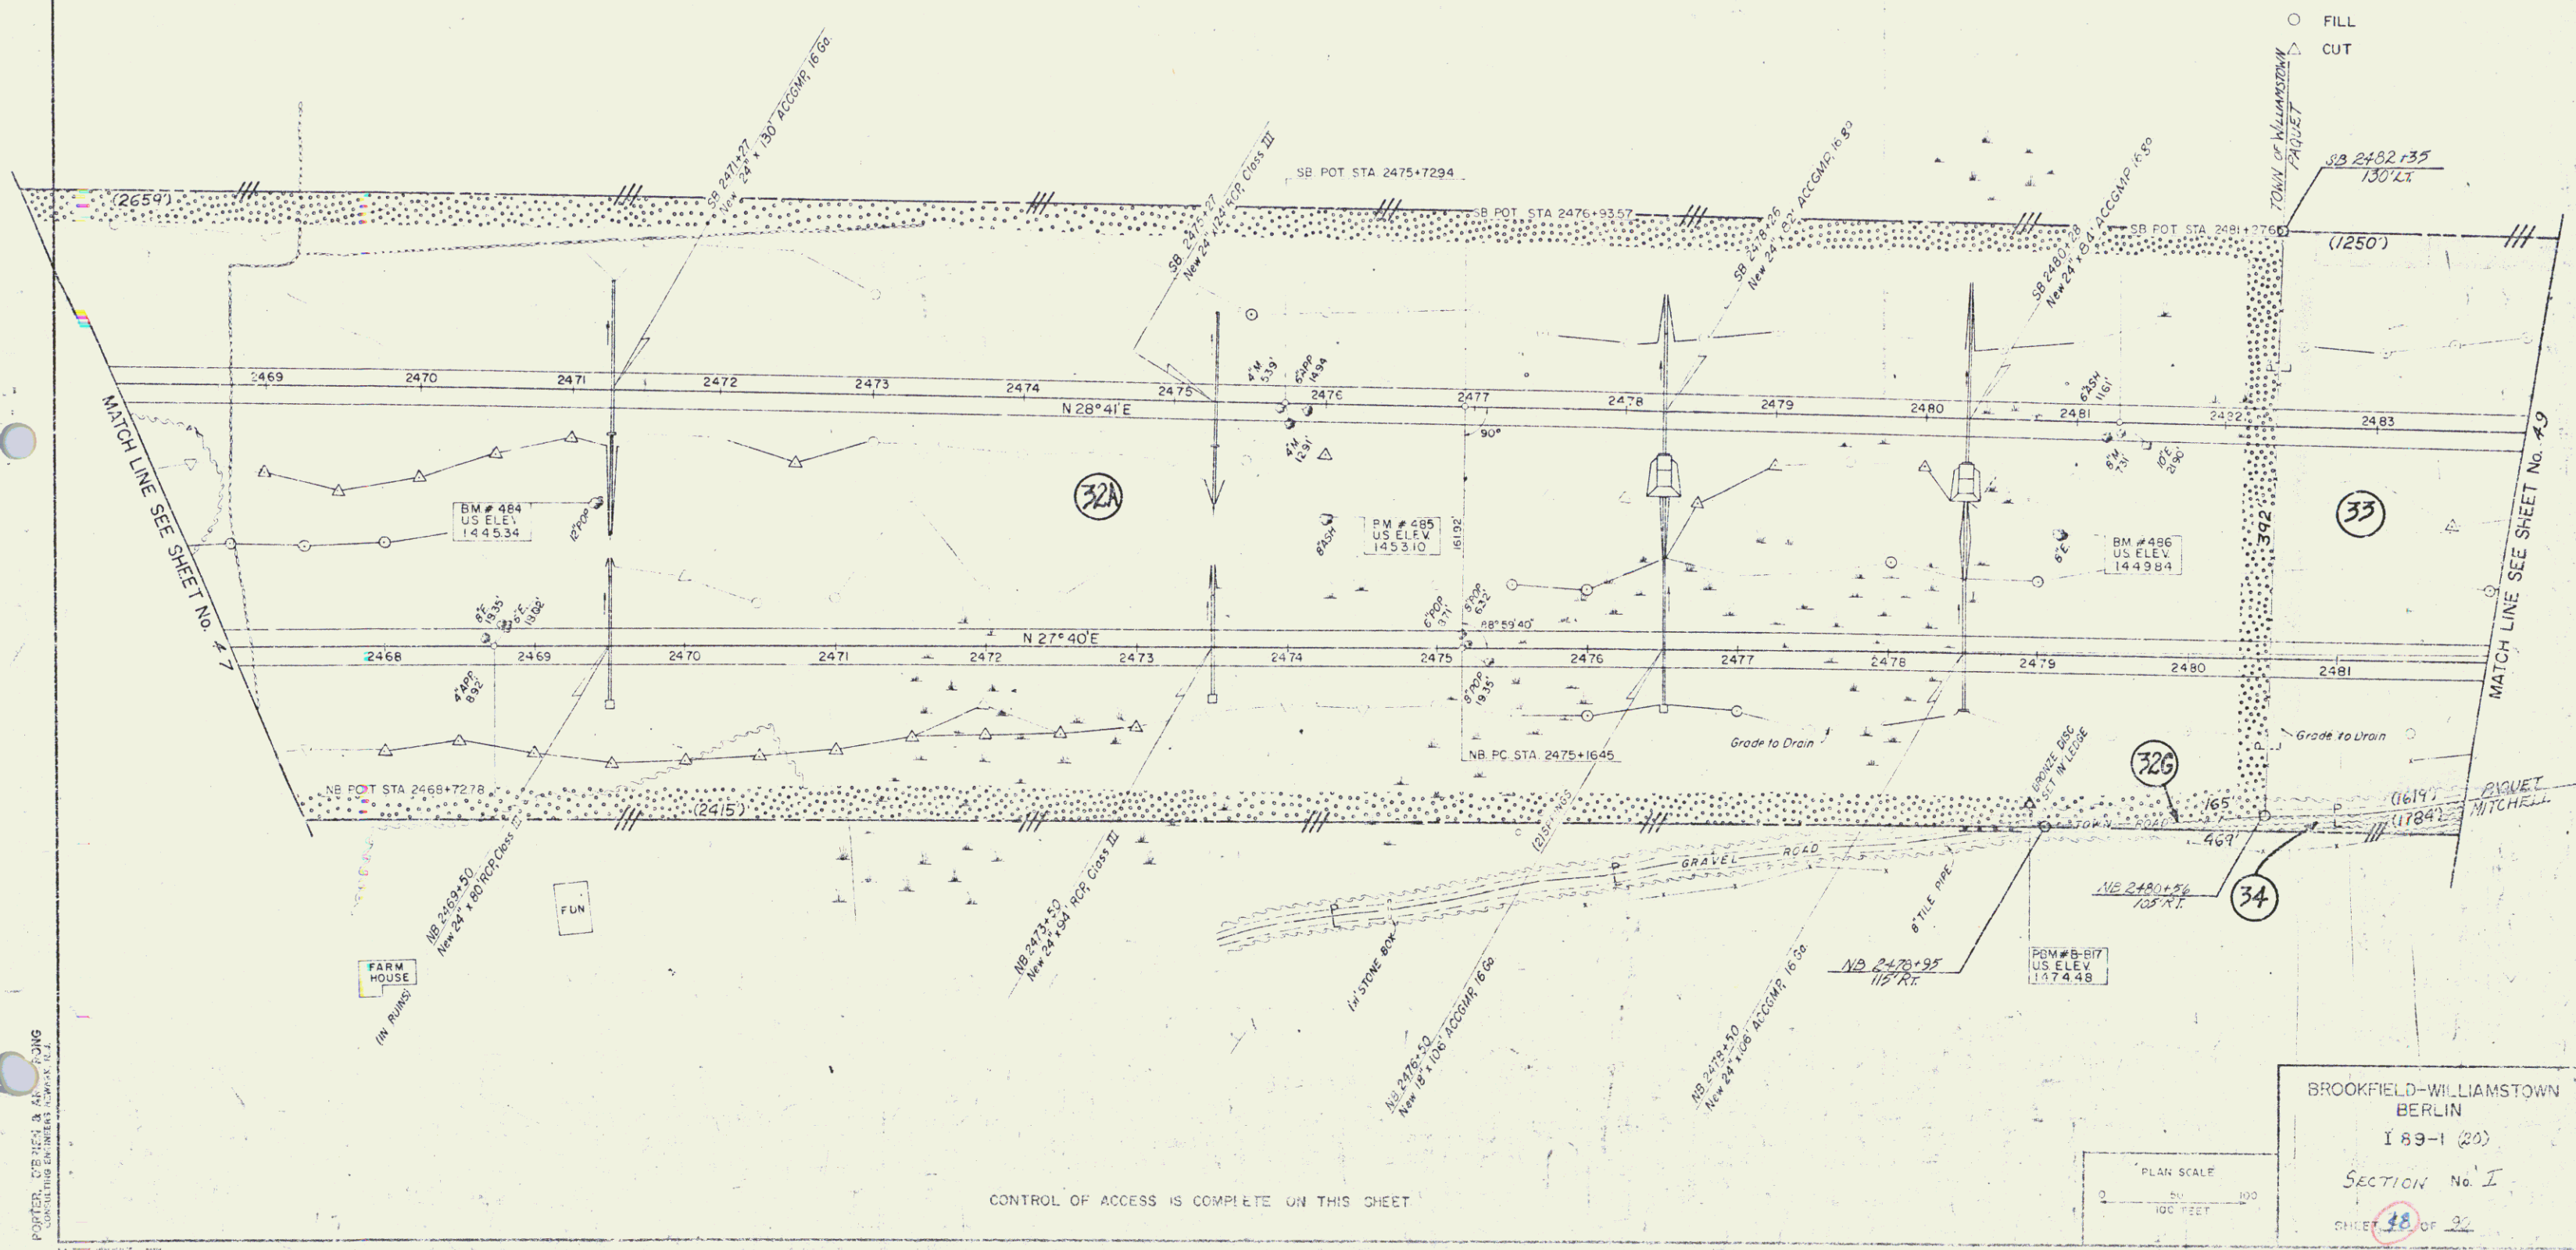

CONTROL OF ACCESS IS COMPLETE ON THIS SHEET

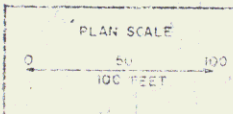

BROOKFIELD-WILLIAMSTOWN
BERLIN
189-1 (20)
SECTION No. I
SHEET 28 OF 29

PORTER, CRANE & ...
CONSULTING ENGINEERS ...