


* DENOTES STAGE 2 ITEMS

DRILLING AND BLASTING OF SOLID ROCK SUBGRADE, ITEM 115 NB 2607+25 - 2608+25

CEDAR LOG RAIL ITEM 946 NB 2611+00 - 2614+50 R.A. RI SB 2616+00 - 2619+65 R.A. LI

STA	STA	POS
2605+00	2620+00	RT
2605+00	2620+00	LT

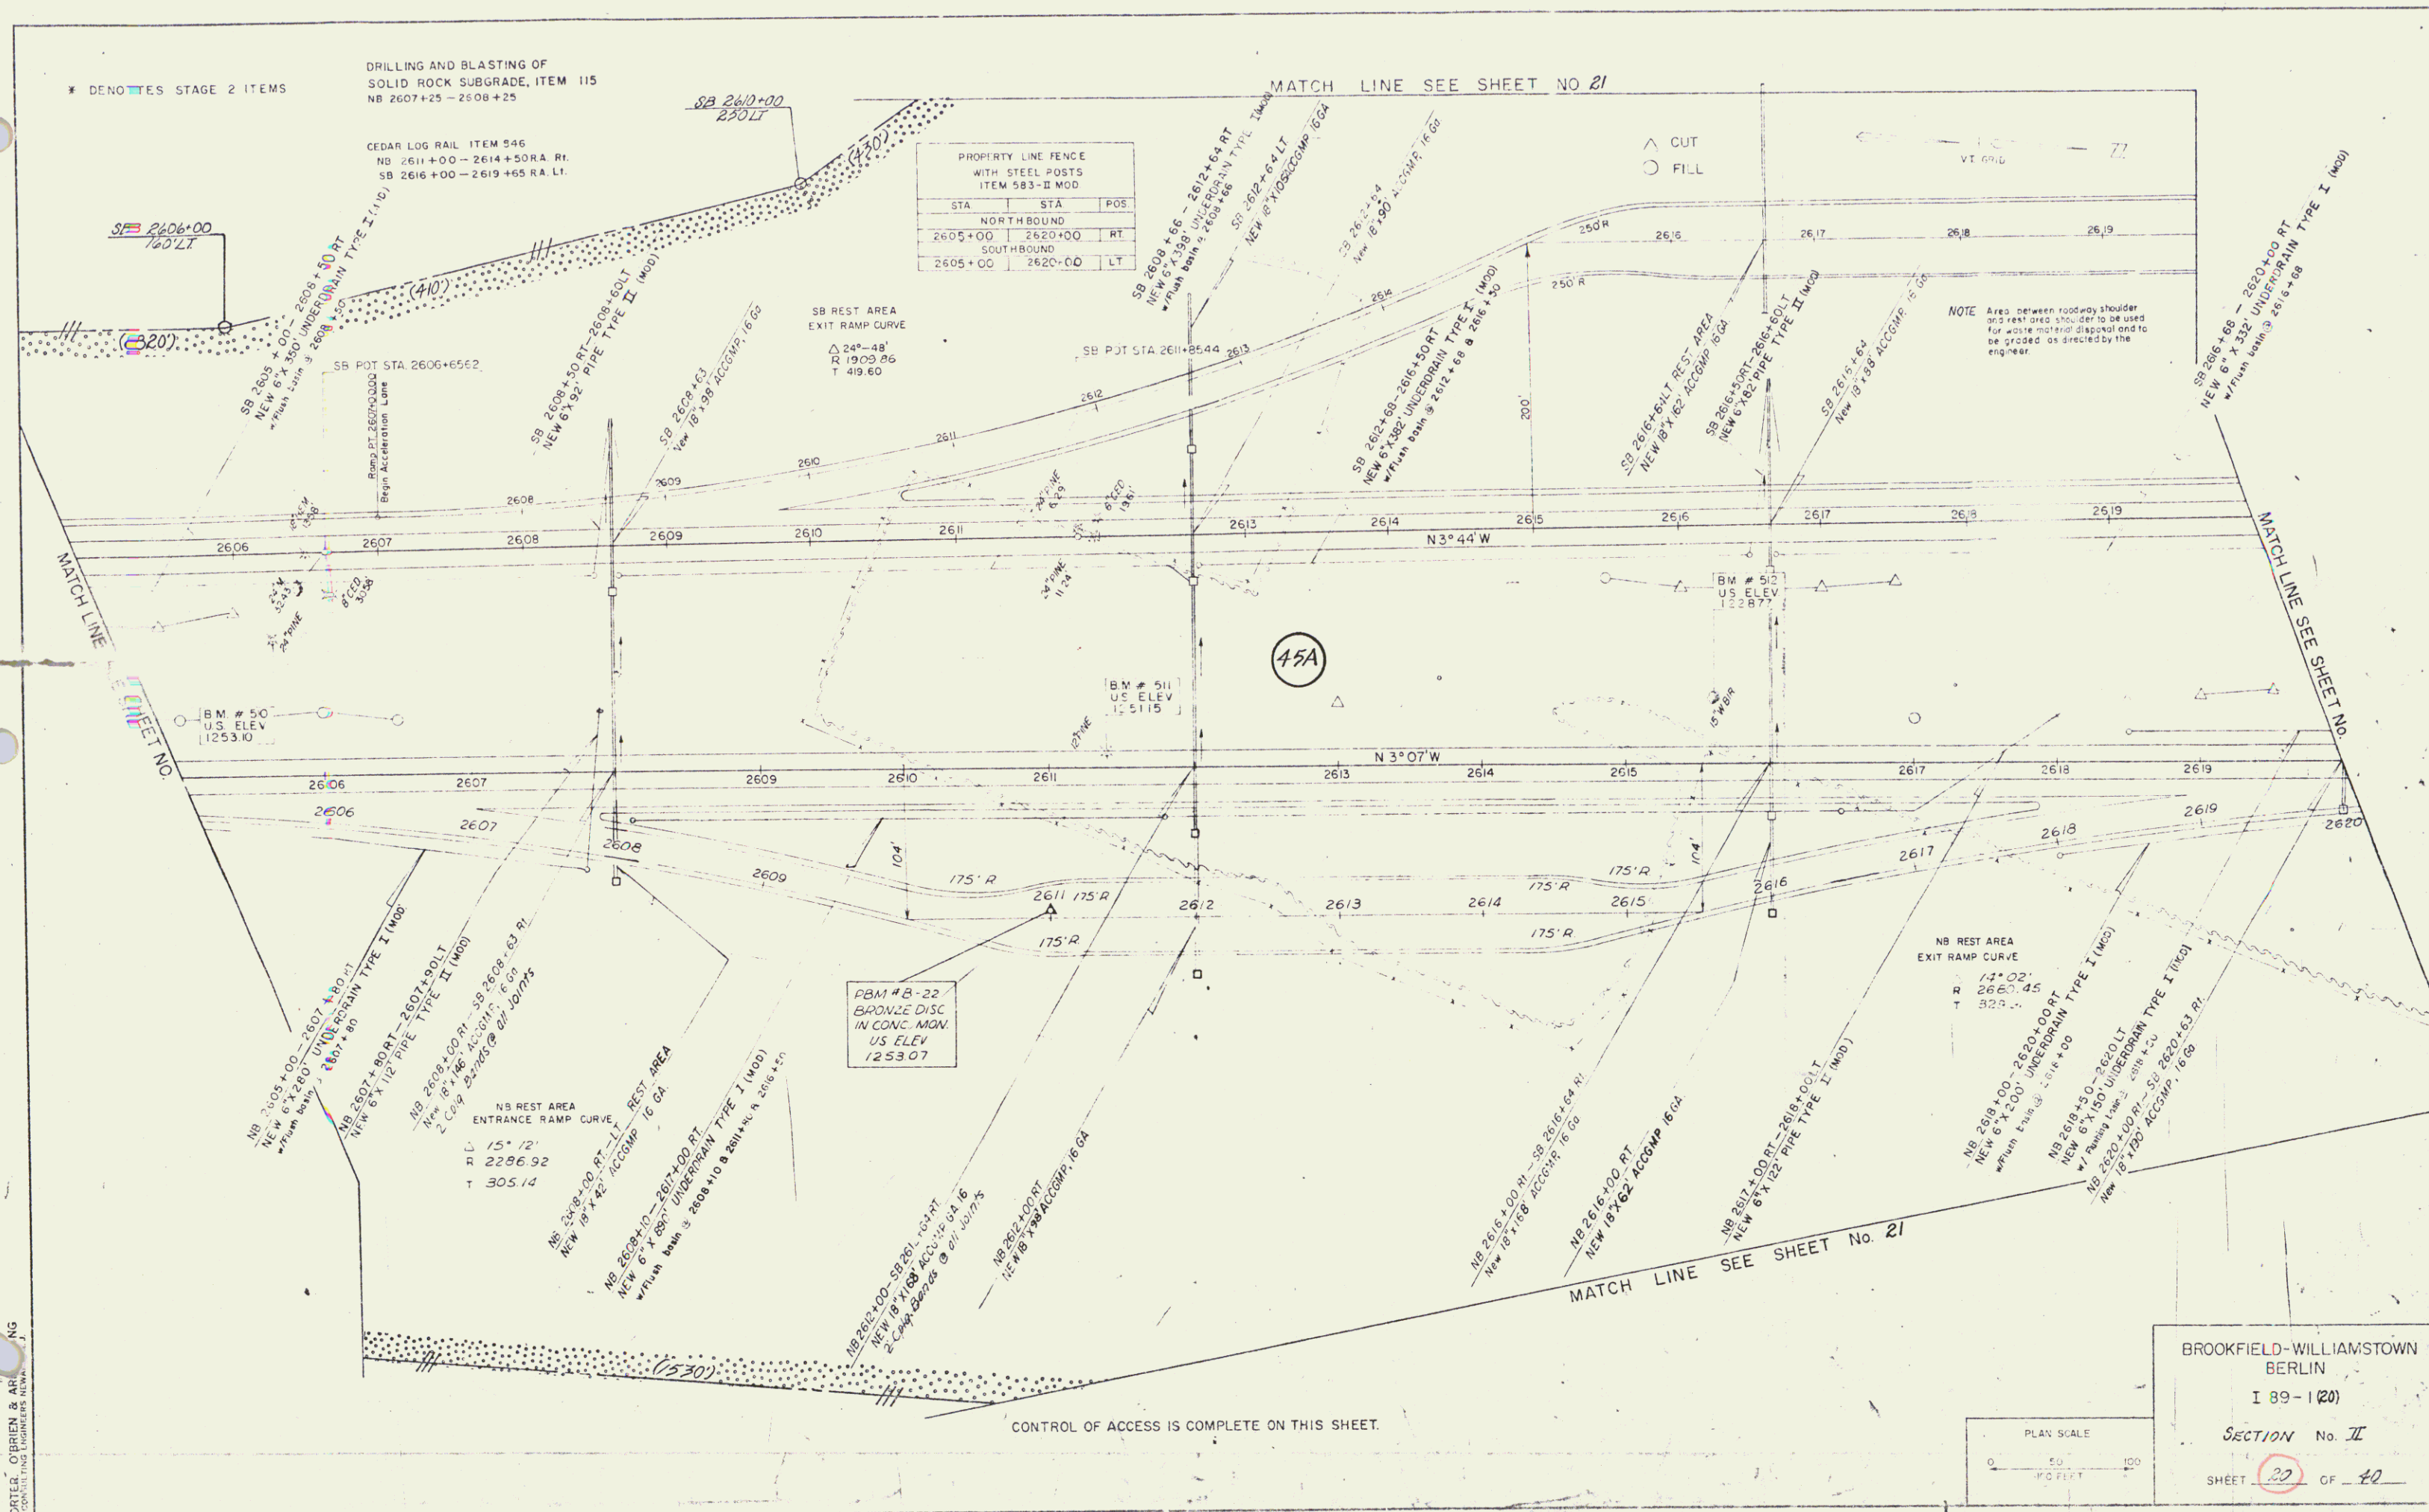

BROOKFIELD-WILLIAMSTOWN
BERLIN
I 89-1(20)
SECTION No. II
SHEET 22 OF 20

CONTROL OF ACCESS IS COMPLETE ON THIS SHEET.

PORTER, O'BRIEN & ASSOCIATES, INC.

65