


Brookfield-Williamstown-Brookfield Contract 1 89 sta 8055 ~ 299' SB

PLAN  
 DESIGNED BY: WEBSTER & MARTIN  
 CHECKED BY: M. E. REYNOLDS  
 DATE: 12/88  
 NO. 12

PROFILE  
 DESIGNED BY: WEBSTER & MARTIN  
 CHECKED BY: M. E. REYNOLDS  
 DATE: 12/88  
 NO. 12

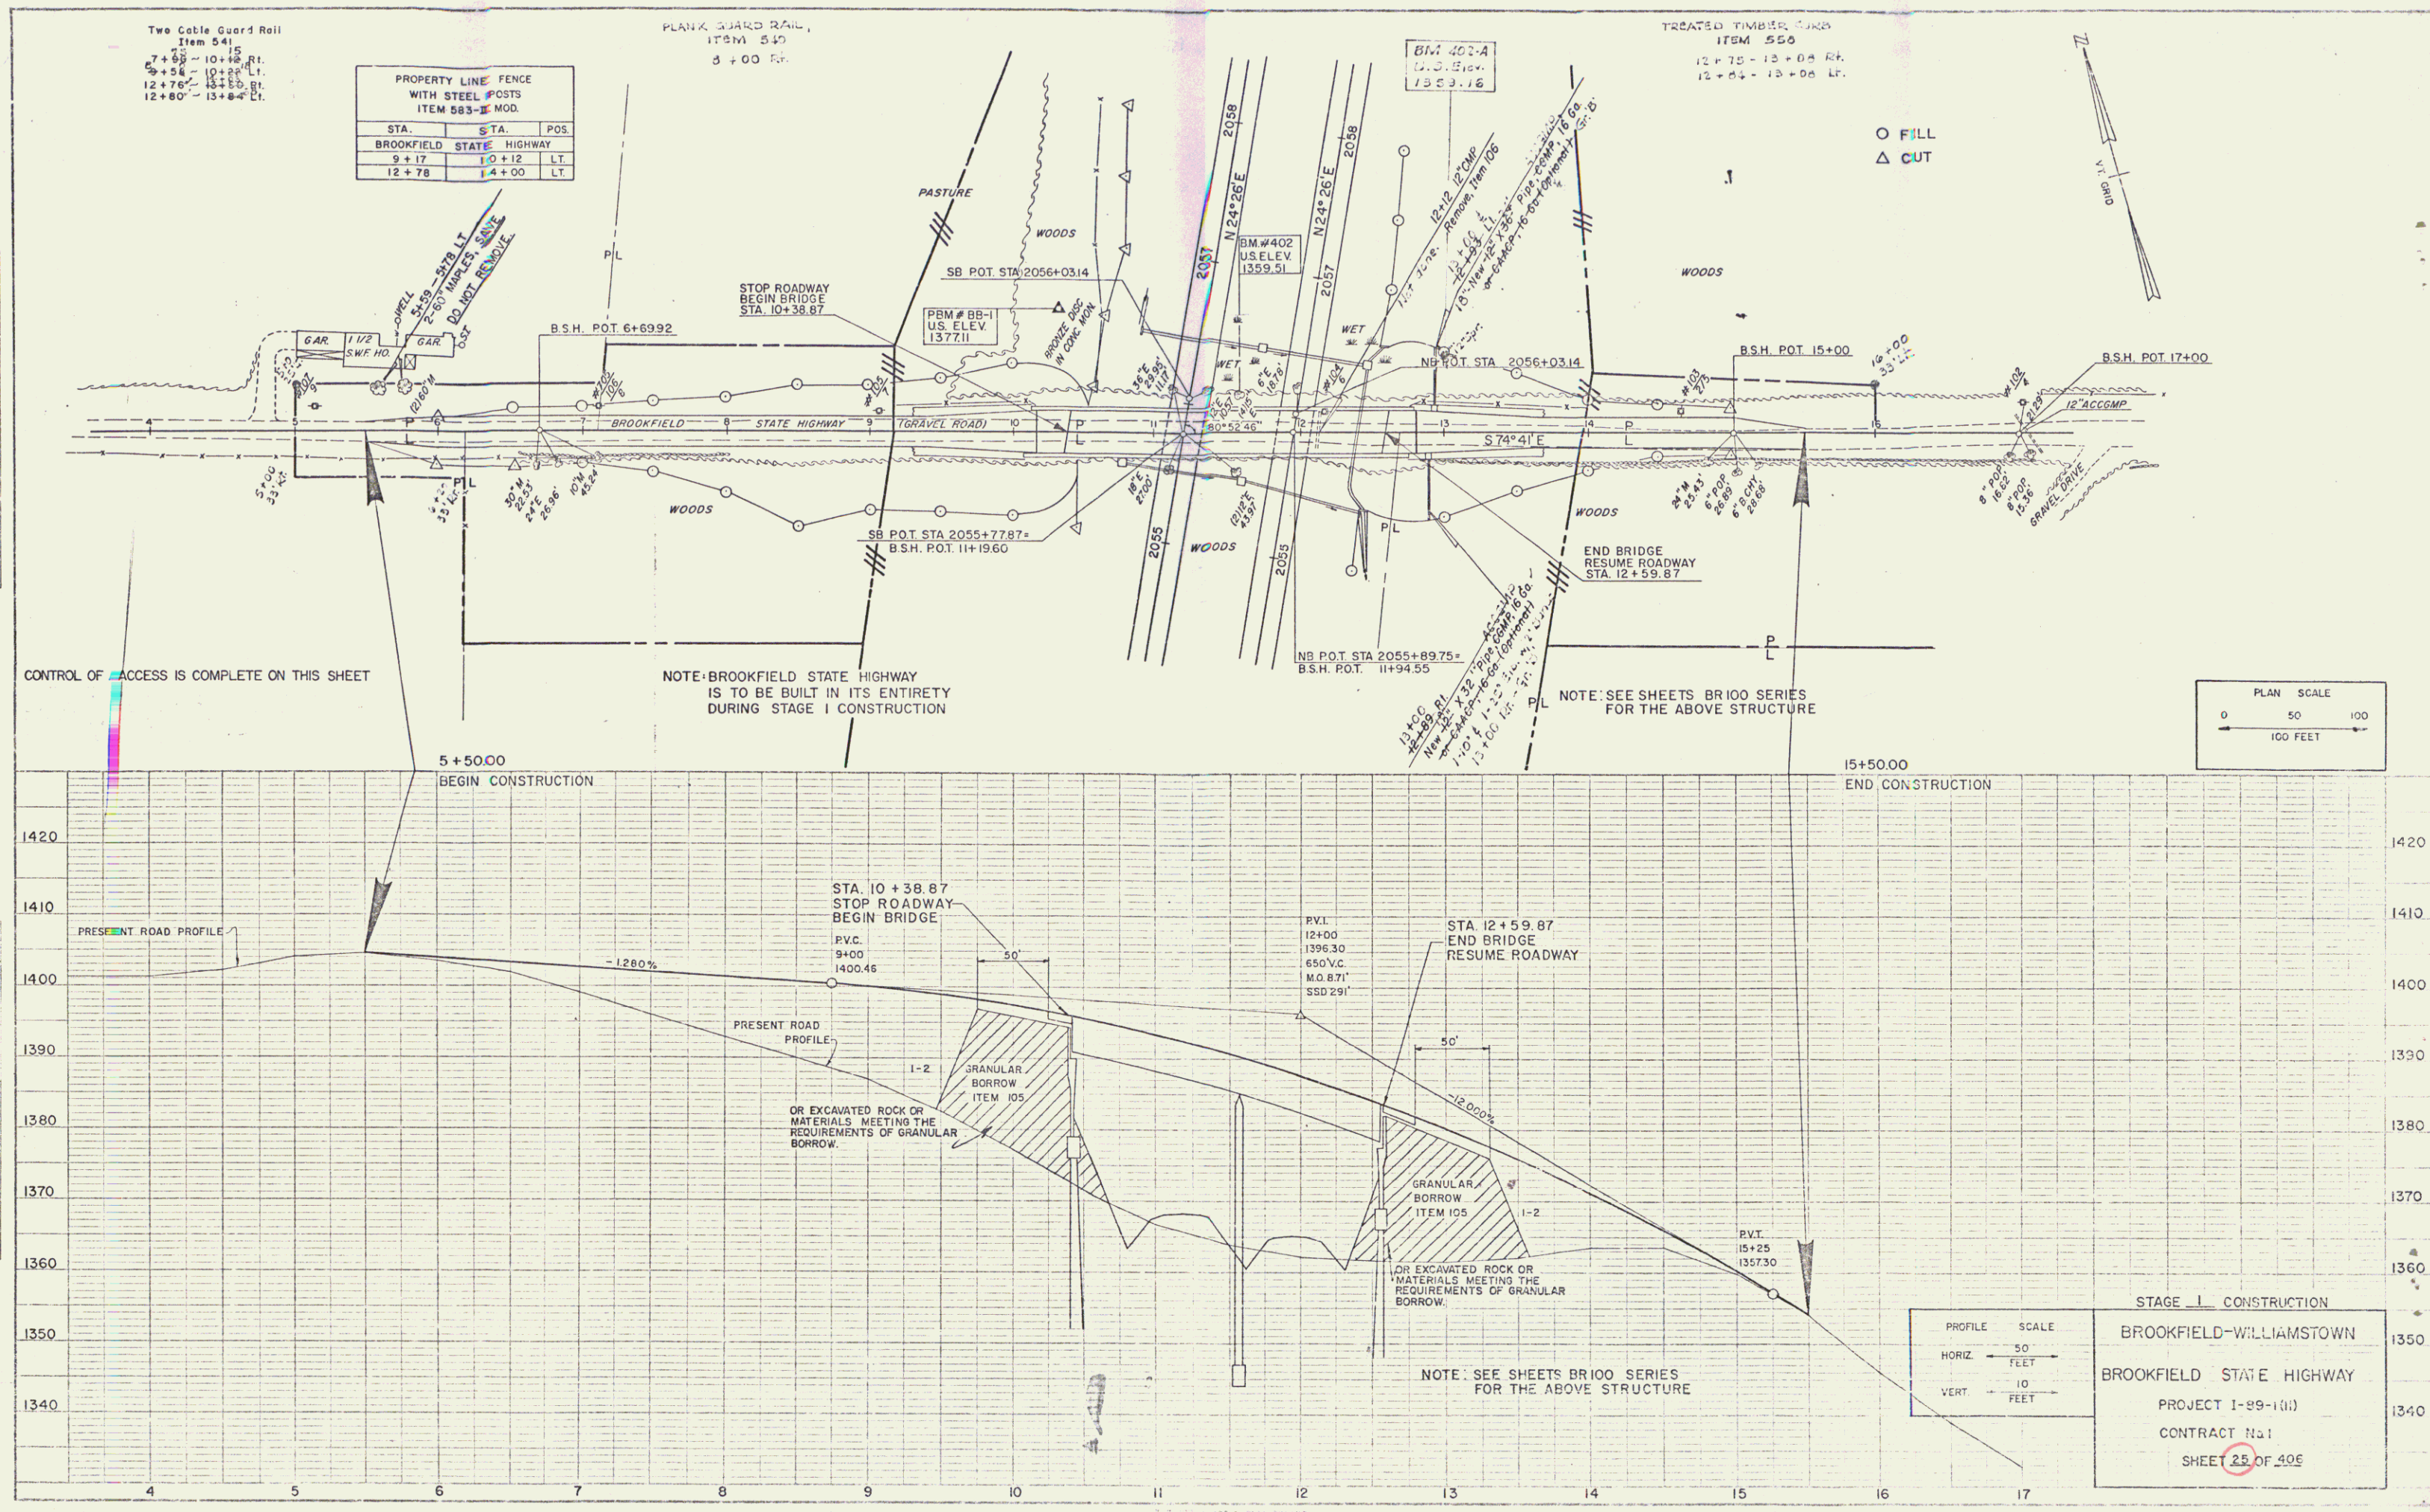

FIELD SET 72