



* DENOTES STAGE 2 ITEMS

* Jute Matting
Item 023
2070+00 - 2070+50 Median
2071+50 - 2075+00 Median
2076+00 - 2079+50 Median

PROPERTY LINE FENCE WITH STEEL POSTS ITEM 593-1 MOD.		
STA.	STA.	POS.
NORTHBOUND		
2070+00	2085+00	RT.
SOUTHBOUND		
2070+00	2085+00	LT.

Drilling & Blasting of Solid Rock Subgrade, Item 115

SB 2076+90 - 2077+25
SB 2078+50 - 2084+00
SB 2081+58 - 2085+00
NB 2079+25 - 2084+25

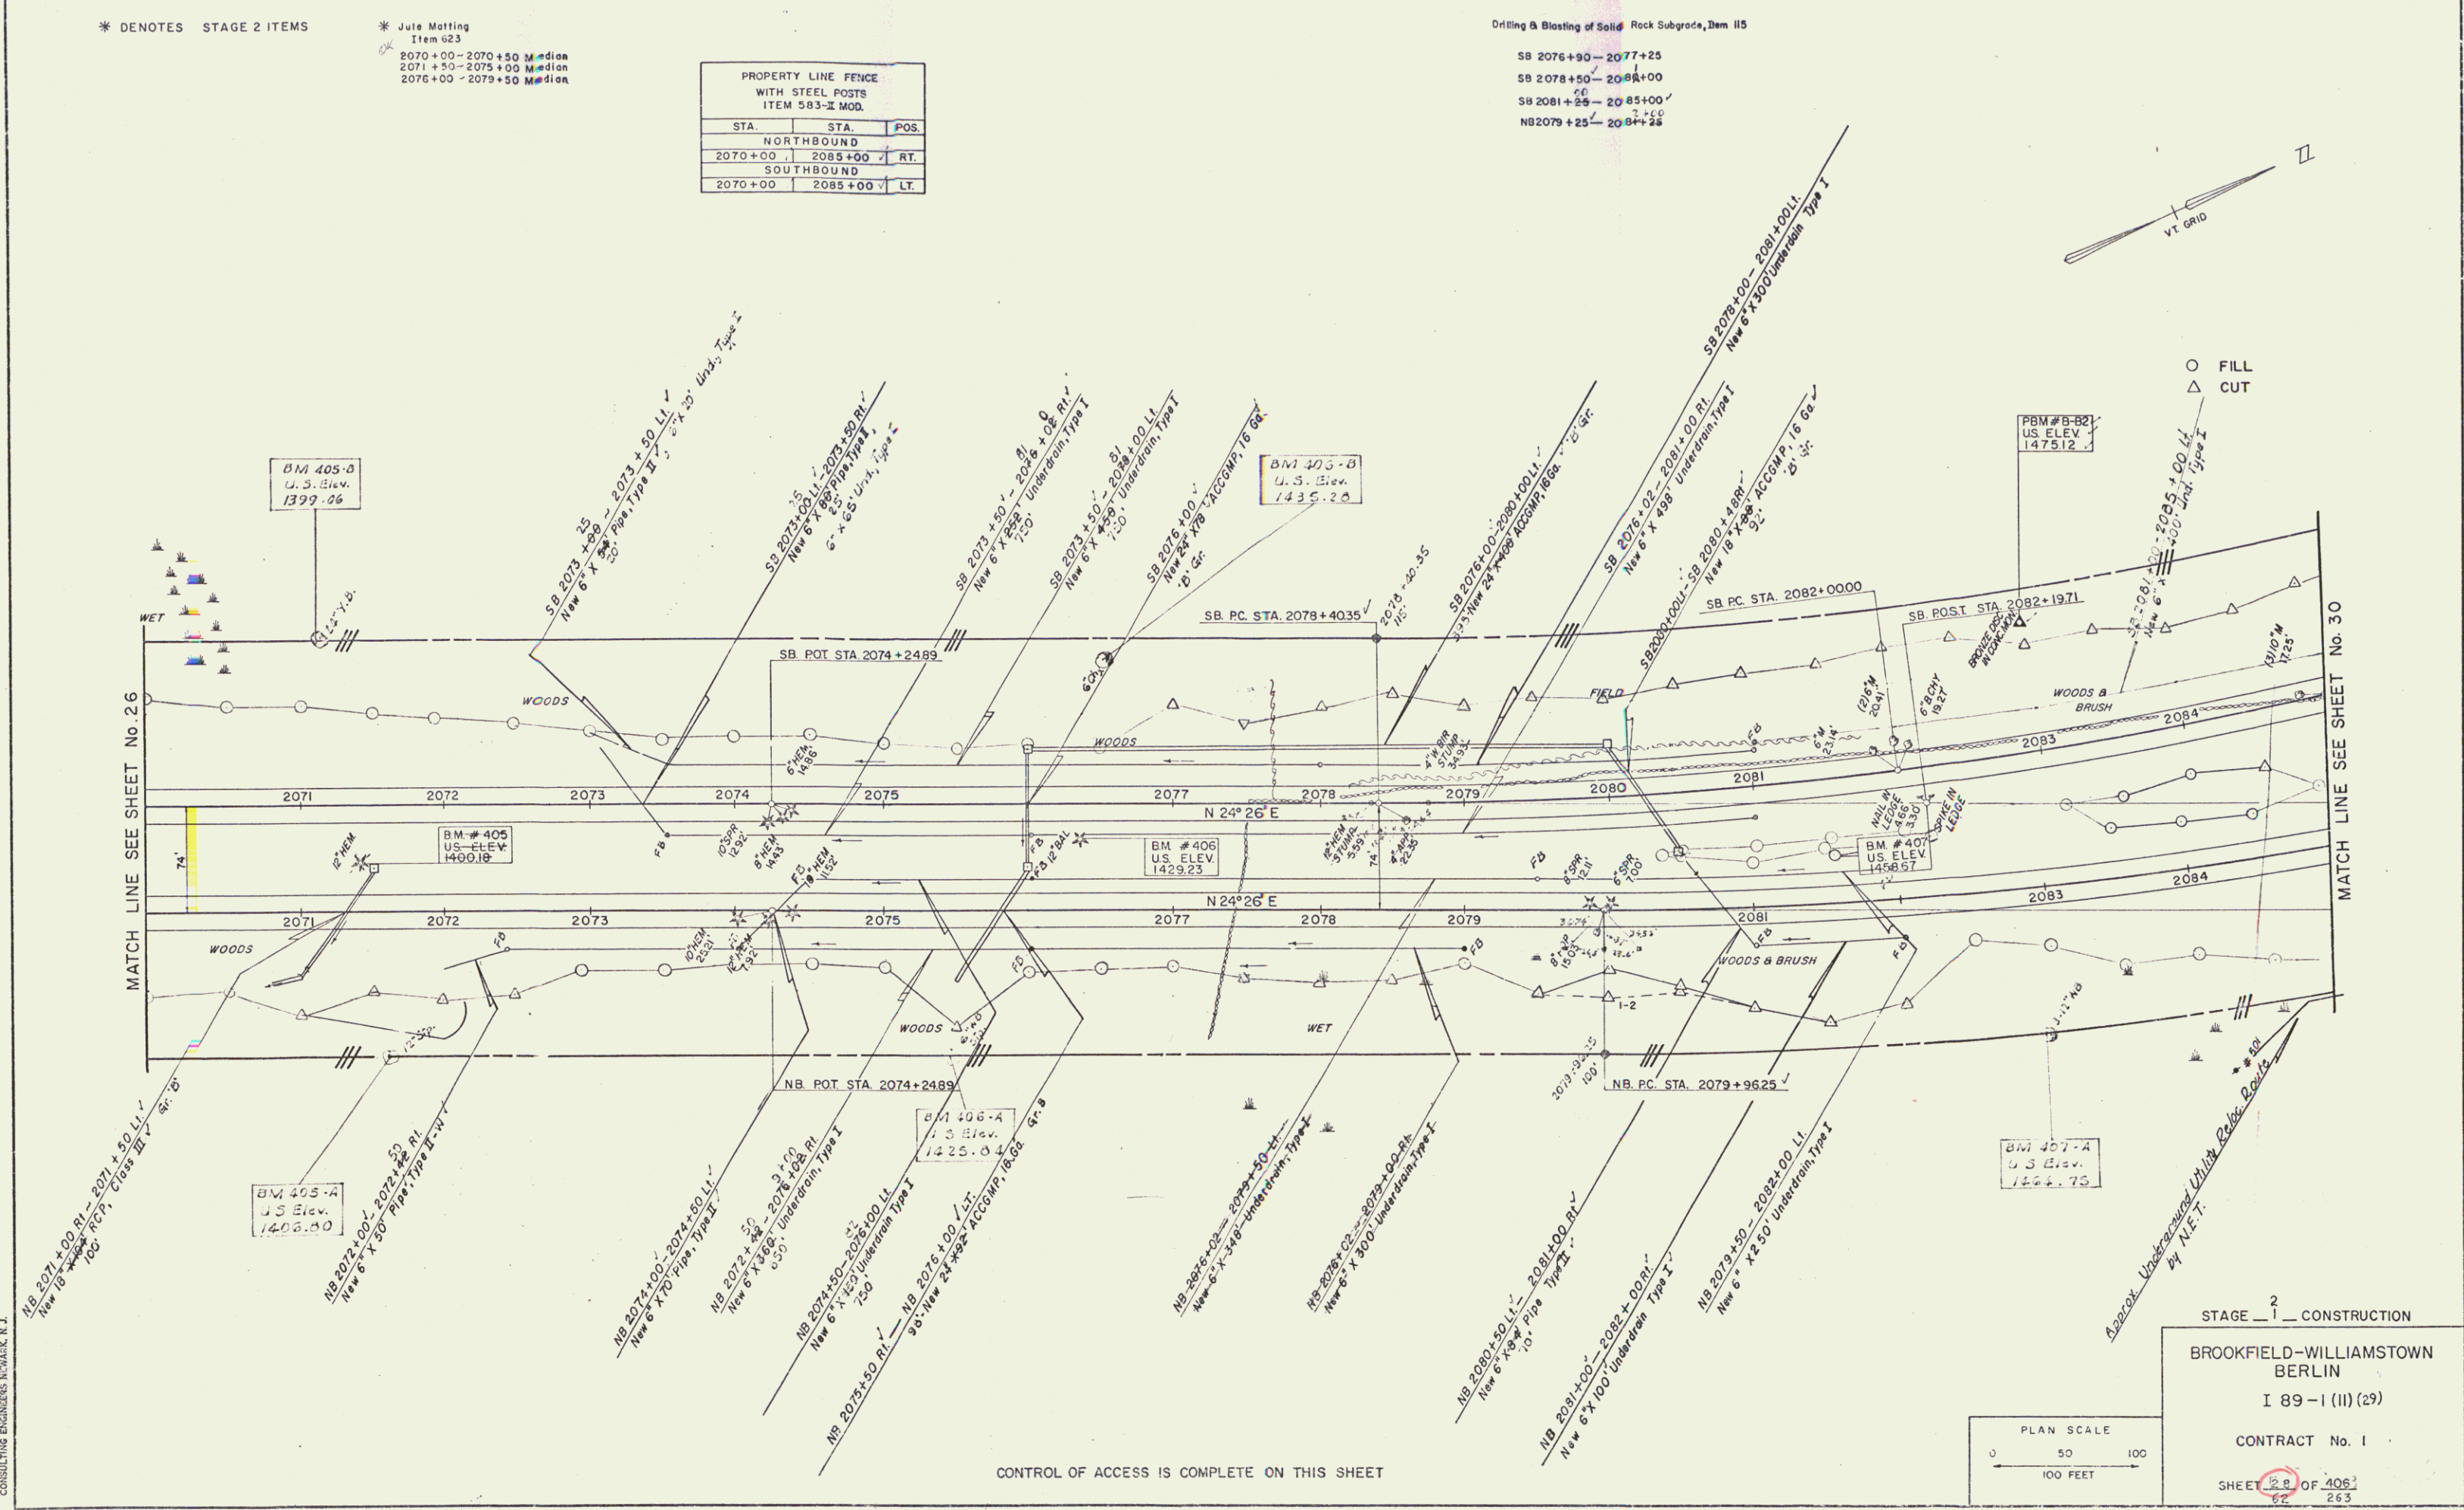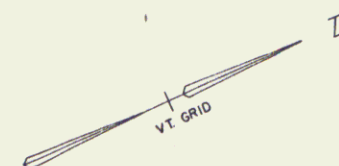


MATCH LINE SEE SHEET No. 26

MATCH LINE SEE SHEET No. 30

POSTER, O'BRIEN & ARMSTRONG
CONSULTING ENGINEERS NEWARK, N.J.

CONTROL OF ACCESS IS COMPLETE ON THIS SHEET

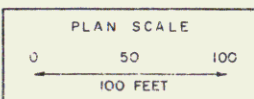

STAGE 2 CONSTRUCTION

BROOKFIELD-WILLIAMSTOWN
BERLIN

I 89-1 (II) (29)

CONTRACT No. 1

SHEET 28 OF 405
263

74