



75

POSTER, GRUEN & ARMSTRONG
CONSULTING ENGINEERS NEWARK, N.J.

STAGE 2 CONSTRUCTION
BROOKFIELD-WILLIAMSTOWN
BERLIN
I 89-1 (11)(29)
CONTRACT No. 1
SHEET 30 OF 306
263

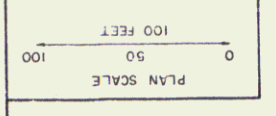

CONTROL OF ACCESS IS COMPLETE ON THIS SHEET

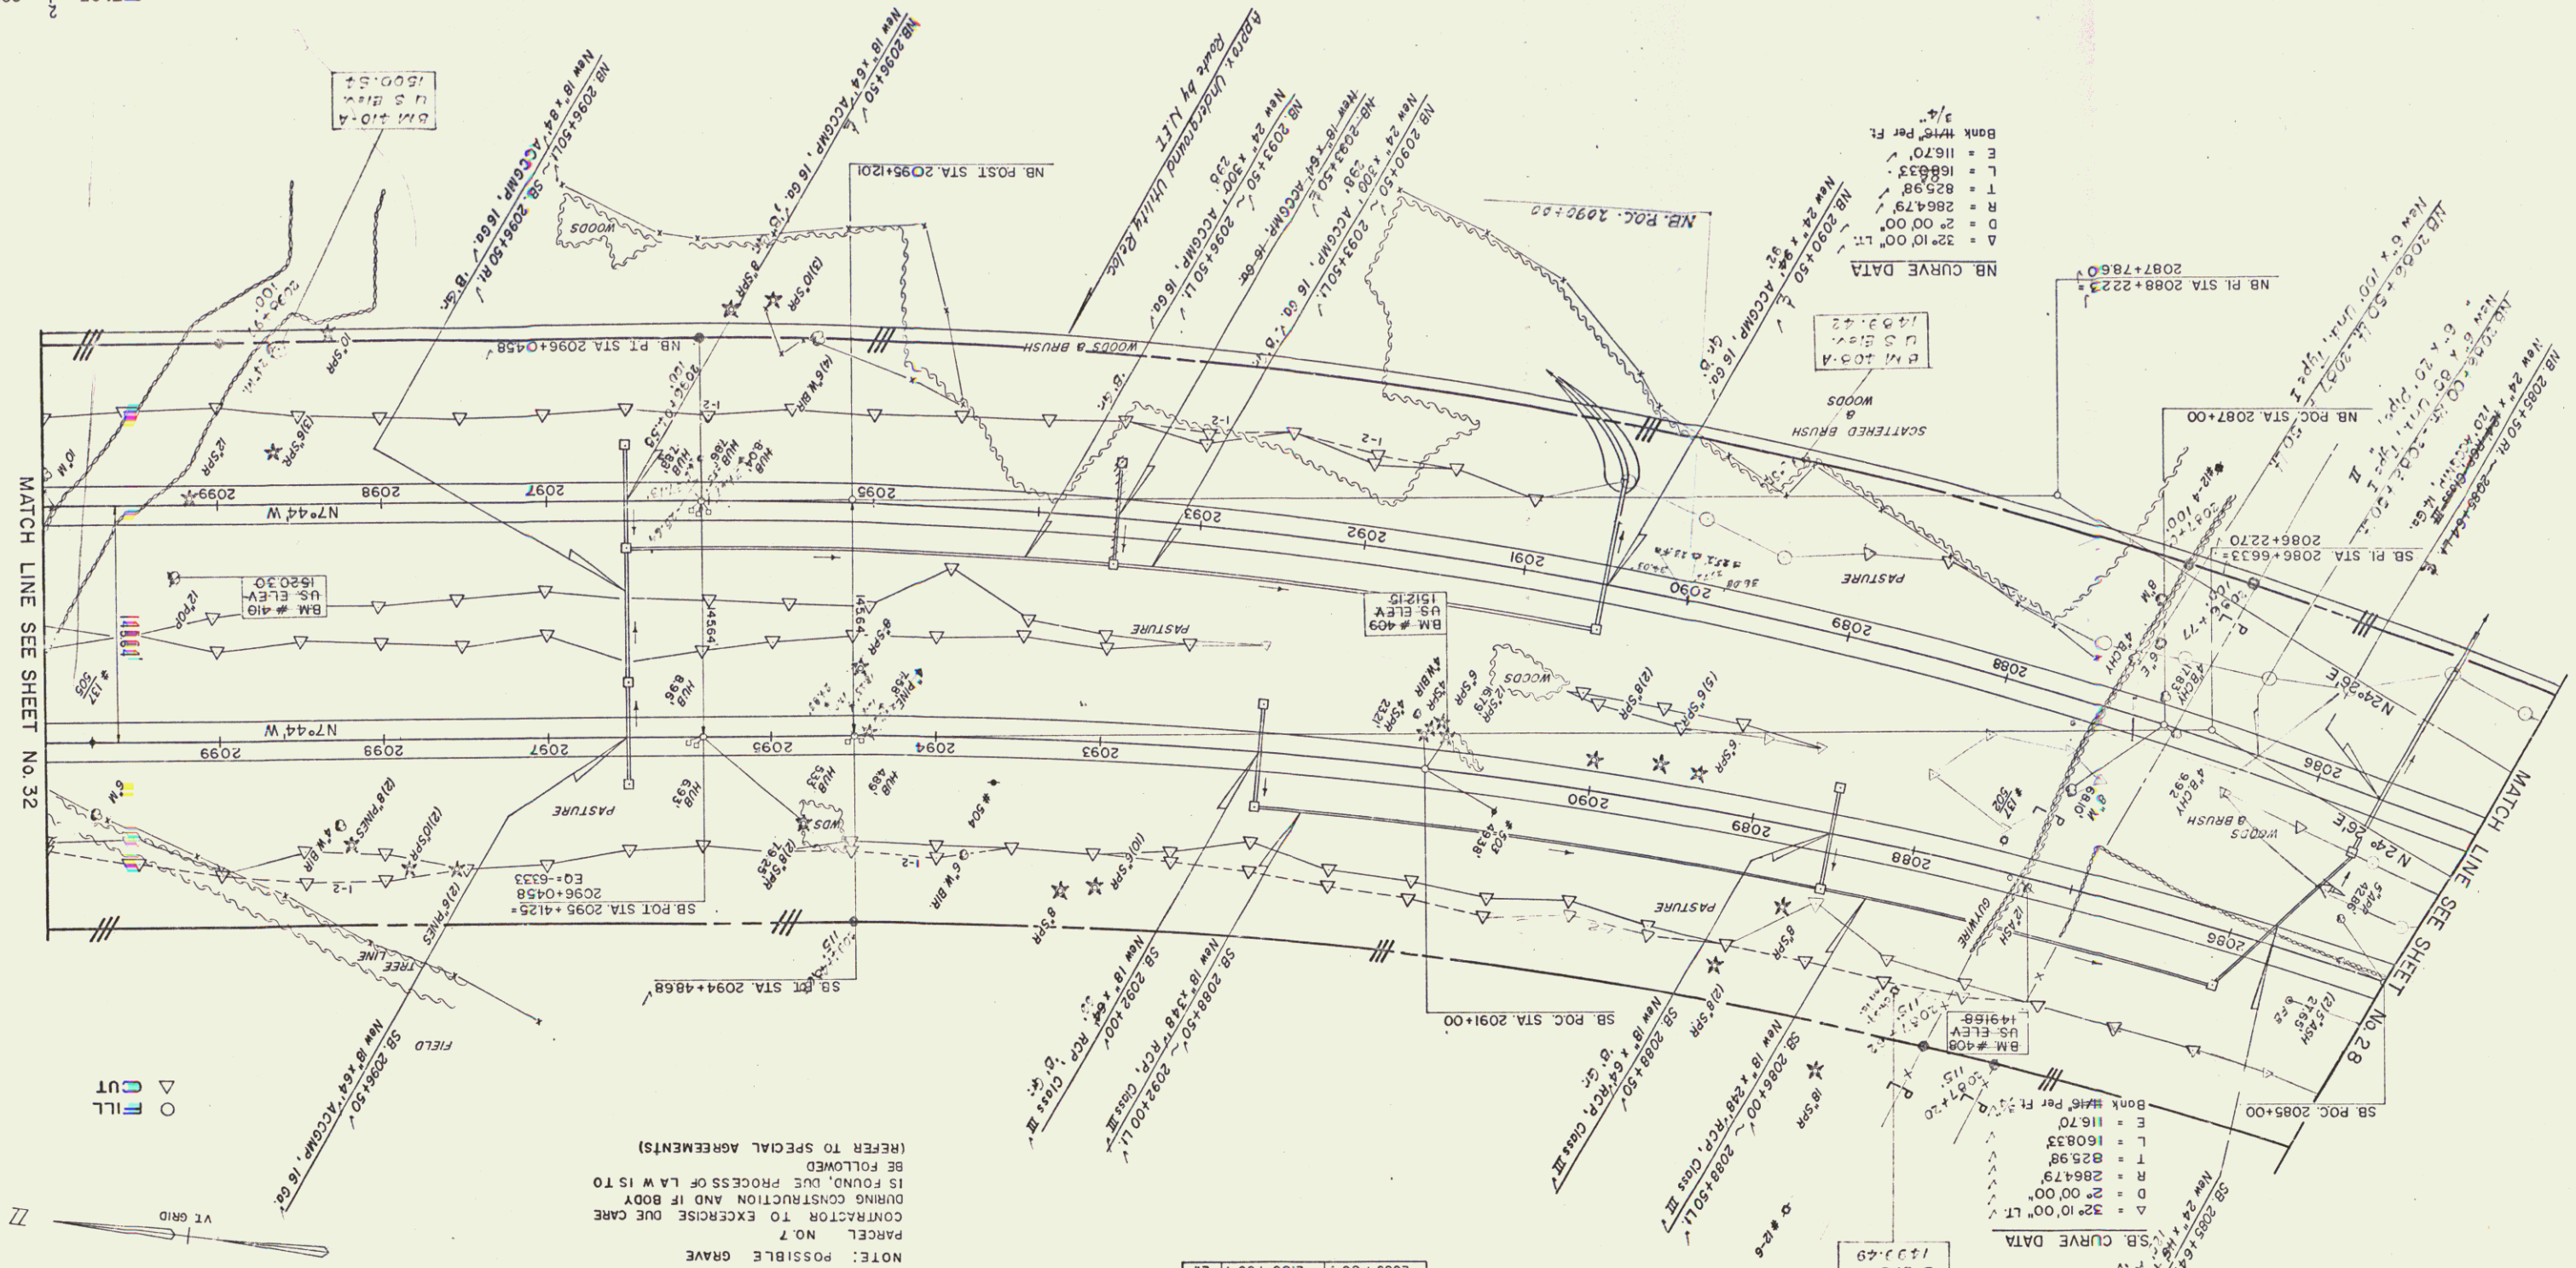

MATCH LINE SEE SHEET No. 32

MATCH LINE SEE SHEET No. 28

VT GRID
N
E
S
W
CUT
FILL

PROPERTY LINE FENCE W/STEEL POSTS
ITEM 853-II MOD.
S.B. 2087+65 - 2100+00 LT.
N.B. 2087+16 - 2100+00 RT.
(RECT FENCE PRIOR TO COMMENCEMENT)

NOTE: POSSIBLE GRAVE
PARCEL NO. 7
CONTRACTOR TO EXERCISE DUE CARE
DURING CONSTRUCTION AND IF BODY
IS FOUND, DUE PROCESS OF LAW IS TO
BE FOLLOWED
(REFER TO SPECIAL AGREEMENTS)

| POS. | STA. | NORTHBOUND | SOUTHBOUND |
|------|---------|------------|------------|
| | 2085+00 | 2100+00 | LT. |
| | 2085+00 | 2100+00 | RT. |

NB CURVE DATA
A = 32°10'00" LT.
D = 2°00'00"
R = 2864.79'
T = 825.98'
L = 1608.33'
E = 116.70'
Bank W/Per Ft. 3/4"

SB CURVE DATA
A = 32°10'00" LT.
D = 2°00'00"
R = 2864.79'
T = 825.98'
L = 1608.33'
E = 116.70'
Bank W/Per Ft. 3/4"

Drilling a Blast of Soft Rock Subgrade Item 853
SB 2085+00 - 2100+00
NB 2086+58 - 2100+00