

* DENOTES STAGE 2 ITEMS

Stone Fill For Slope Protection (Light Type) Item 512
 NB 211+50 LI - SB 2111+60 RI

* Three Cable Guard Rail w/ Light Steel Posts Item 538
 SB 2112+20-2114+00 RI
 SB 2113+75-2114+00 RI
 NB 210+40-2107+99 RI
 NB 209+90-214+00 RI

* Bituminous Concrete Surface For Gutters & Traffic Islands Item 554 MOD.
 NB 2106+30-2106+50 RI
 NB 2107+35-2107+95 LI

STA.	STA.	POS.
NORTHBOUND		
2100+00	2107+99	RT.
SOUTHBOUND		
2100+00	2108+85	LT.
2110+70	LT. Reloc SA-1 29+00	RT.
NBLI 2108+15 - 2108+85 SB RT.		
NBLI 2109+35 - 2110+17 SB RT.		


PROPERTY LINE FENCE WITH STEEL POSTS ITEM 583-2 MOD.
 SB 2100+00 - 1+59 RT. T-65
 NB 2100+00 - 2106+4 RT.
 (ERECT FENCE PRIOR TO COMMENCEMENT OF OTHER WORK IN THIS AREA)

NOTE: POSSIBLE GRAVE!
 PARCEL NO. 7
 CONTRACTOR TO EXERCISE DUE CARE DURING CONSTRUCTION AND IF BODY IS FOUND DUE PROCESS OF LAW IS TO BE FOLLOWED (REFER TO SPECIAL AGREEMENTS)

* Treated Timber Curb Item 558
 NB 2106+50-2107+70 RI
 NB 2107+95-2108+05 RI
 SB 2108+42-2108+55 RI
 SB 2108+75-2108+85 LI

NOTE: SPUR T-65
 20+00 - 21+50 LT. & RT.
 SAVE AS MANY TREES AS POSSIBLE (REFER TO SPECIAL AGREEMENT)


○ FILL
 △ CUT

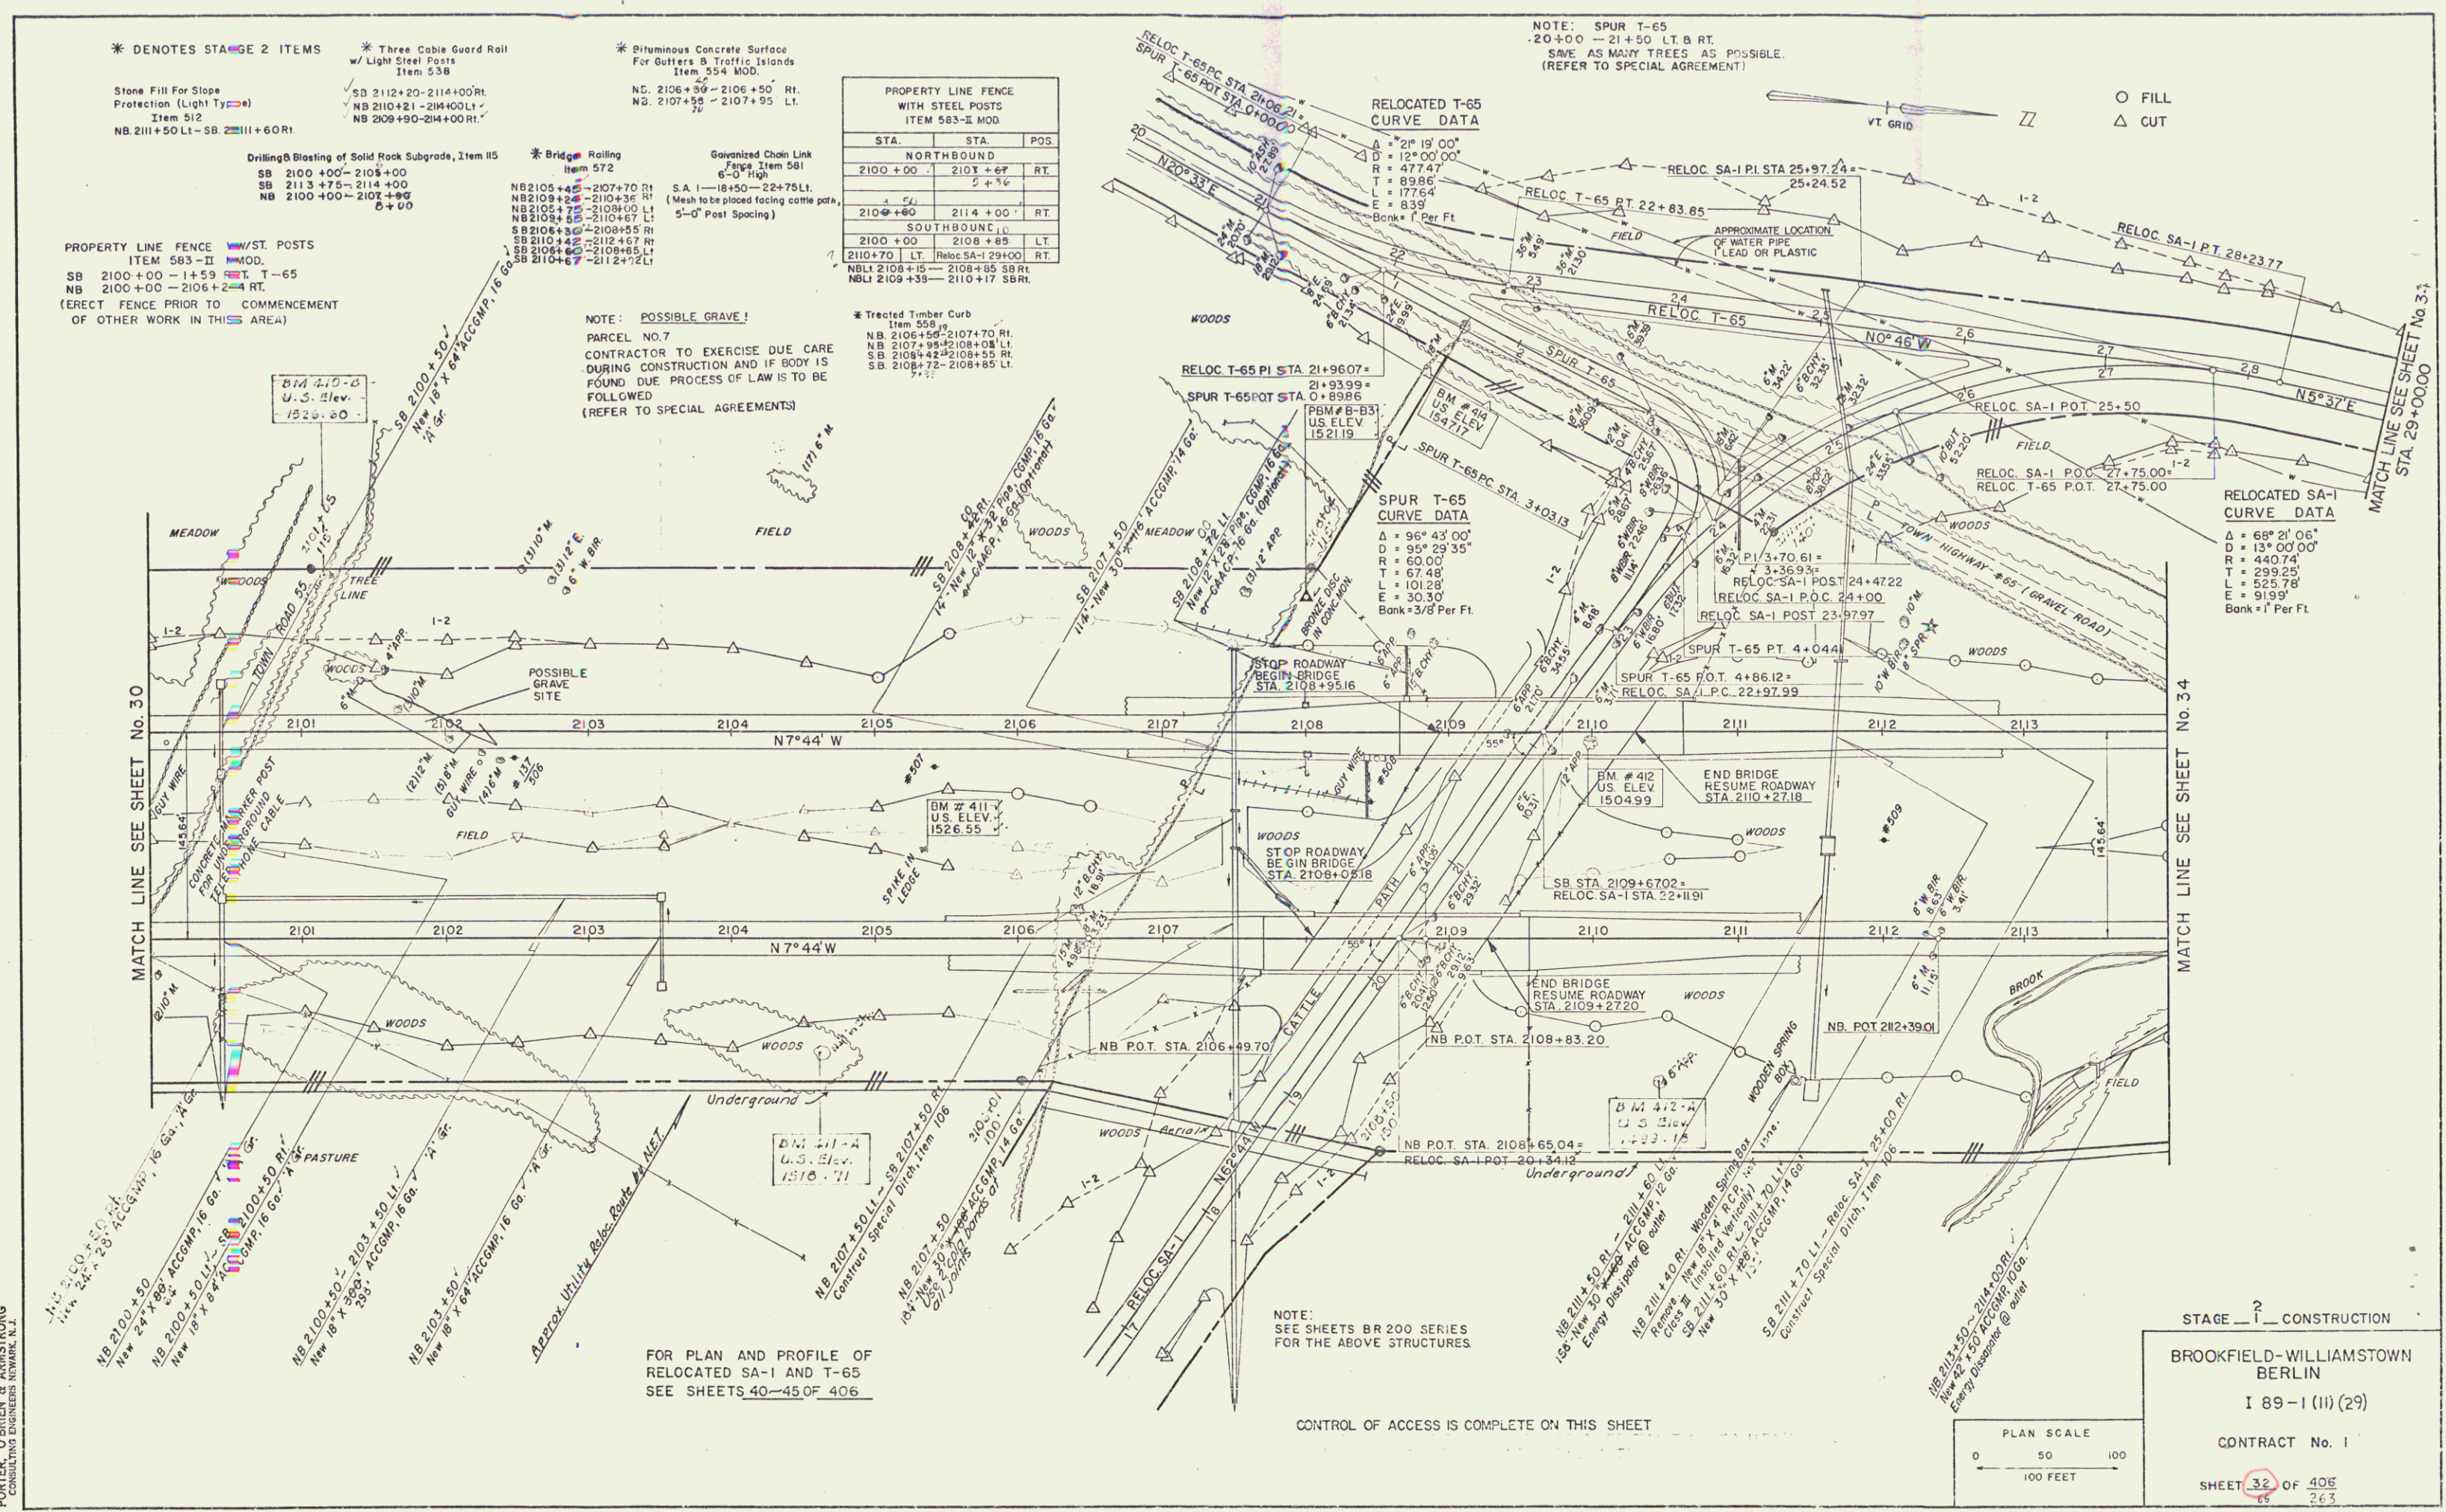

PORTER, O'BRIEN & ARMSTRONG
 CONSULTING ENGINEERS
 BURLINGTON, VT.

FOR PLAN AND PROFILE OF RELOCATED SA-1 AND T-65 SEE SHEETS 40-45 OF 406

CONTROL OF ACCESS IS COMPLETE ON THIS SHEET

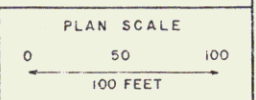

STAGE 2 CONSTRUCTION
 BROOKFIELD-WILLIAMSTOWN
 BERLIN
 I 89-1 (11) (29)
 CONTRACT No. 1
 SHEET 32 OF 406
 26.5

76