


• DENOTES STAGE 2 ITEMS

Three Cable Guard Rail  
w/ 11 St. Posts  
Item 538  
NB 2140+00 - 2142+00 RT.  
NB 2139+00 - 2142+00 LT.  
SB 2140+00 - 2142+00 RT.  
SB 2139+00 - 2142+00 LT.


PROPERTY LINE FENCE WITH STEEL POSTS ITEM 583-3 MOD.		
STA.	STA.	POS.
NORTHBOUND		
2128+00	2142+00	RT.
SOUTHBOUND		
2128+00	2142+00	LT.

Construct U-Turn Median Opening  
NB 2138+50 - 12' LT.  
SB 2138+50 - 12' RT.

Drilling & Blasting of Solid Rock Subgrade, Item 115  
SB 2128+00 - 2137+65  
NB 2123+00 - 2136+55

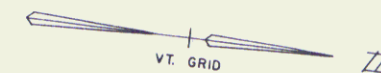

○ FILL  
△ CUT

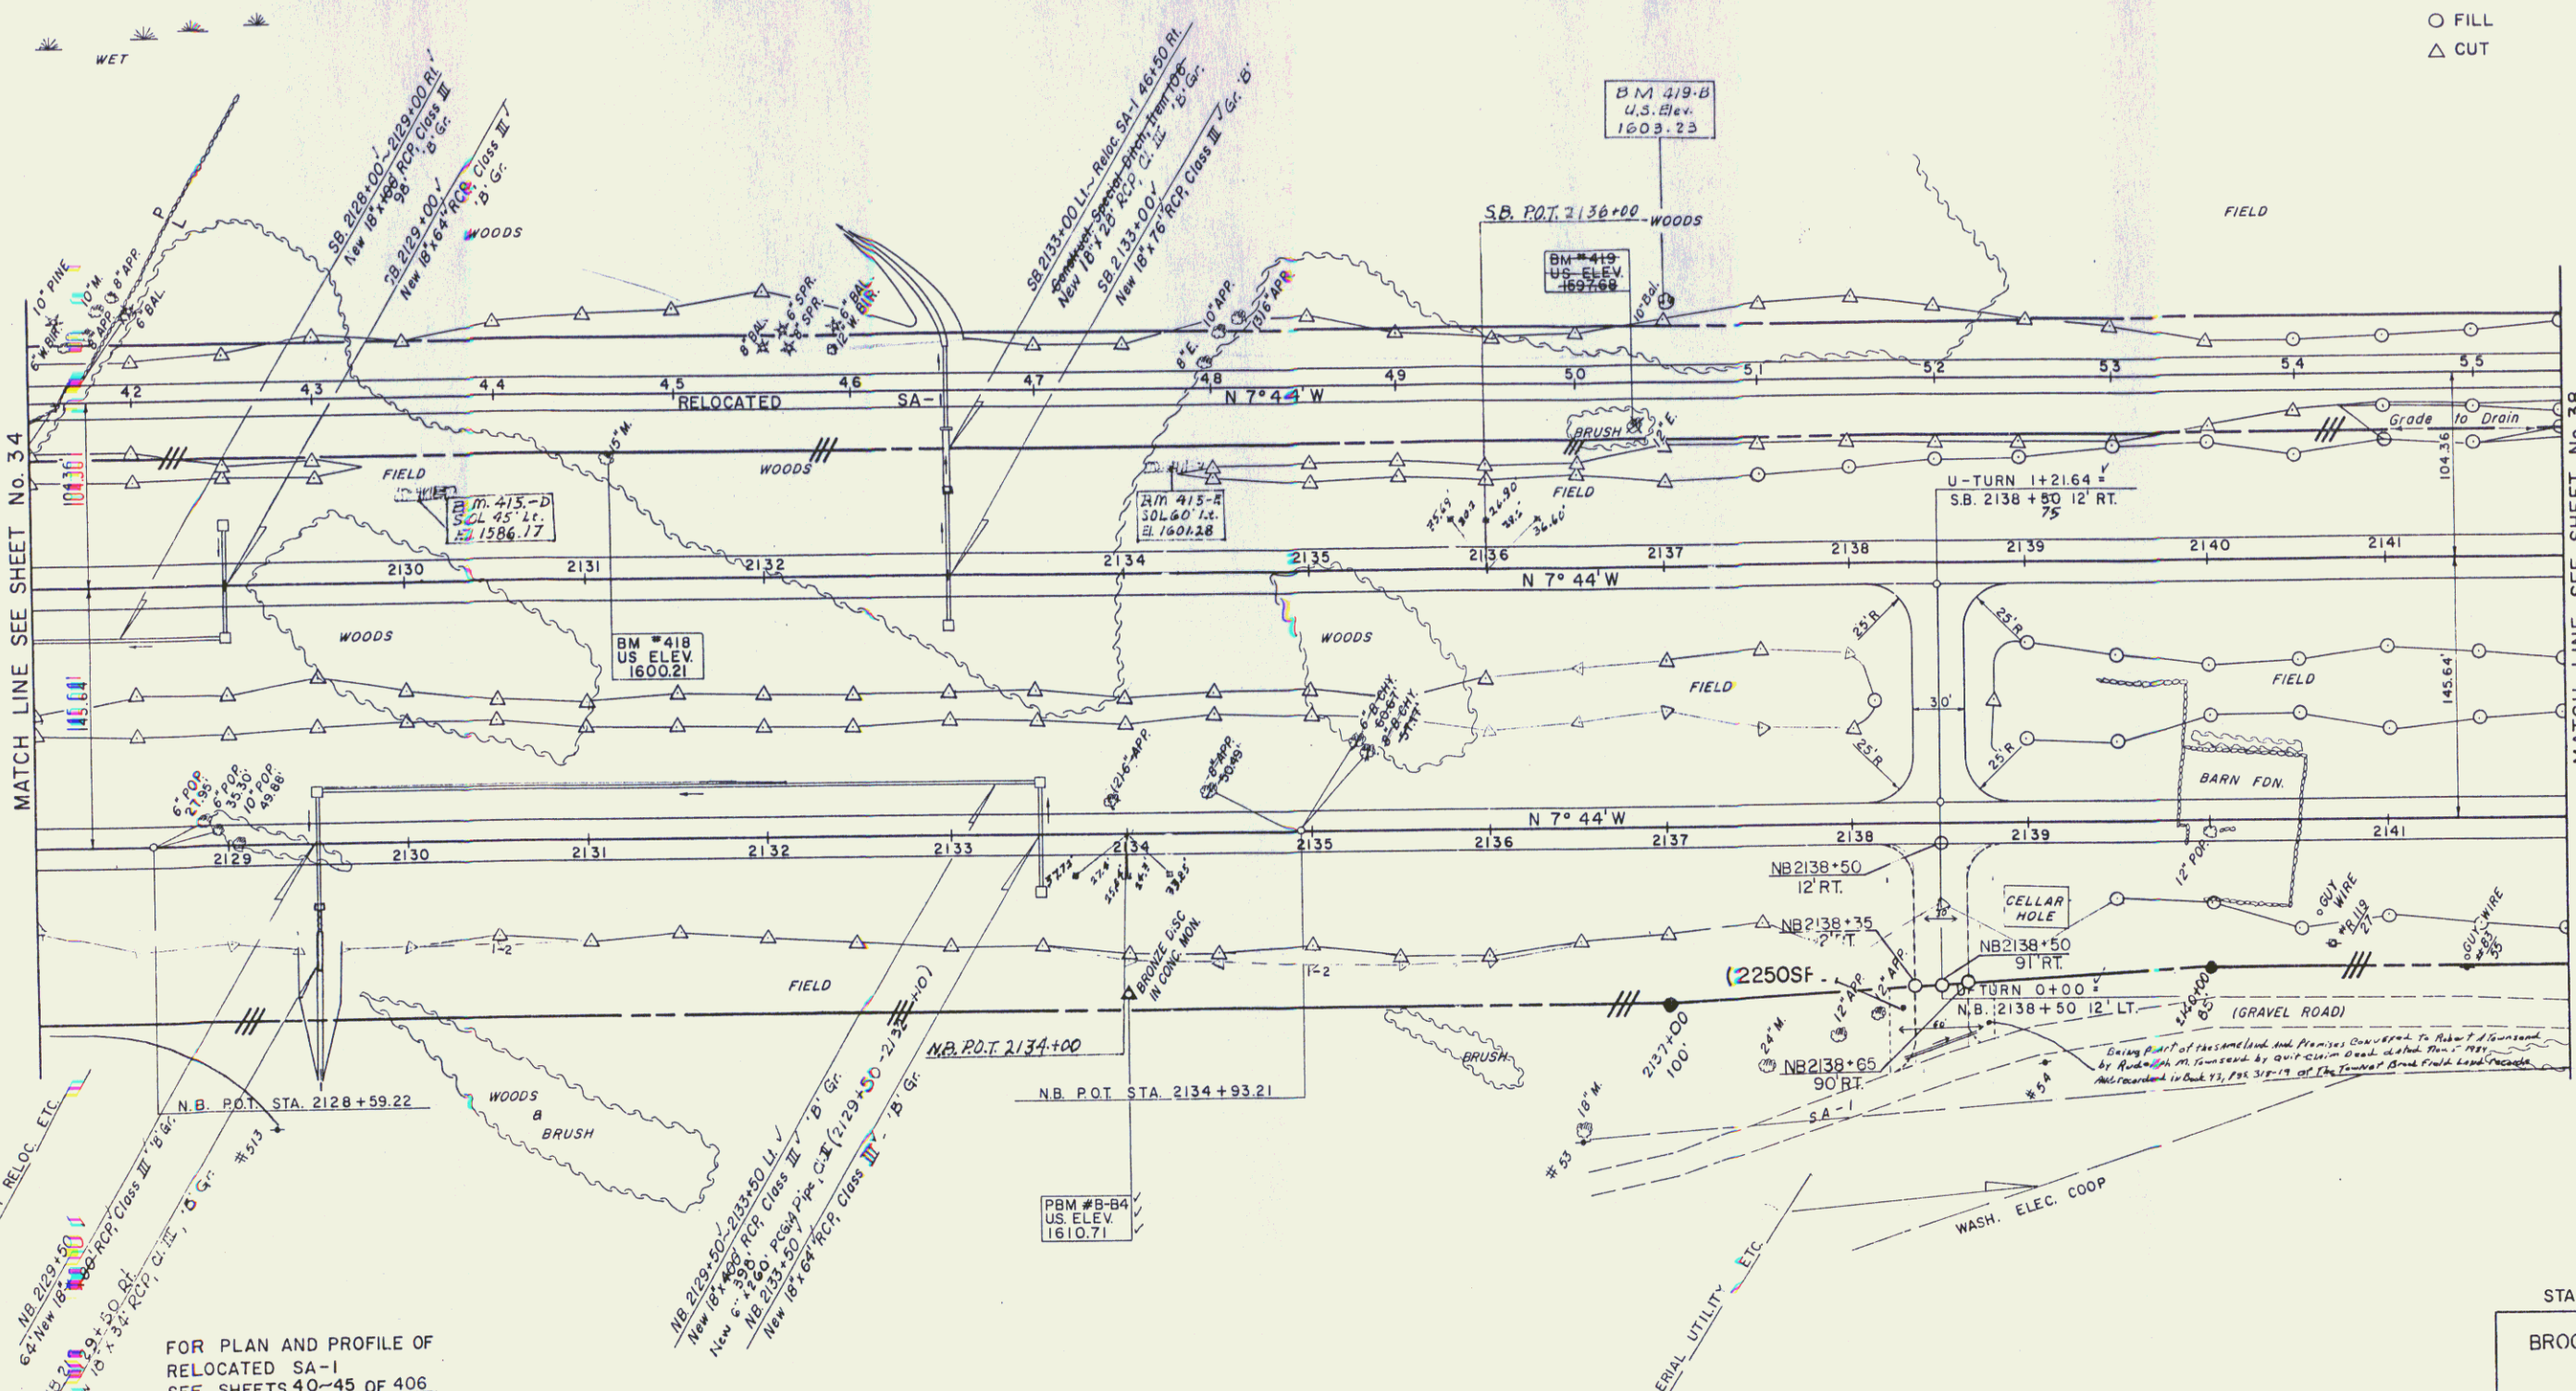

MATCH LINE SEE SHEET No. 34

MATCH LINE SEE SHEET No. 38

POSTER, GORDEN & ARMSTRONG  
CONSULTING ENGINEERS NEWARK, N.J.

FOR PLAN AND PROFILE OF  
RELOCATED SA-1  
SEE SHEETS 40-45 OF 406.

CONTROL OF ACCESS IS COMPLETE ON THIS SHEET



STAGE 2 CONSTRUCTION  
BROOKFIELD-WILLIAMSTOWN  
BERLIN  
I 89-1 (11) (29)  
CONTRACT No. 1  
SHEET 36 OF 406  
70 263

78