



Stone Fill For Slope Protection (Light Type)
Item 512
Reloc. SA-1 30+75-32+40 LT.

Two Cable Guard Rail
Item 541
Reloc. SA-1 30+28-31+52 RT.
Reloc. SA-1 30+68-32+76 LT.
7+00 33+34

CONSTRUCT RAMP DRIVE
30+00 - 31+25 + LT.

RELOCATED SA-1
CURVE DATA
 $\Delta = 13^\circ 21' 06''$
 $D = 5^\circ 15' 00''$
 $R = 1091.35'$
 $T = 127.74'$
 $L = 254.32'$
 $E = 7.45'$
 BANK = 3/4" PER FT.

R.O.W. BID ITEM
CONSTRUCT DRIVE
38+50 LT. ✓

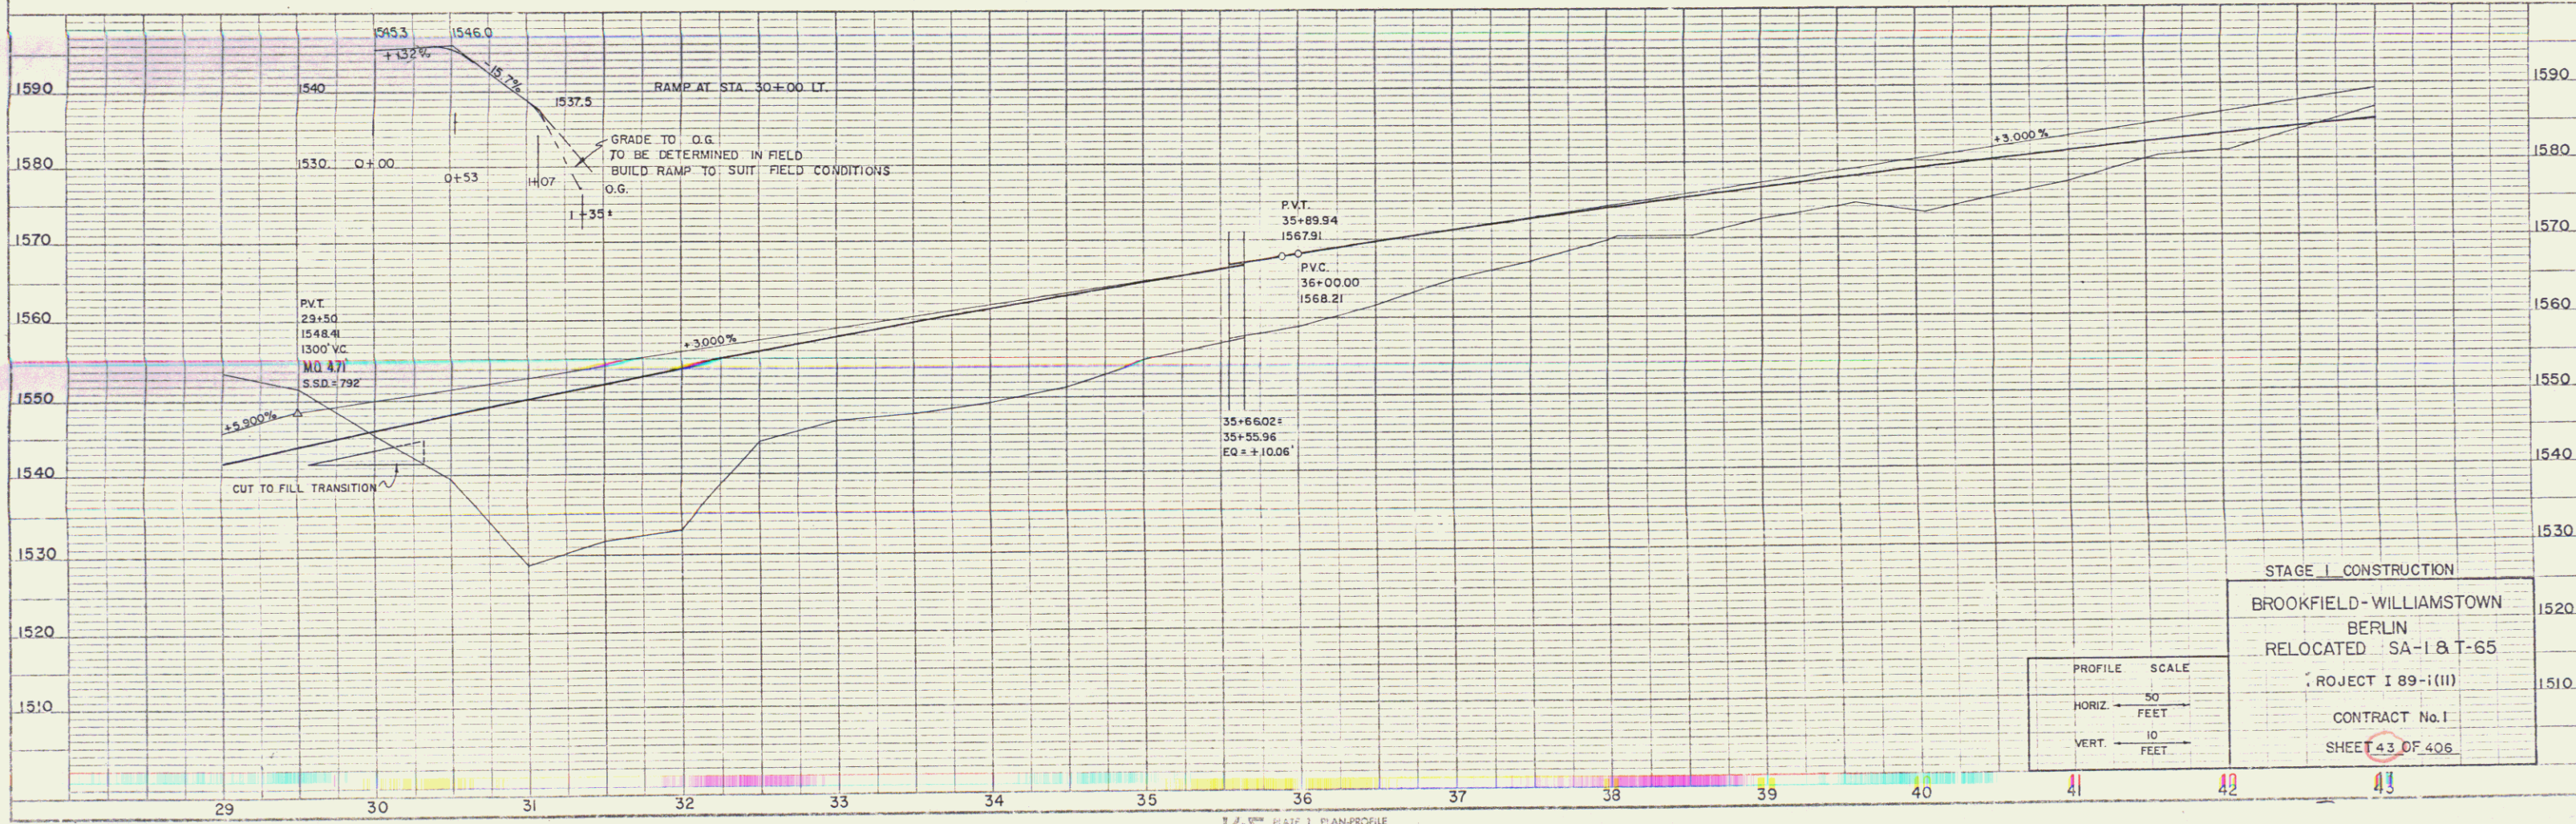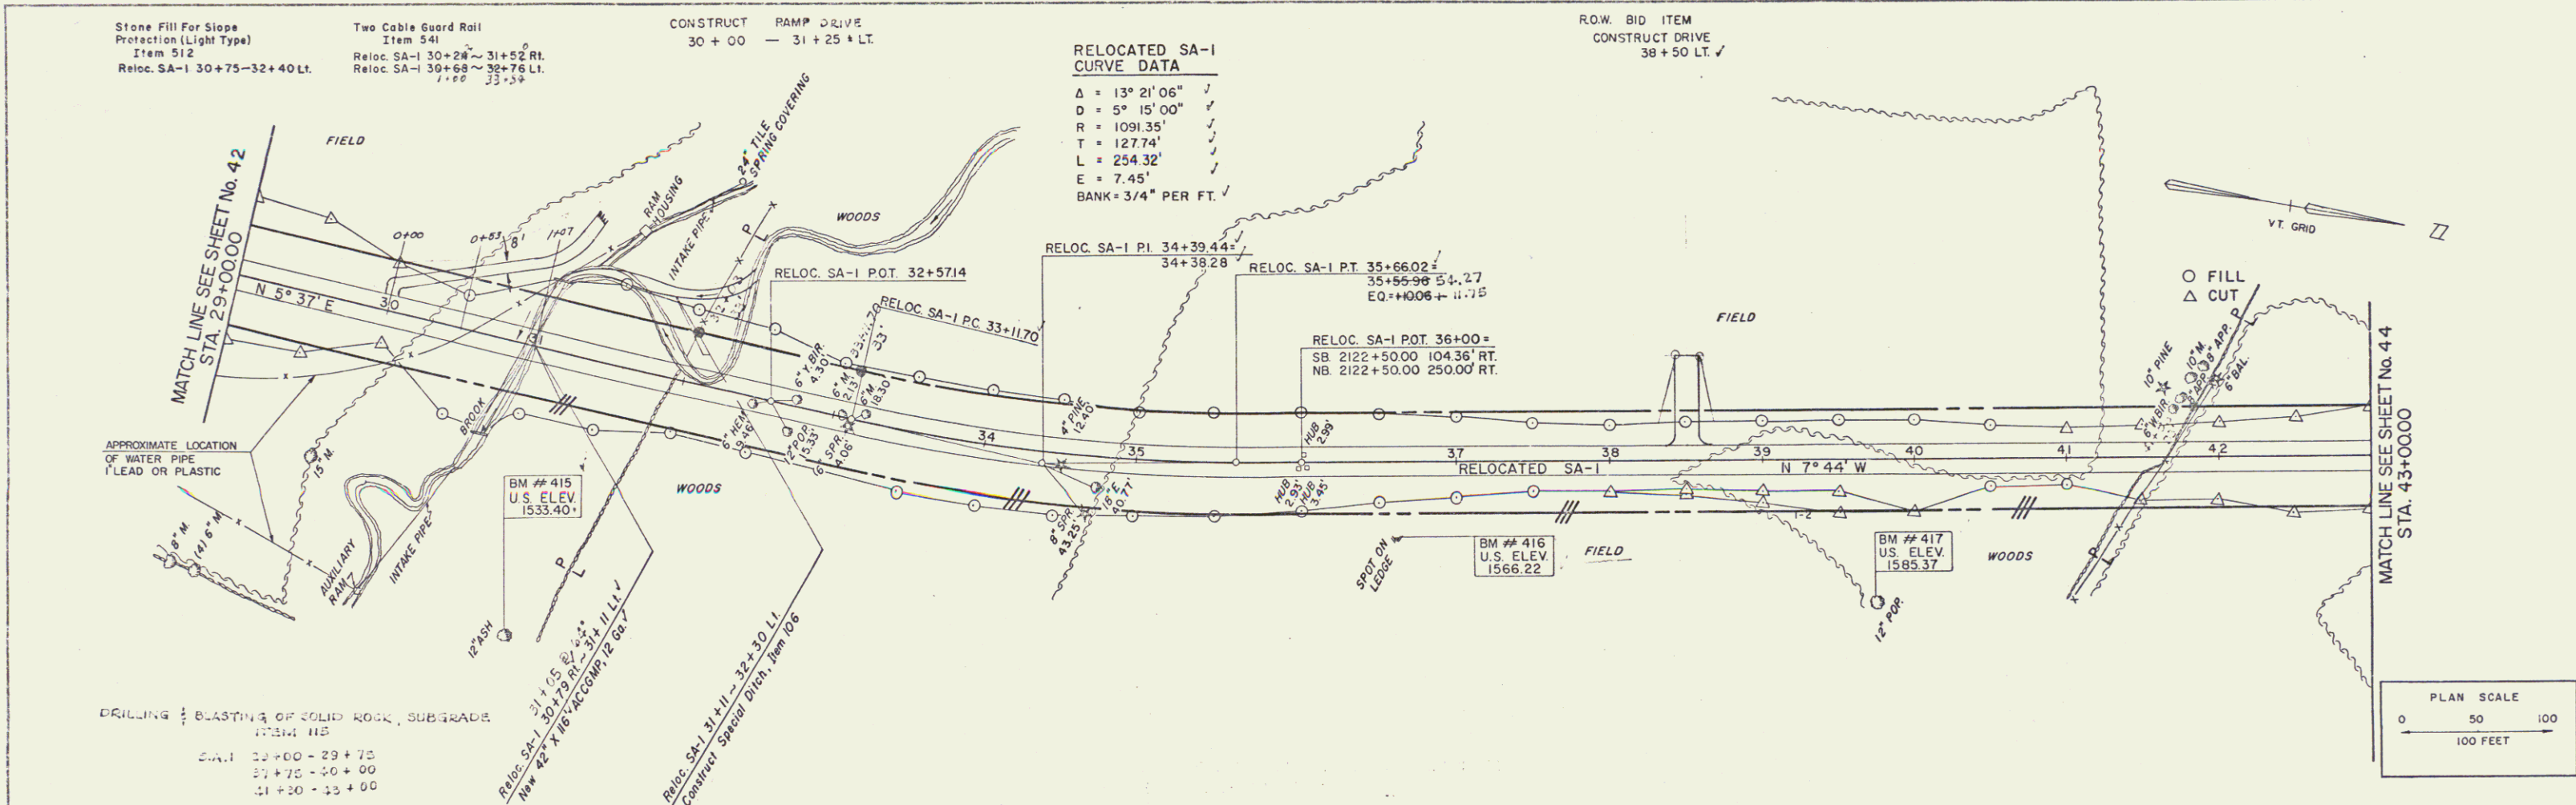

DESIGNED BY
 CHECKED BY
 DATE
 NO. 13

DESIGNED BY
 CHECKED BY
 DATE
 NO. 13

STAGE I CONSTRUCTION
 BROOKFIELD - WILLIAMSTOWN
 BERLIN
 RELOCATED SA-1 & T-65
 PROJECT 189-i(II)
 CONTRACT No. 1
 SHEET 43 OF 406