


**PROPERTY LINE FENCE WITH STEEL POSTS ITEM 583-II MOD.**


STA.	STA.	POS.
NORTHBOUND		
2157+00	2172+00	RT.
SOUTHBOUND		
2157+00	2172+00	LT.

PROPERTY LINE FENCE W/ST POSTS  
ITEM 583-II MOD.  
S.B. 2157+00 - 2167+05 LT.  
(ERECT FENCE PRIOR TO COMMENCEMENT  
OF OTHER WORK IN THIS AREA)

Drilling & Blasting of Solid Rock Subgrade Item 85  
NB 2157+00 - 2170+00  
SB 2157+00 - 2163+00  
2163+00 - 2172+00 70+5.0

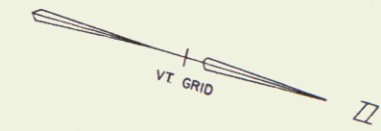


○ FILL  
△ CUT

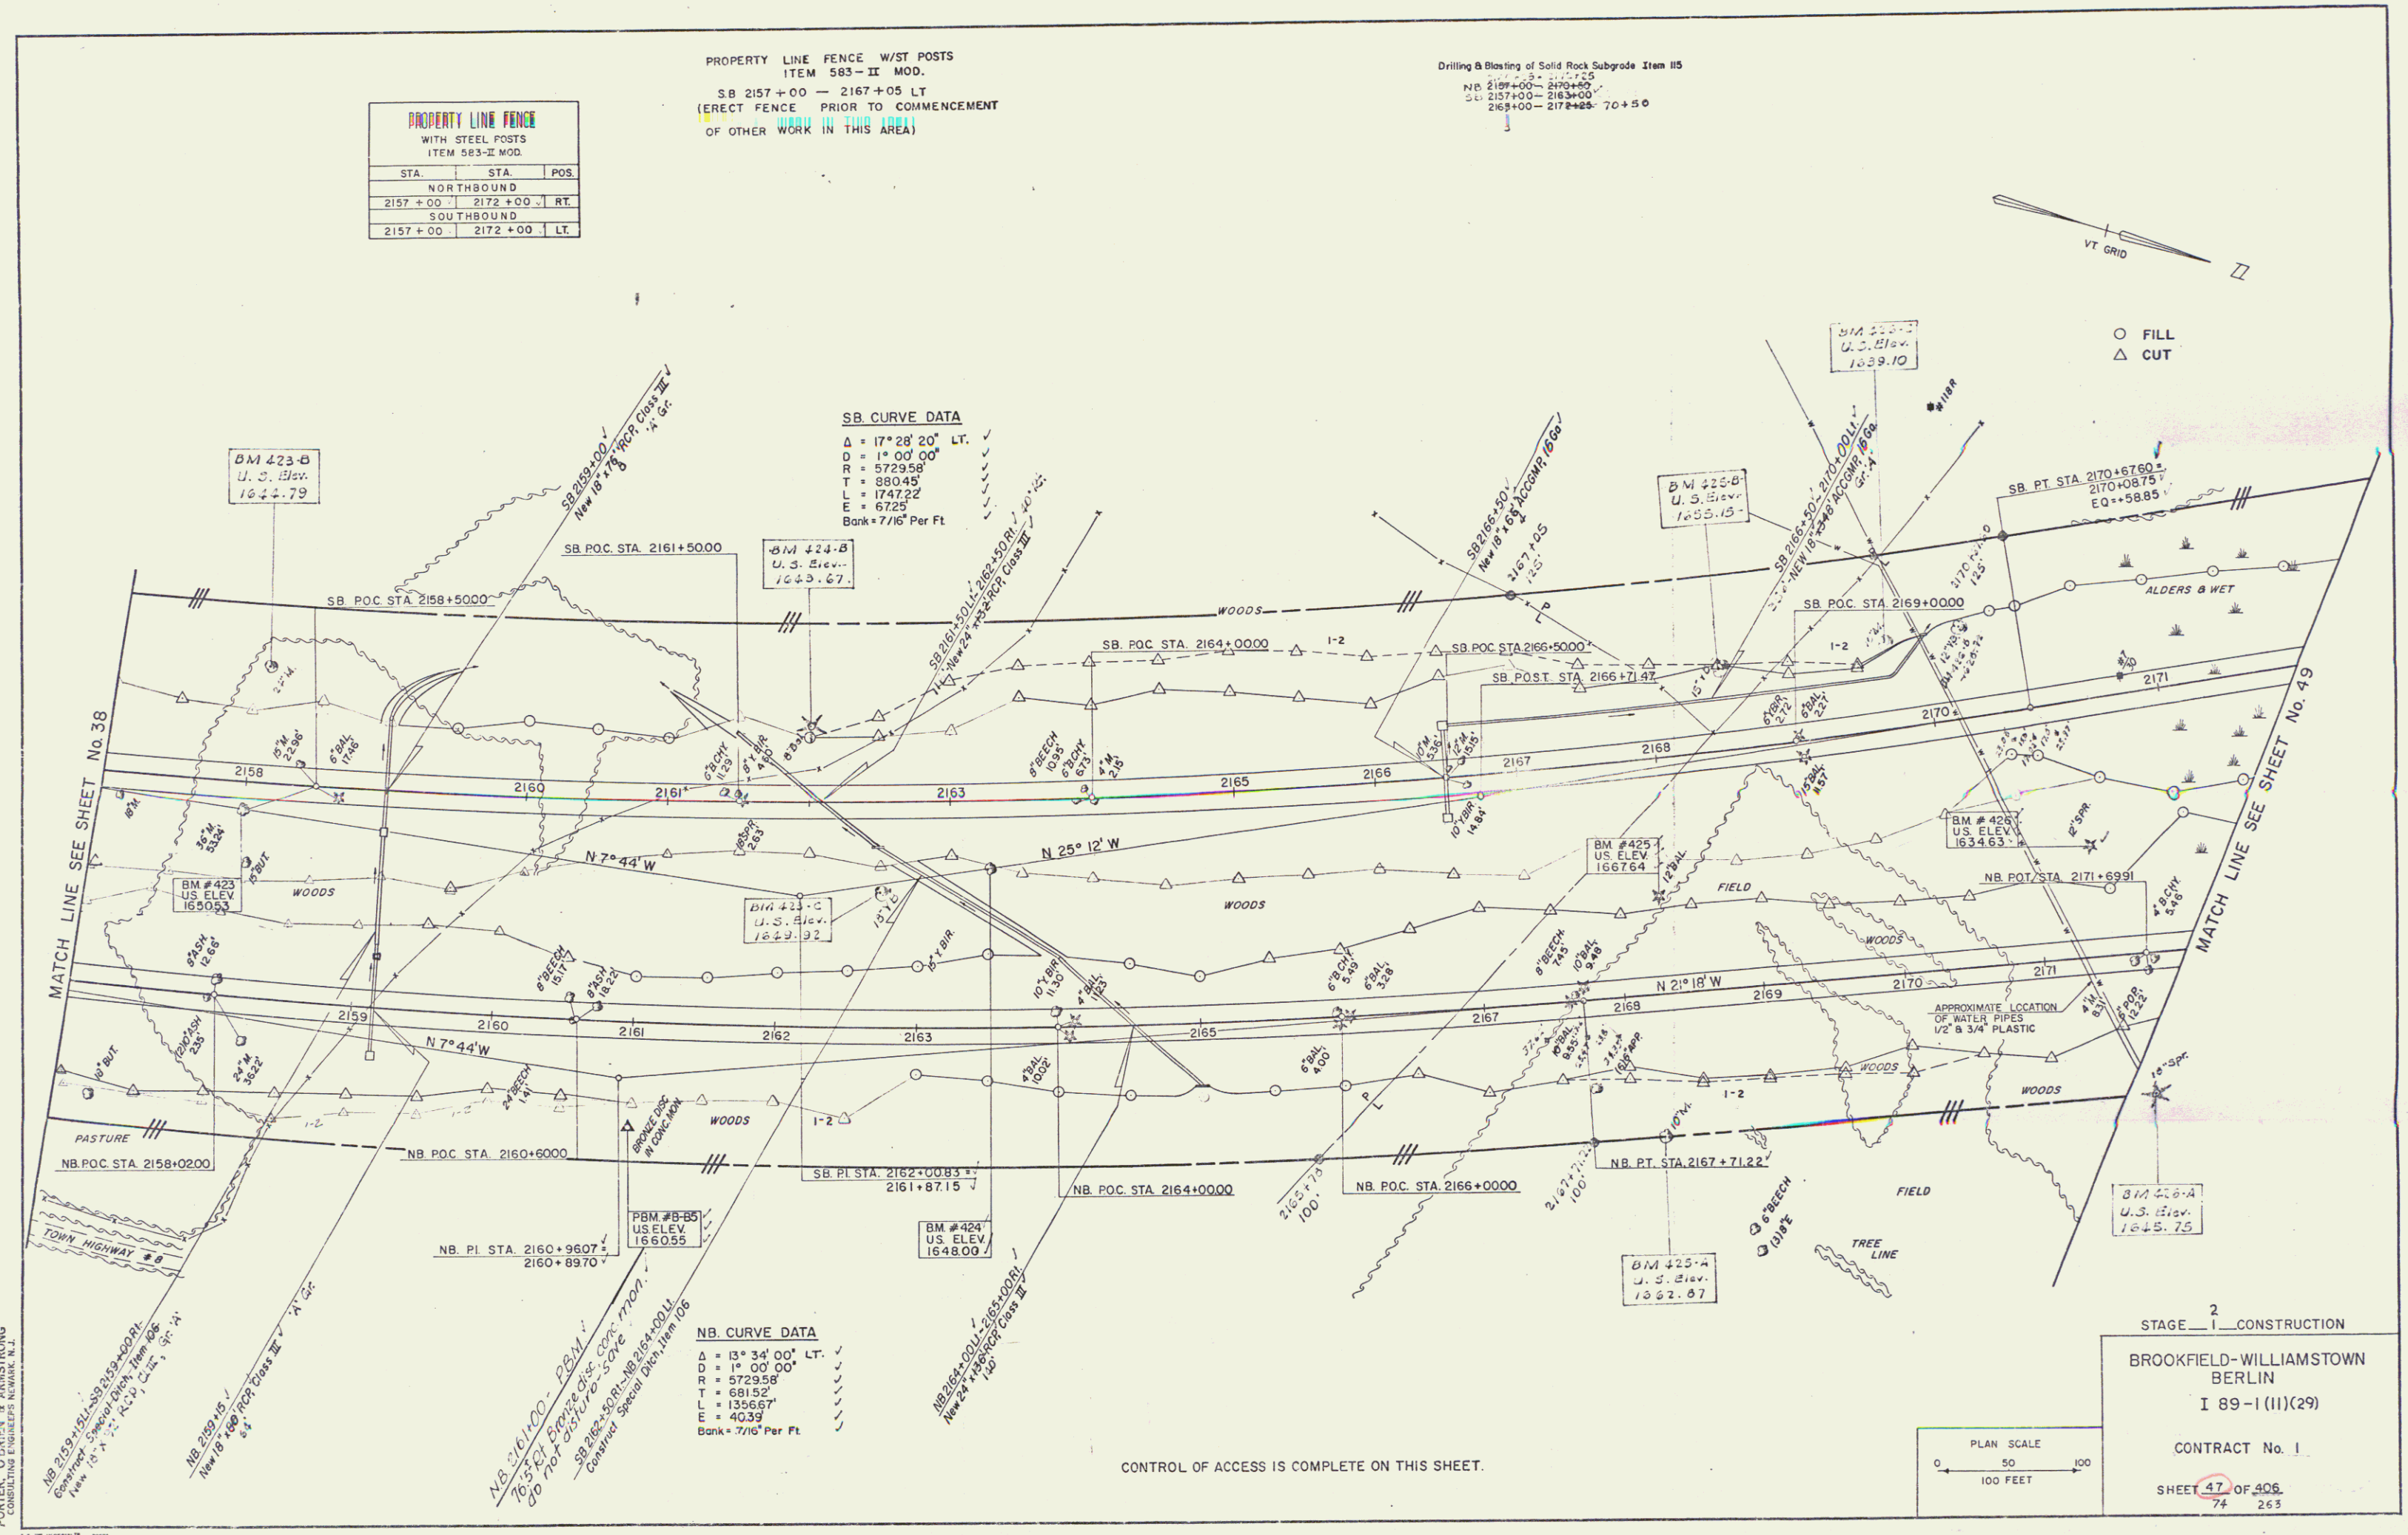

PORTER, O'DRISCOLL & ARMSTRONG  
REGISTERED PROFESSIONAL ENGINEERS  
100 STATE STREET, SUITE 200  
BURLINGTON, VERMONT 05401

CONTROL OF ACCESS IS COMPLETE ON THIS SHEET.

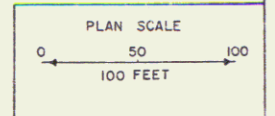

STAGE 2 CONSTRUCTION  
BROOKFIELD-WILLIAMSTOWN  
BERLIN  
I 89-1(11)(29)  
CONTRACT No. 1  
SHEET 47 OF 406  
74 263