


\* DENOTES STAGE 2 ITEMS  
 Stone Fill For Slope Protection (Light Type) Item 51.2  
 SB. 2220+50 - 2221+50 LL

Plank Guard Rail Item 540  
 NB. 2225+65 RI-24 LF

STA	STA	PCS
NORTHBOUND		
2218+00	2232+00	RT.
SOUTHBOUND		
2218+00	2232+00	LT.

PROPERTY LINE FENCE W/ST POSTS ITEM - 583-II MOD  
 SB 2218+00 - 2228+62 LT.  
 (ERECT FENCE PRIOR TO COMMENCEMENT OF OTHER WORK IN THIS AREA)

Drilling & Blasting of Solid Rock Subgrade, Item 118  
 NE 2218+00 - 2232+00  
 SB 2218+00 - 2232+00

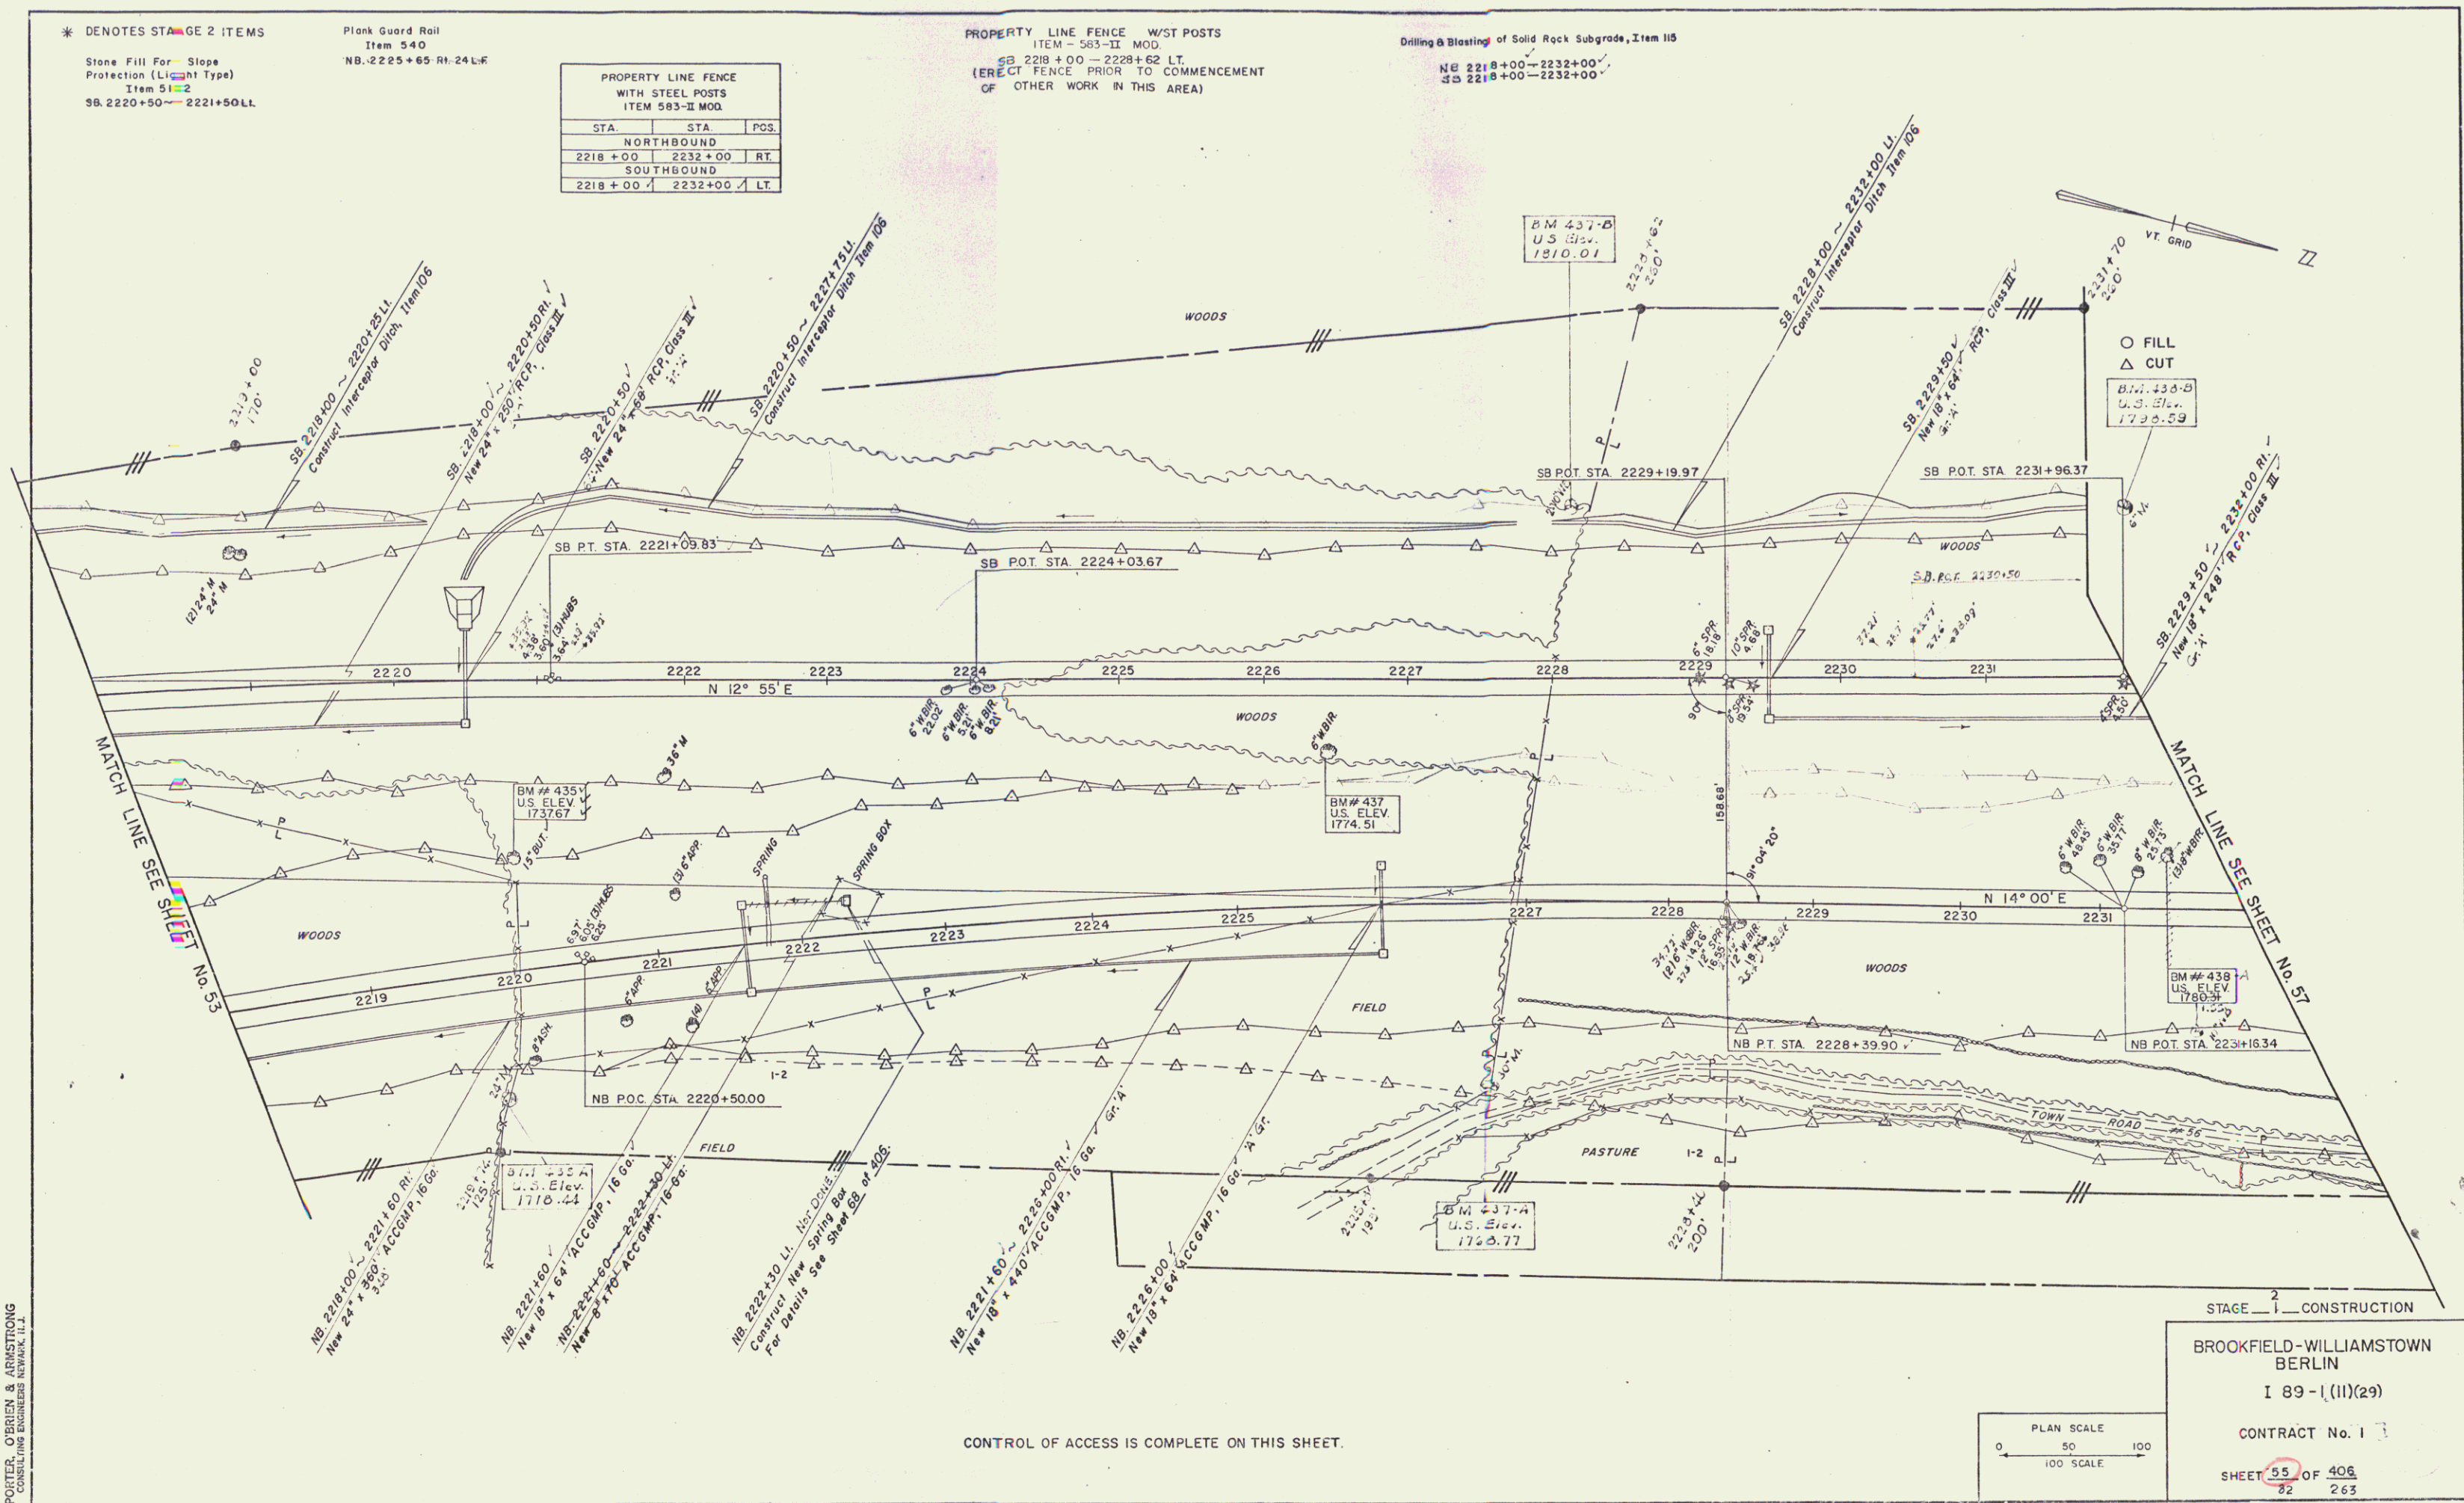

PORTER, OBERHEIM & ARMSTRONG CONSULTING ENGINEERS NEWARK, N.J.

90