


* DENOTES STAGE 2 ITEMS
 Stone Fill For Slope Protection (Light Type) Item 512
 68.2233+50~2234+00=LT


Planck Guard Rail Item 540
 NB. 2234+75 Rt. 40-LE.

PROPERTY LINE FENCE WITH STEEL POSTS ITEM 583-3 MOD.		
STA.	STA.	POS.
NORTHBOUND		
2232+00	2247+00	RT.
SOUTHBOUND		
2232+00	2247+00	LT.

Drilling & Blasting of Solid Rock Subgrade, Item 115
 SB 2232+00~2242+50 2S
 SB 2244+50~2246+00
 NB 2234+00~2244+25
 2
 37
 NB 2246+75~2247+00

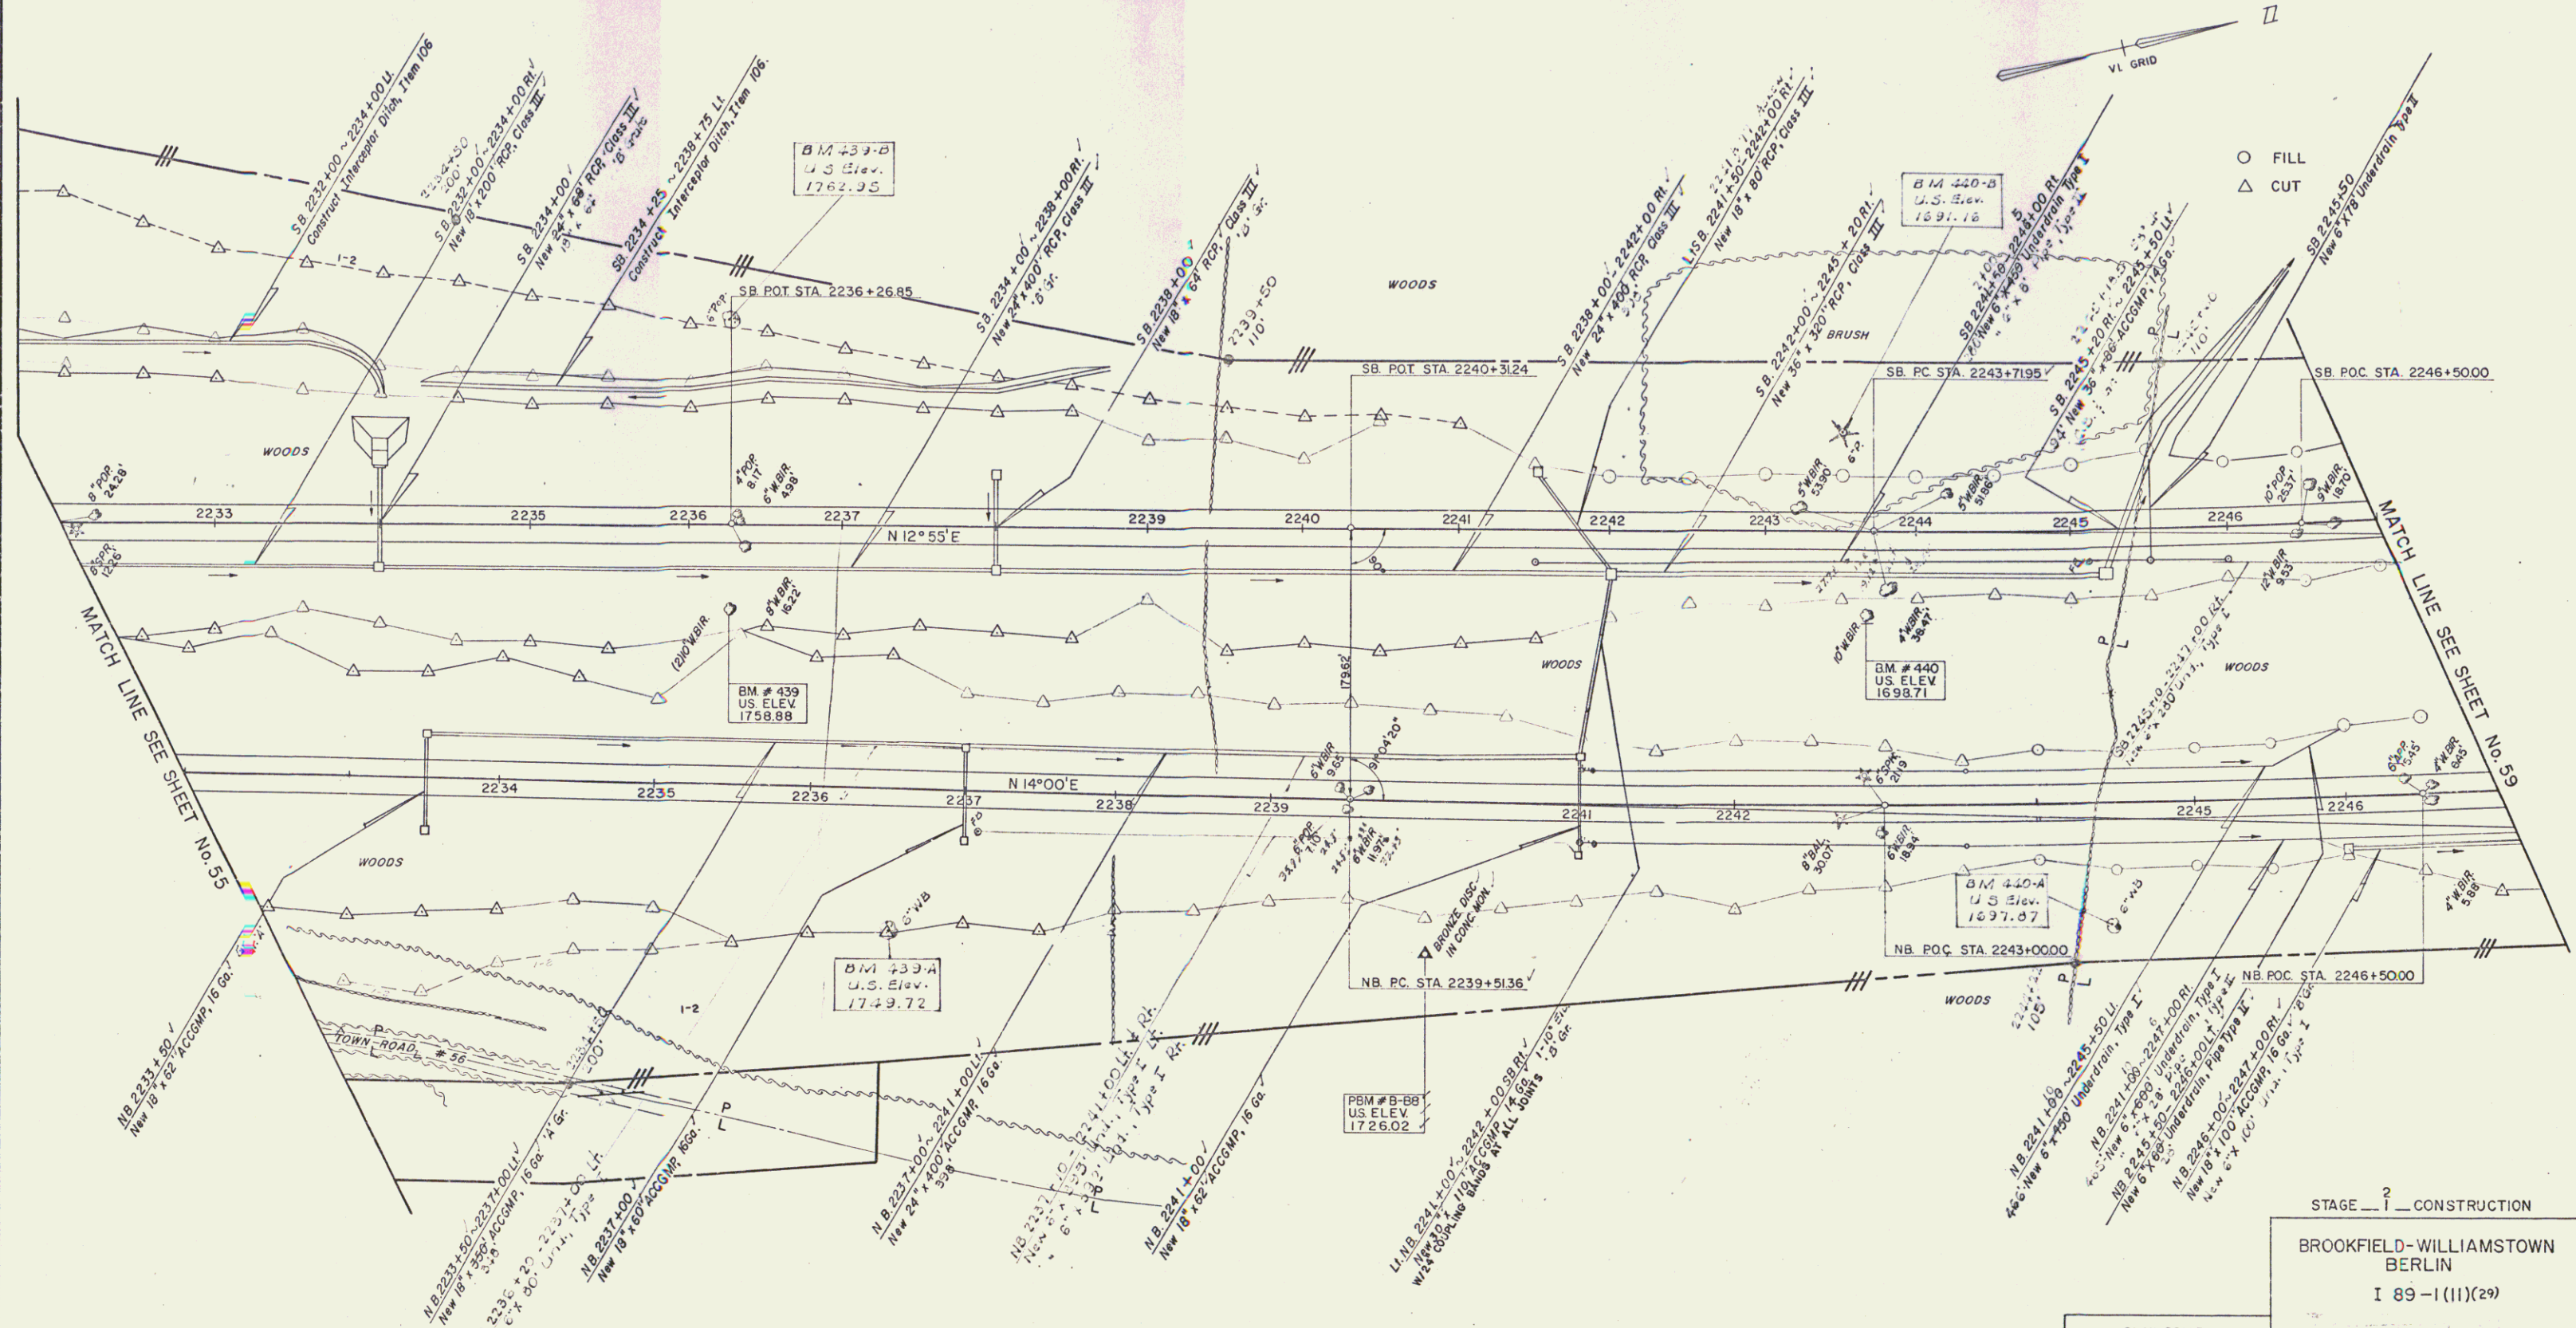

CONTROL OF ACCESS IS COMPLETE ON THIS SHEET

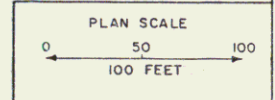

STAGE 2 CONSTRUCTION
 BROOKFIELD-WILLIAMSTOWN
 BERLIN
 I 89-1(11)(29)
 CONTRACT No. 1
 SHEET 57 OF 405
 88 263

PORTER, O'BRIEN & ARMSTRONG
 CONSULTING ENGINEERS NEWARK, N.J.

91