

* DENOTES STAGE 2 ITEMS

DRILLING & PLACING OF SOLID ROCK SUBGRADE ITEM 115 NB 2247+00-2248+00

Three Cable Guard Rail w/ Lt. St. Posts Item 538 NB 2261+50-2262+00 LT. SB 2257+50-2262+00 LT.

Treated Timber Curb Item 539 NB 2261+50-2262+00 LT. SB 2258+00-2262+00 LT.


PROPERTY LINE FENCE WITH STEEL POSTS ITEM 593-III MOD.		
STA.	STA.	POS.
NORTHBOUND		
2247+00	2262+00	RT.
SOUTHBOUND		
2246+00	2262+00	LT.

SB. CURVE DATA

$\Delta = 21^\circ 17' 20''$ LT. ✓
 $D = 1^\circ 00' 00''$ ✓
 $R = 5729.58'$ ✓
 $T = 1076.86'$ ✓
 $L = 2128.89'$ ✓
 $E = 1003.2$ ✓
 Bank = 5/16" Per Ft ✓
 7/16"



○ FILL
△ CUT

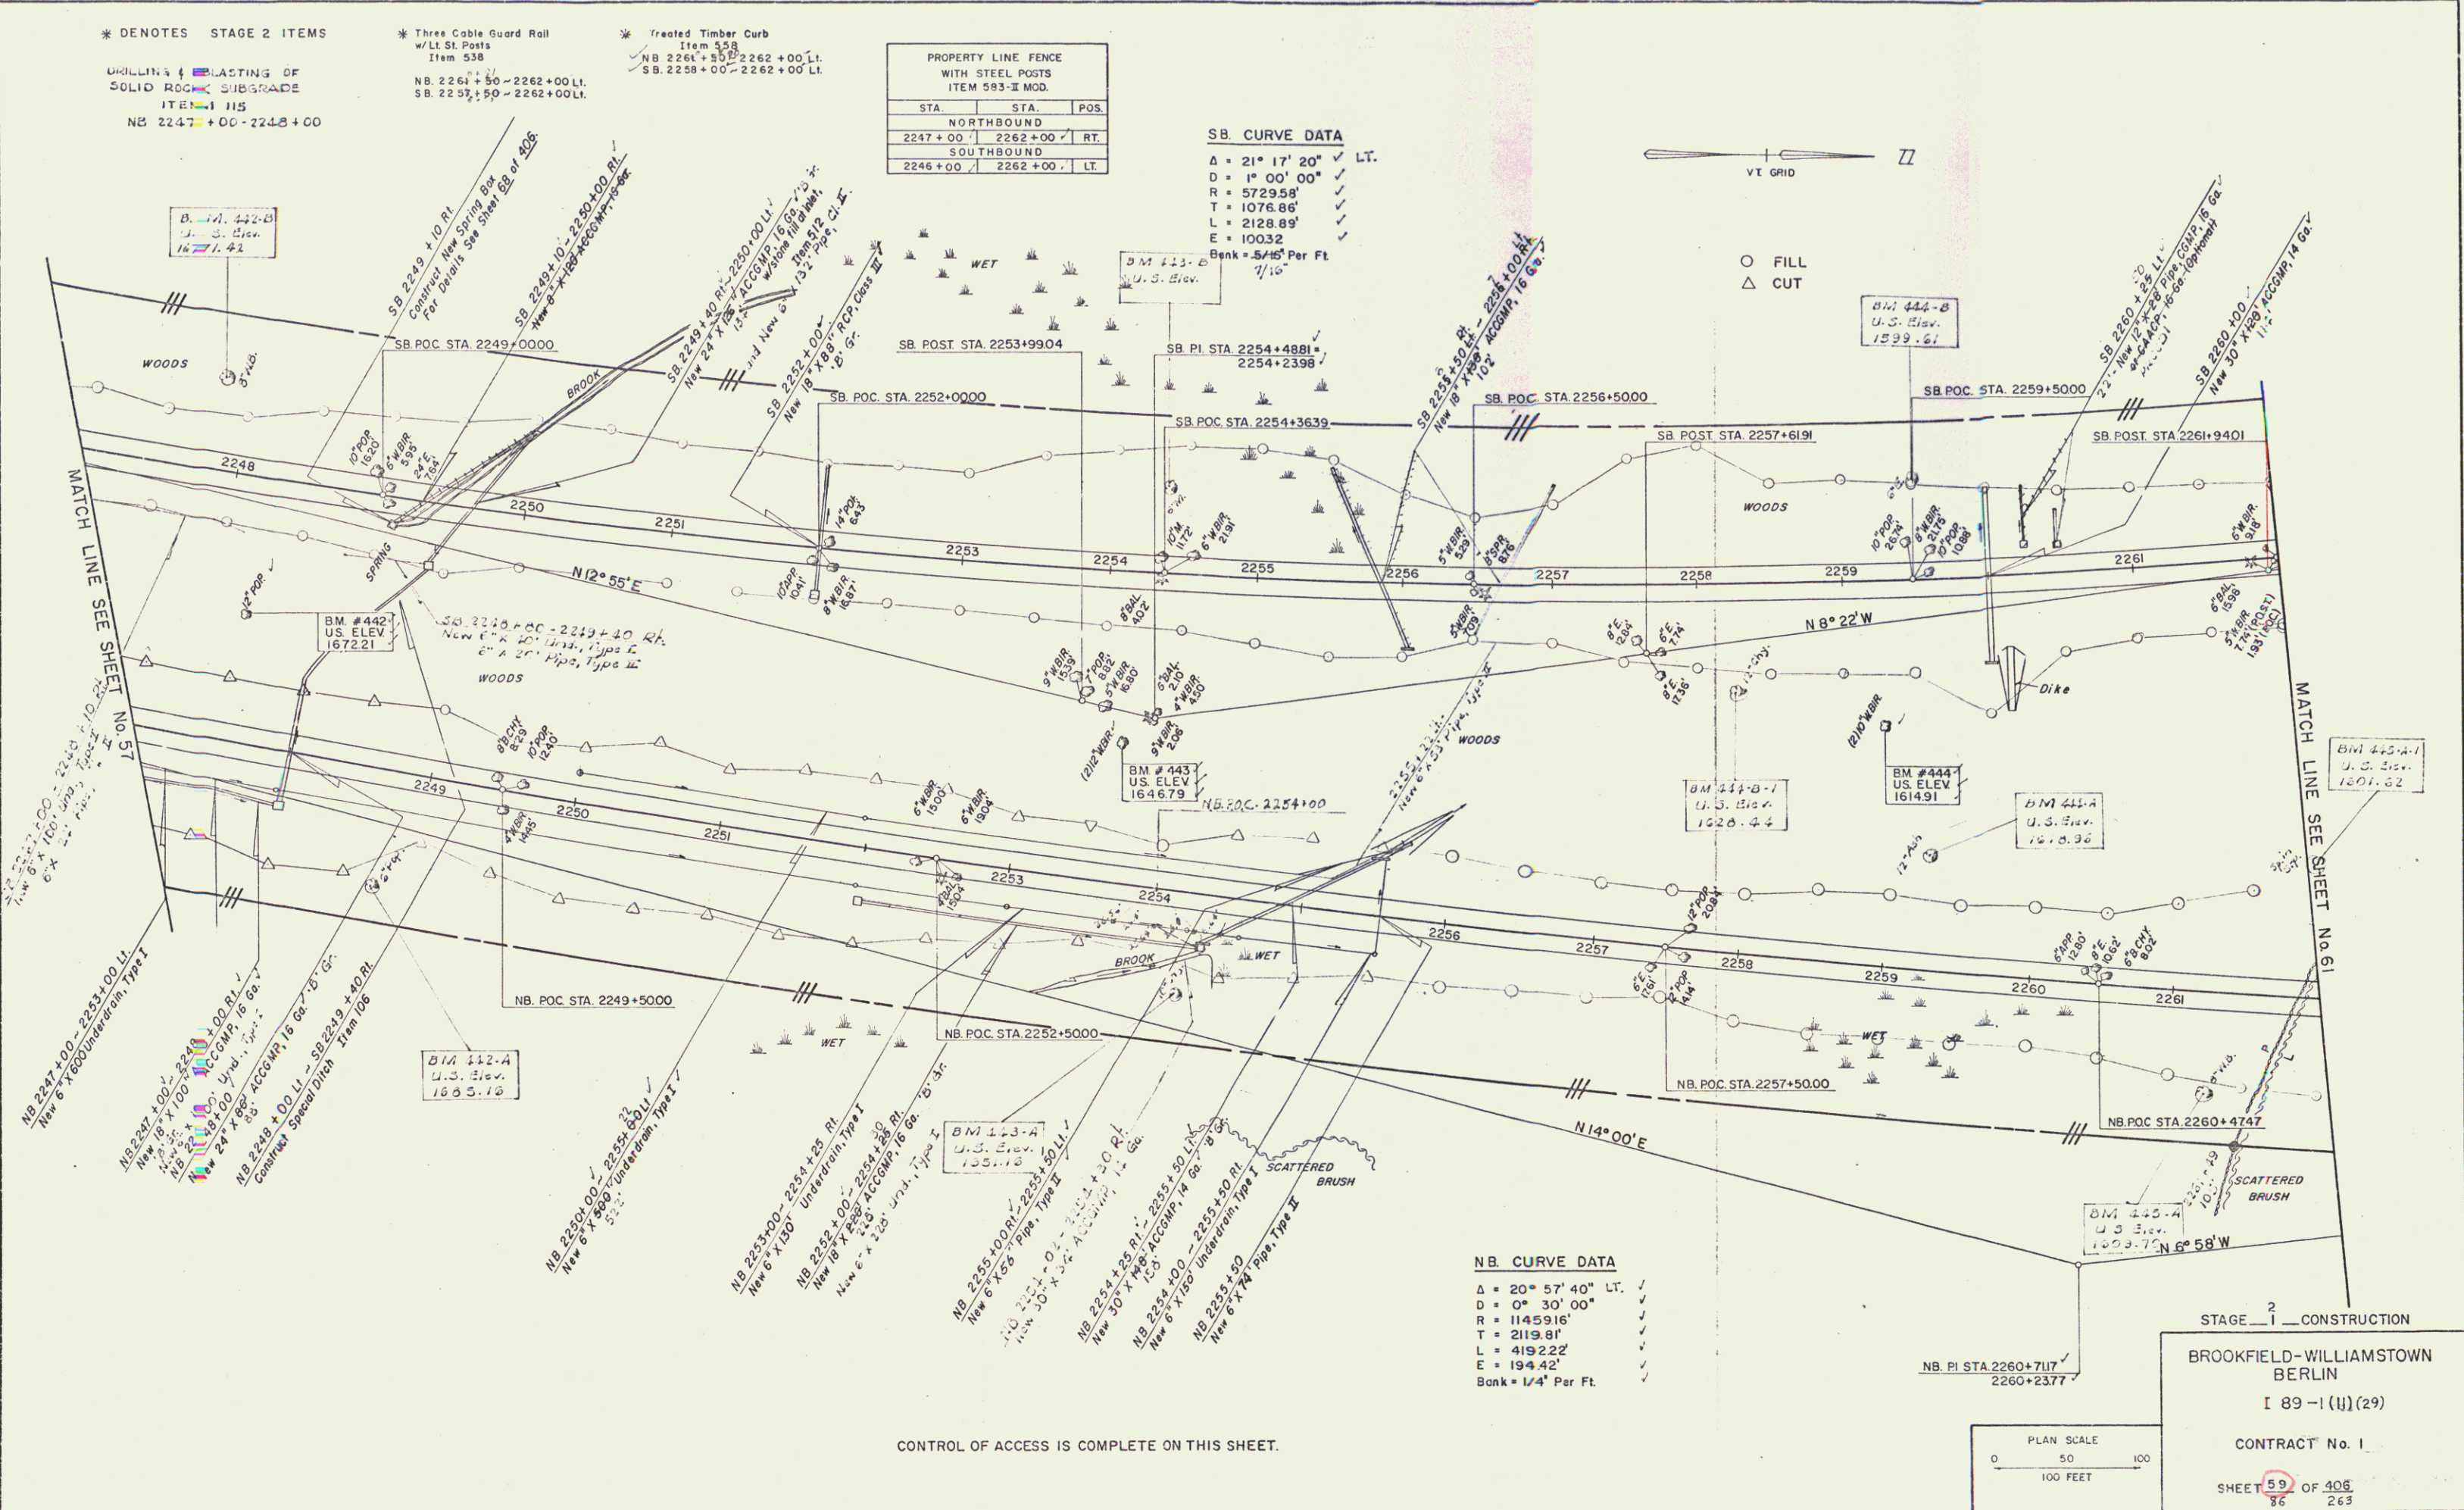

STAGE 2 CONSTRUCTION
 BROOKFIELD-WILLIAMSTOWN BERLIN
 I 89-1(U) (29)
 CONTRACT No. 1
 SHEET 59 OF 406
 86 263