

* DENOTES STAGE 2 ITEMS

Stone Fill For Slope Protection (Light Type)
Item 515
NB 2272+58-2272+93 Rt.
SB 2273+69-2273+92 Rt.
SB 2273+50-2273+00 Rt.
NB 2270+00-2274+50 Lt.

* Three Cable Guard Rail w/11 St. Posts
Item 538
NB 2269+45-2276+00 Rt.
NB 2262+00-2265+50 Lt.
SB 2264+98-2268+99 Rt.
SB 2262+00-2269+98 Lt.


* Standard Steel Beam Guard Rail w/Steel Posts (6'-3" Spacing)
Item 545-A
NB 2270+85-2276+00 Lt.
SB 2272+07-2276+00 Rt.
SB 2271+94-2276+00 Lt.

* Treated Timber Curb Item 558
NB 2262+00-2264+50 Lt.
NB 2271+00-2276+00 Lt.
SB 2266+50-2268+90 Rt.
SB 2272+08-2276+00 Rt.
SB 2262+00-2269+50 Lt.
SB 2272+08-2276+00 Lt.

* CONSTRUCT U-TURN
2269+50 SB Rt.

PROPERTY LINE FENCE WITH STEEL POSTS
ITEM 583-2 MOD.

STA.	STA.	POS.
NORTHBOUND		
2262+00	2276+00	Rt.
SOUTHBOUND		
2262+00	2276+00	Lt.

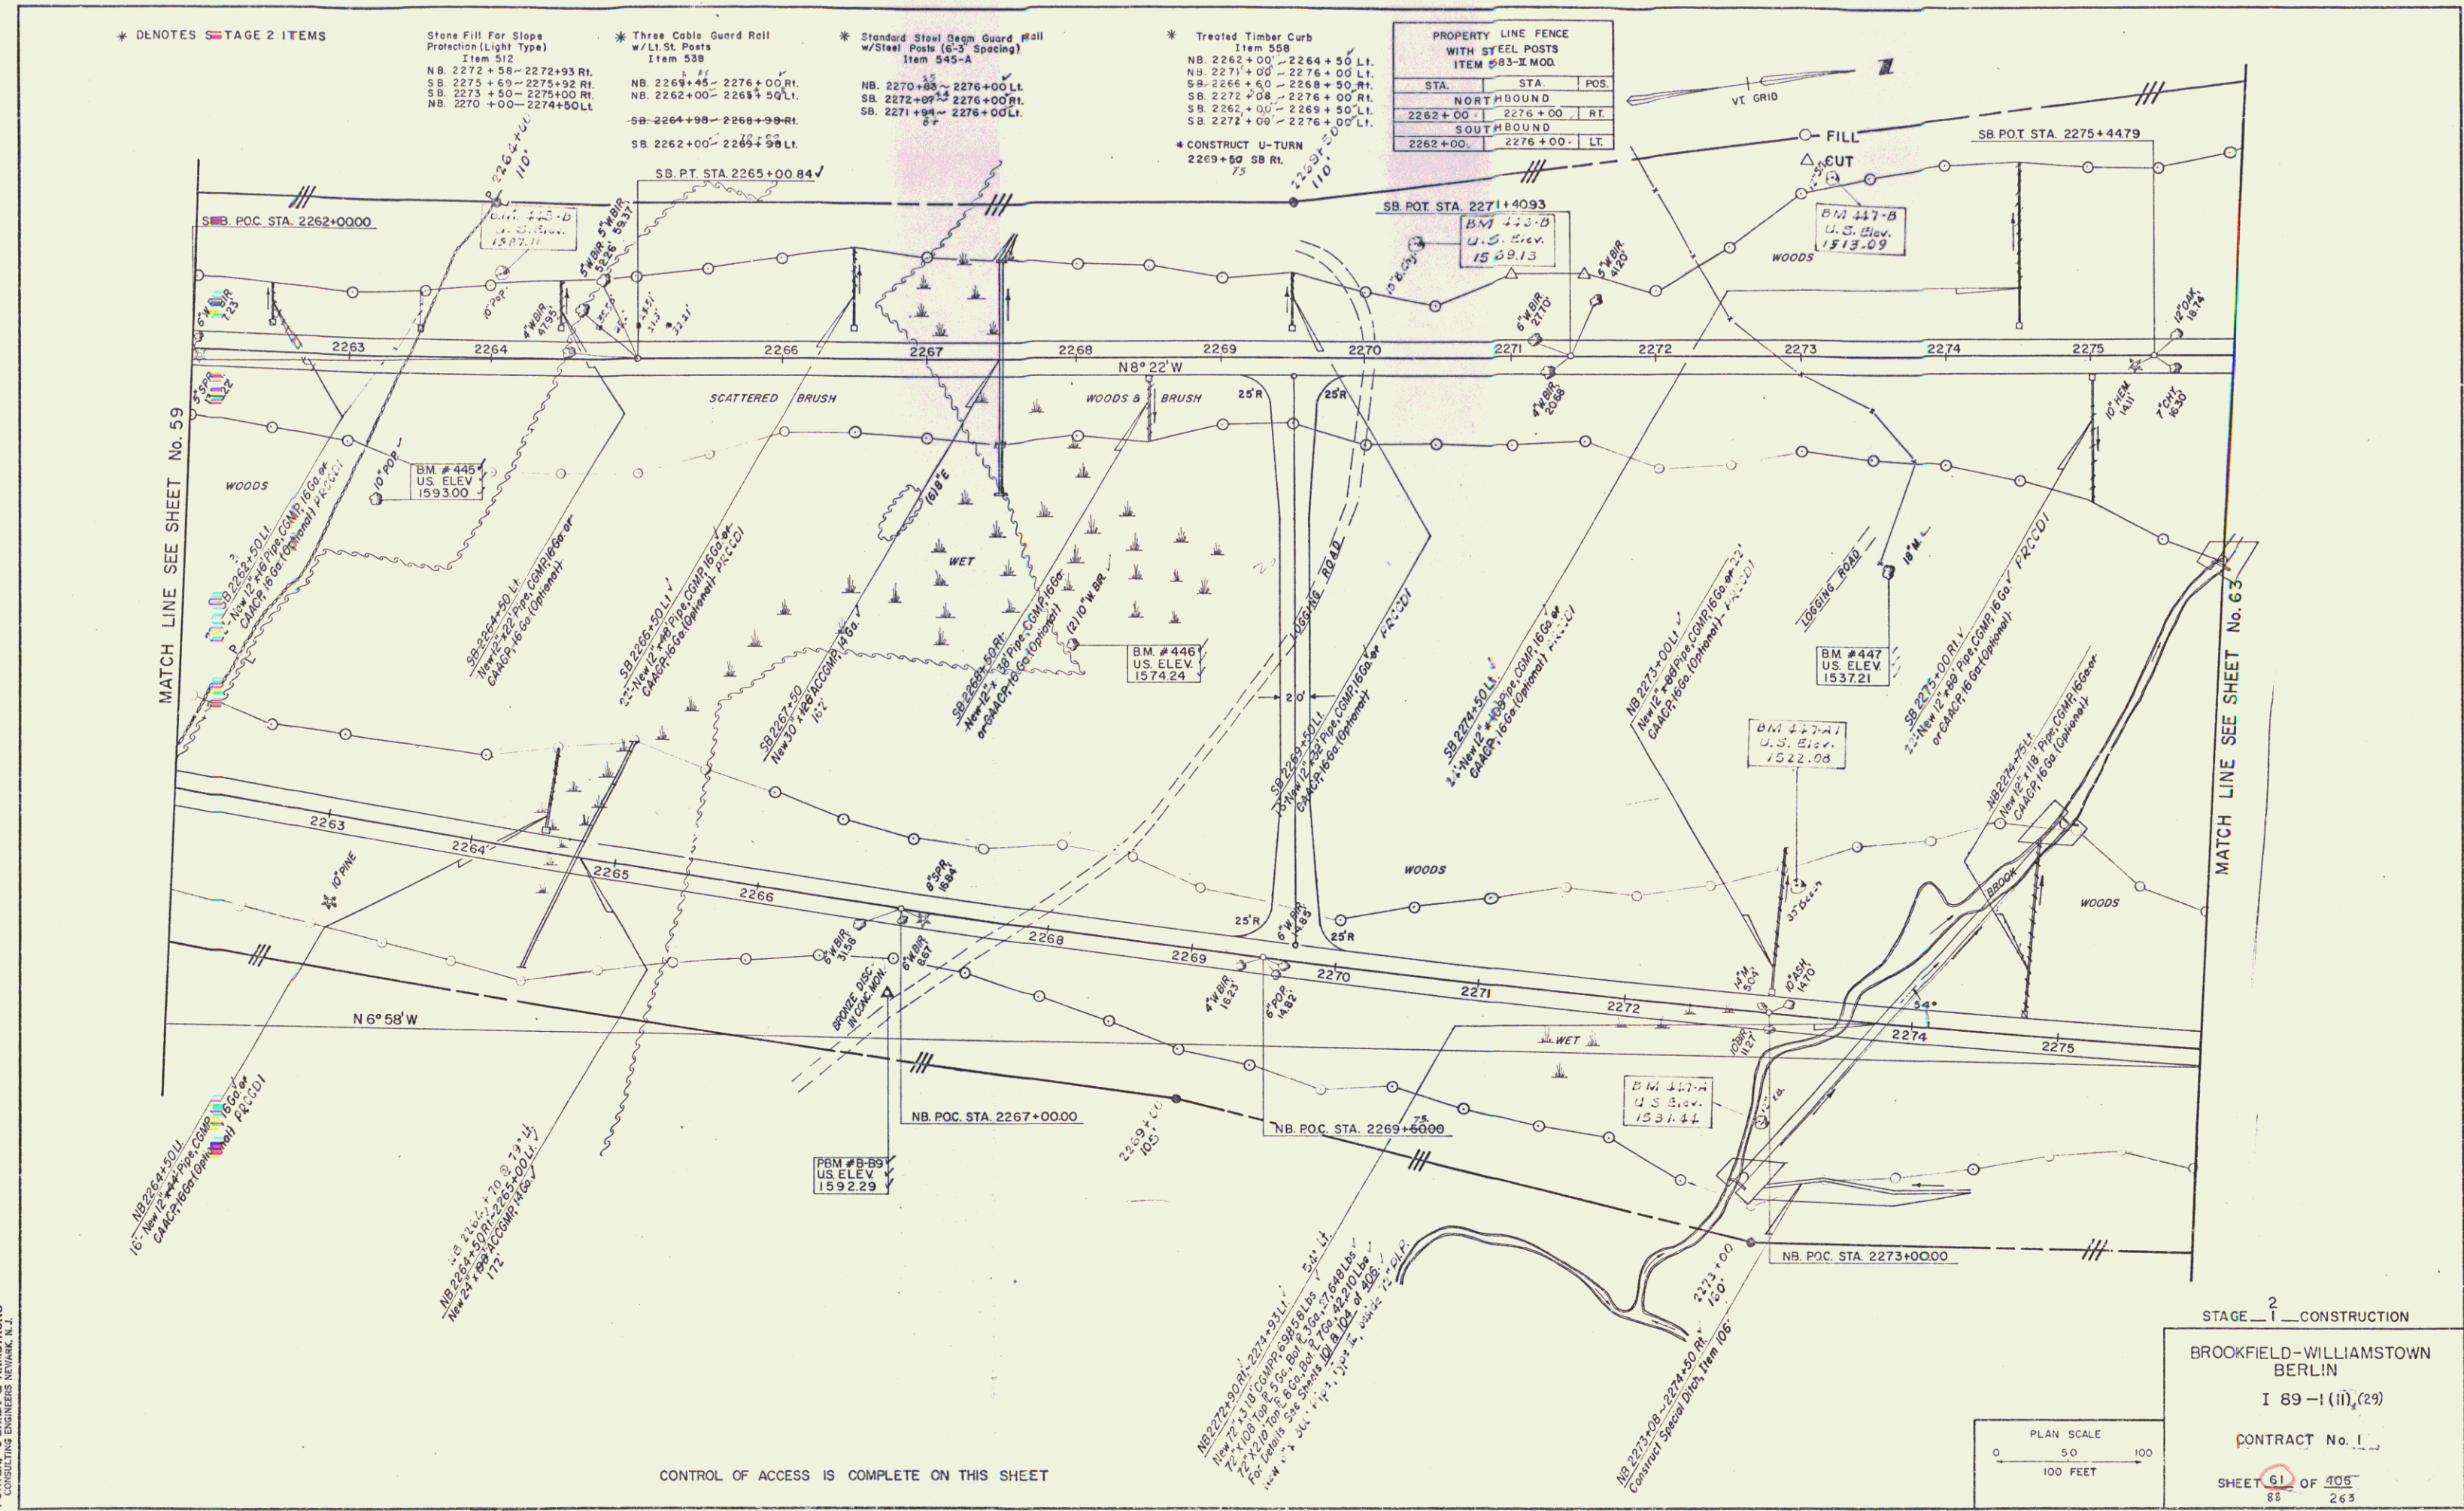

MATCH LINE SEE SHEET No. 59

MATCH LINE SEE SHEET No. 63

PORTER, O'BRIEN & ARMSTRONG
CONSULTING ENGINEERS ATLANTA, N.C.

CONTROL OF ACCESS IS COMPLETE ON THIS SHEET



STAGE 2 CONSTRUCTION
 BROOKFIELD-WILLIAMSTOWN
 BERLIN
 I 89-1 (II) (29)
 CONTRACT No. 1
 SHEET 61 OF 105
 88 263