

NOTES STAGE 2 ITEMS

Three Cable Guard Rail w/ Light Steel Posts Item 533 SB 2311+00-2320+00 LT


Jute Matting Item 623 NB 2314+00-2318+00 RT NB 2314+00-2318+00 LT SB 2319+00-2320+00 RT Ramp C-8+00-9+00 RT Ramp C-8+00-16+00 LT

NOTE: POSSIBLE GRAVES PARCEL NO. 22 RAMP "C" 2+00-14+70 RT. (50'-150' OFFSET) CONTRACTOR TO EXERCISE DUE CARE DURING CONSTRUCTION AND IF BODY IS FOUND, DUE PROCESS OF LAW IS TO BE FOLLOWED. (REFER TO SPECIAL AGREEMENTS)


Treated Timber Curb Item 558 SB 2310+00-2310+00 LT

Drilling And Blasting of Solid Rock Subgrade, Item 115

PROPERTY LINE FENCE WITH STEEL POSTS ITEM 583-1E MOD.		
STA.	STA.	POS.
NORTHBOUND		
2306+00'	2318+00'	RT.
SOUTHBOUND		
RAMP "C" 22+18	RAMP "C" 5+95	RT.

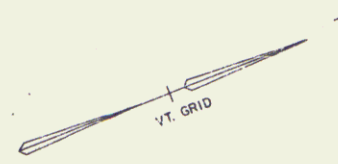


FILL CUT

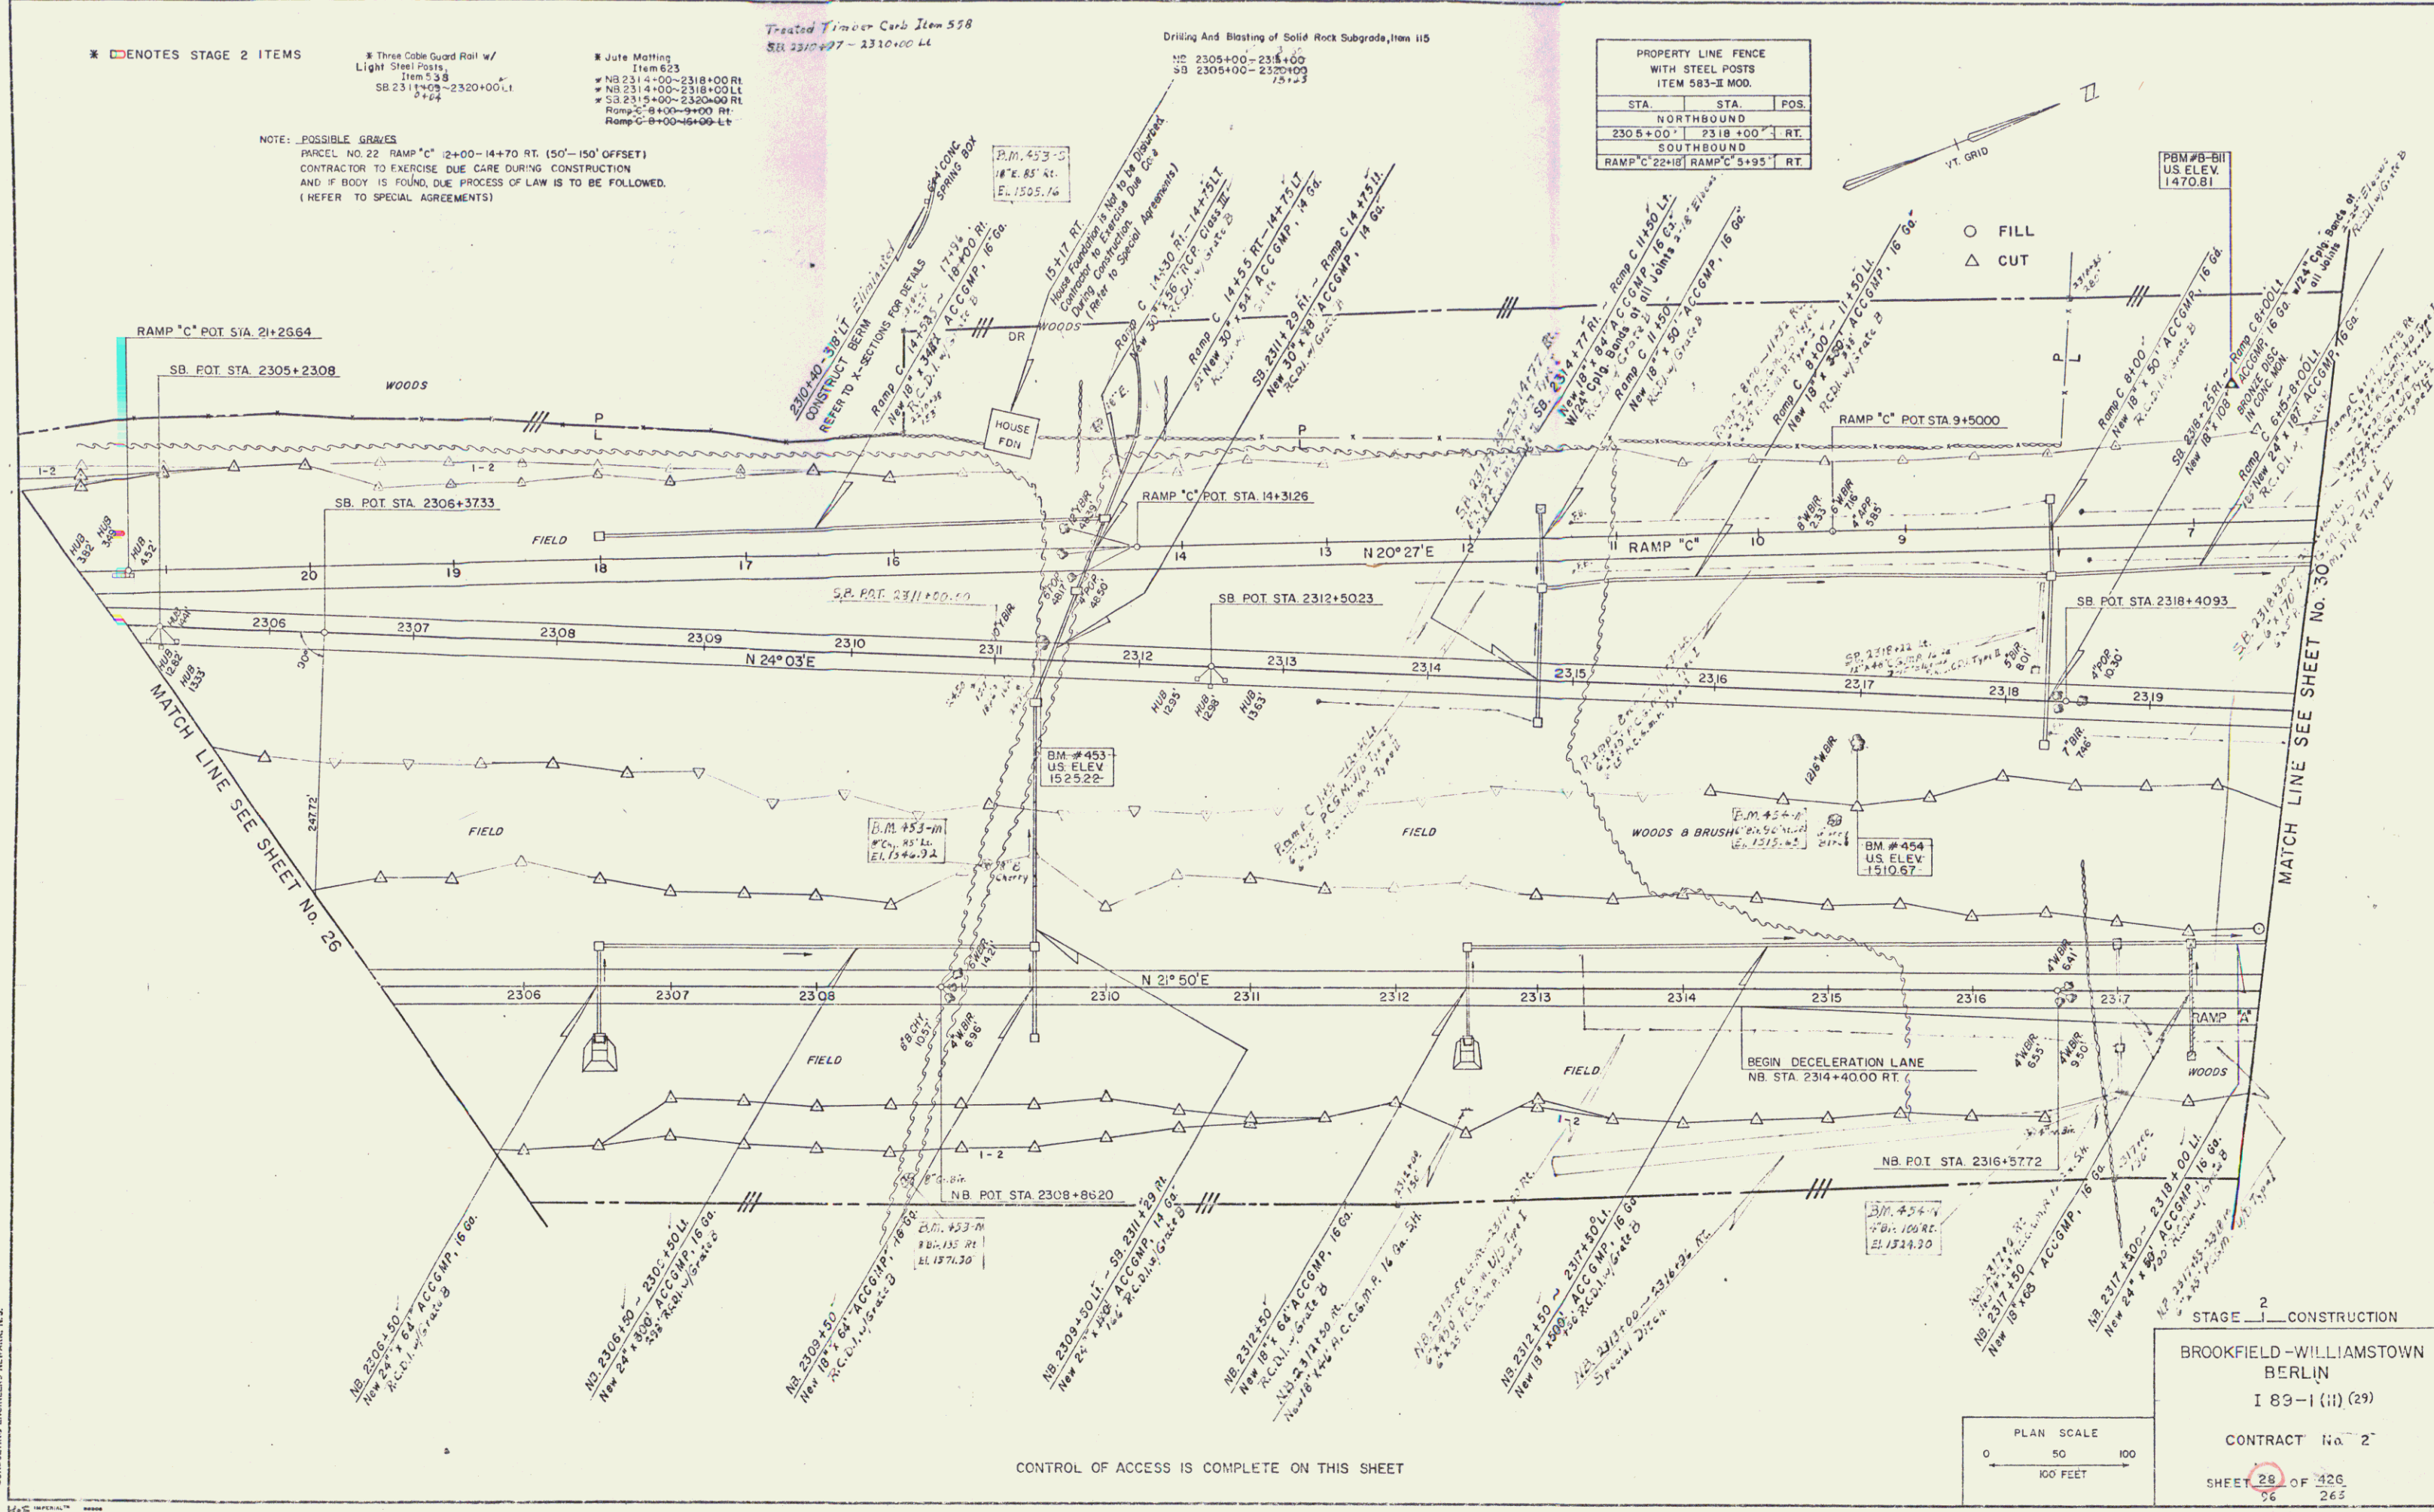

PORTER, O'BRIEN & ARMSTRONG CONSULTING ENGINEERS NEWARK, N.J.

CONTROL OF ACCESS IS COMPLETE ON THIS SHEET

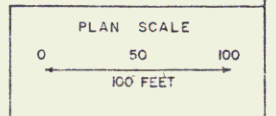

STAGE 2 CONSTRUCTION

BROOKFIELD-WILLIAMSTOWN
BERLIN
I 83-1 (1) (29)

CONTRACT No. 2

SHEET 28 OF 226
96 263

98