

* DENOTES STAGE 2 ITEMS

Stone Fill For Slope Protection (Heavy Type), Item 511
NB 2334+00-2335+25 RT
SB 2334+00-2335+25 LT

Stone Fill For Slope Protection (Light Type), Item 512
SB 2339+40 RT-2340+70 RT
NB 2339+40-2340+70 LT

Drilling & Blasting of Solid Rock Subgrade, Item 115
NB 2339+00-2340+00
SB 2342+25-2347+00


Three Cable Guard Rail w/ Light Steel Posts, Item 538
NB 2334+00-2339+00 LT
SB 2335+00-2341+00 RT
SB 2344+53-2348+00 LT

Standard Steel Beam Guard Rail w/ Steel Posts (6'-3" Spacing), Item 545-A
NB 2334+00-2338+00 RT
SB 2335+00-2343+00 LT


Tracked Timber Curb, Item 548
SB 2335+00-2342+55 LT
SB 2346+50-2348+00 LT

PROPERTY LINE FENCE WITH STEEL POSTS ITEM 583-Z MOD.		
STA.	STA.	POS.
NORTHBOUND		
2334+00	2348+00	RT.
SOUTHBOUND		
2335+00	2348+00	LT.

Plank Guard Rail, Item 540
SB 2345+75 LT 40LF

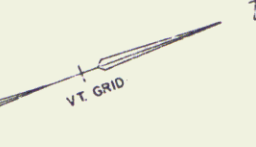

○ FILL
△ CUT

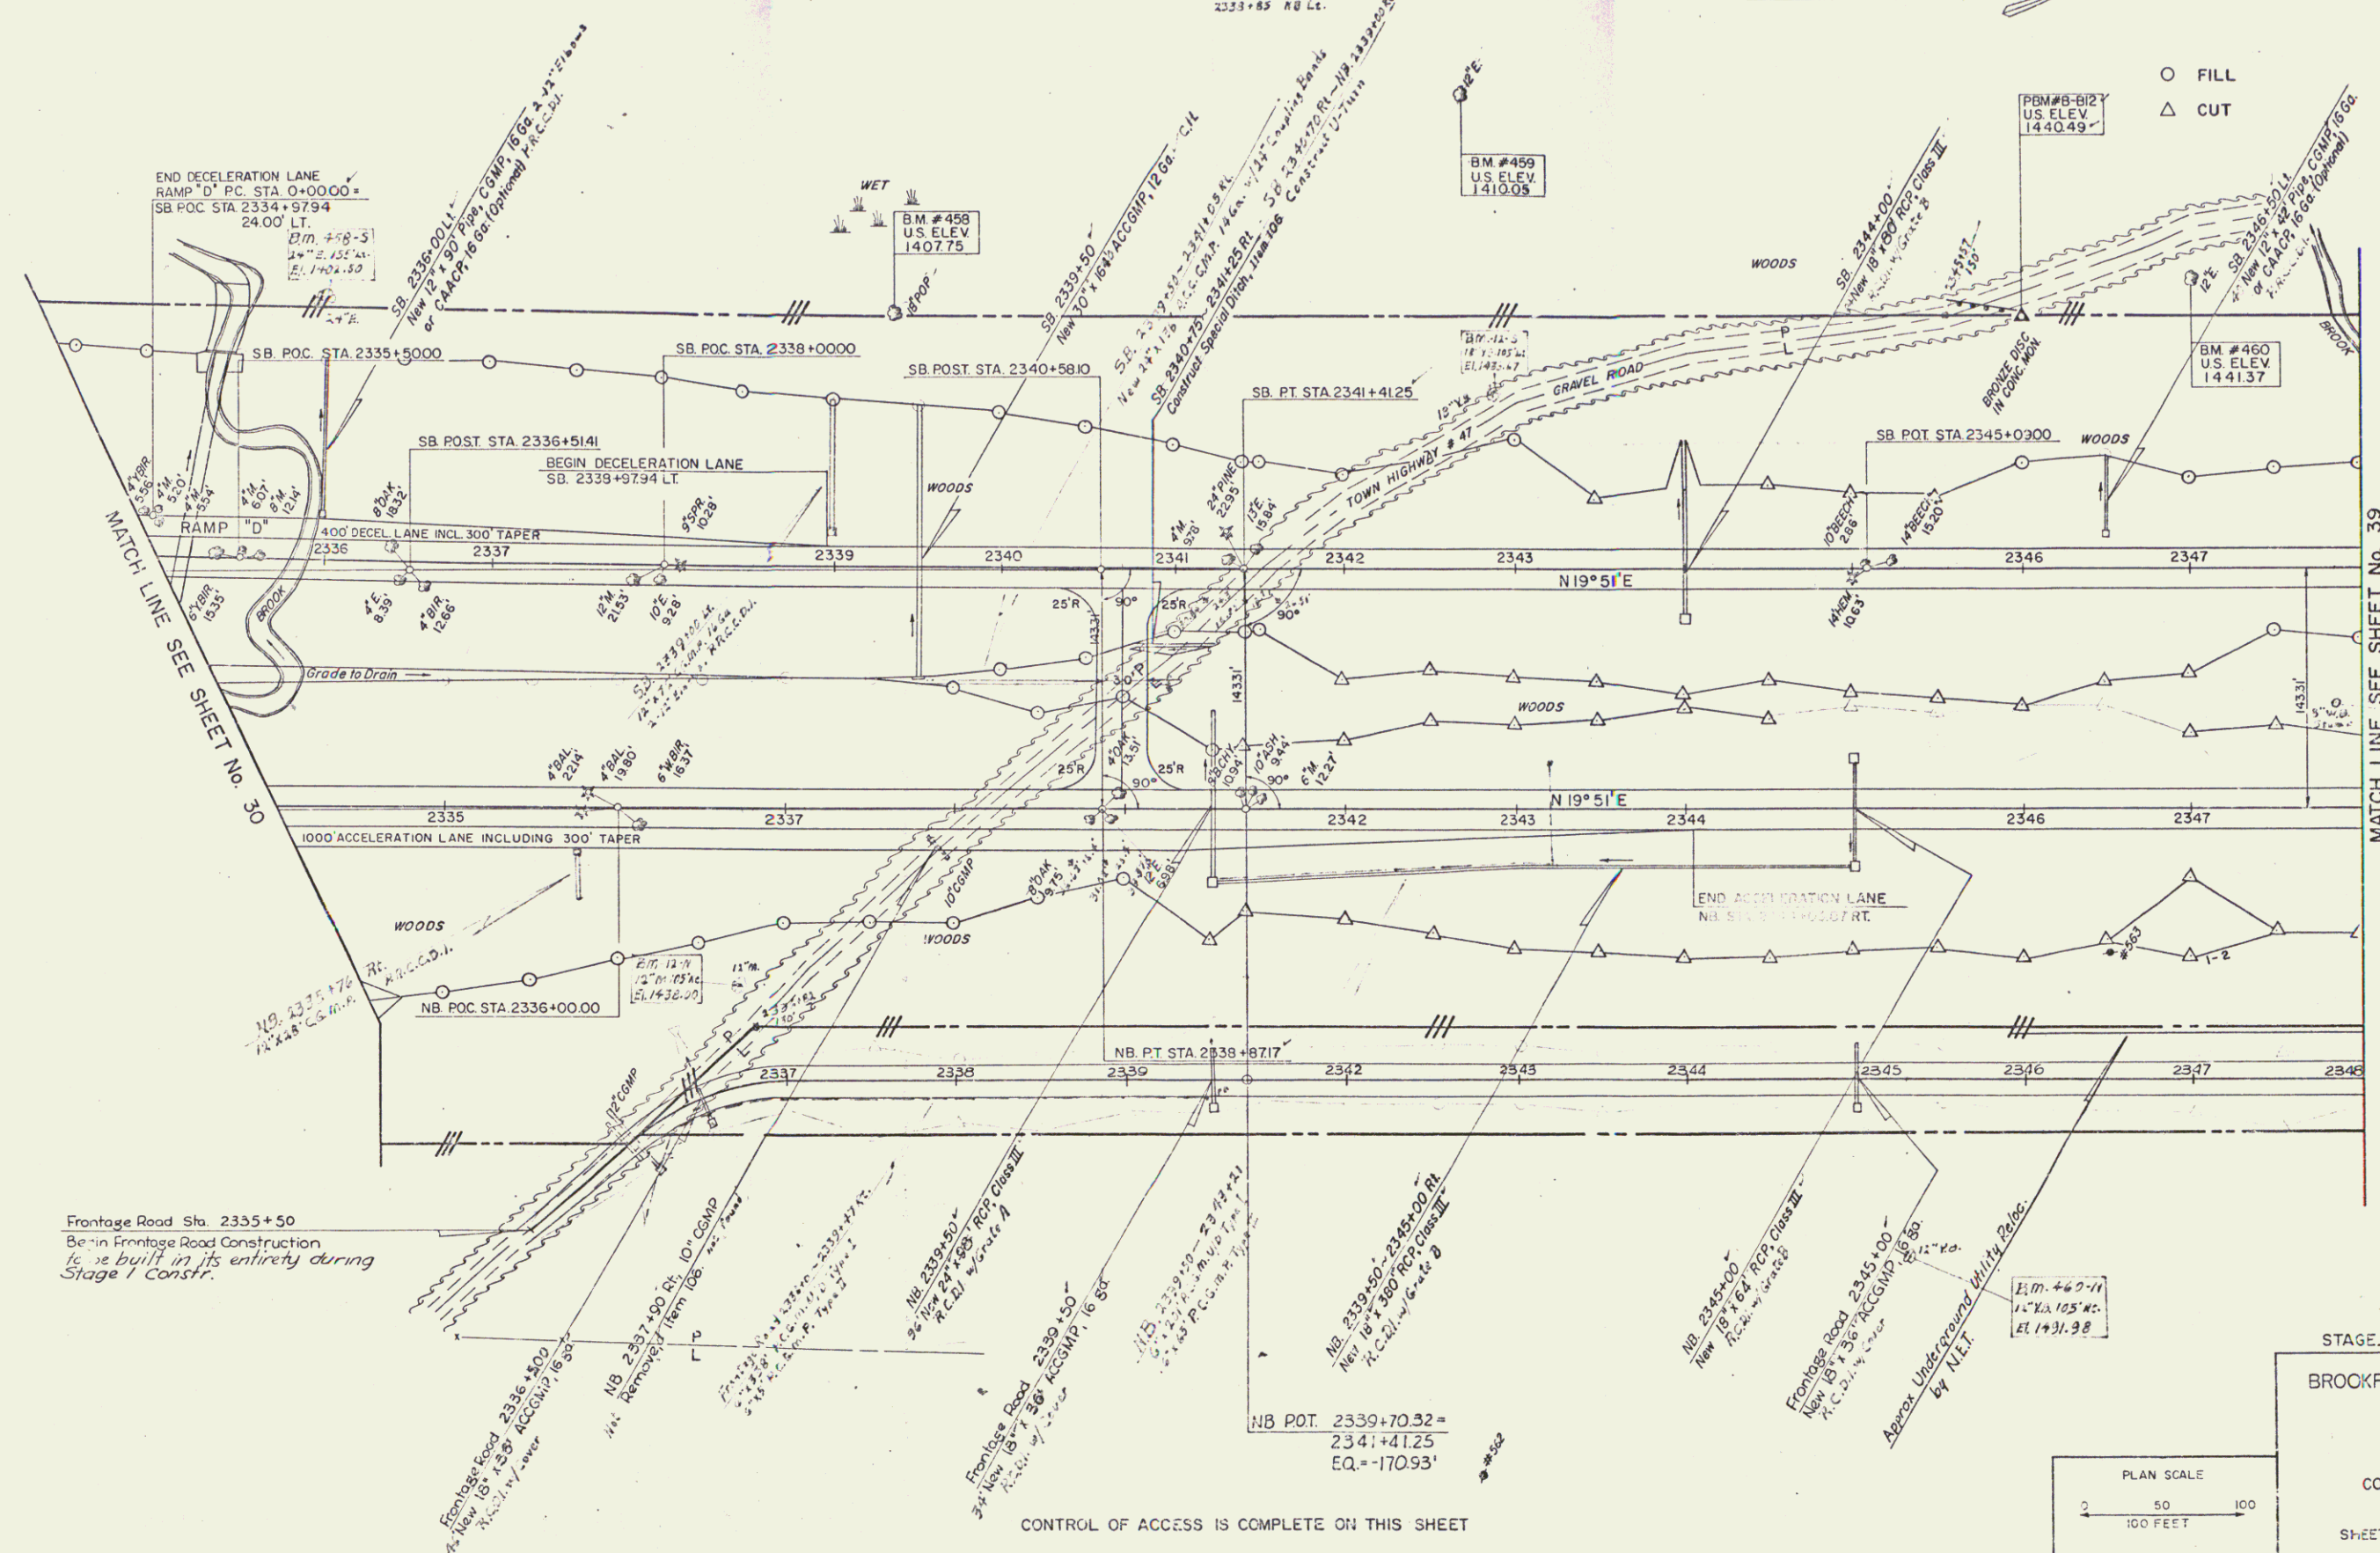


MATCH LINE SEE SHEET No. 30

MATCH LINE SEE SHEET No. 39

Frontage Road Sta. 2335+50
Begin Frontage Road Construction to be built in its entirety during Stage 1 Constr.

CONTROL OF ACCESS IS COMPLETE ON THIS SHEET

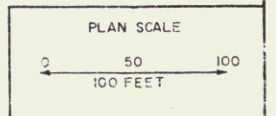

STAGE 2 CONSTRUCTION

BROOKFIELD-WILLIAMSTOWN
BERLIN

I 89-1(11) (29)

CONTRACT No. 2

SHEET 37 OF 426
705 263

PORTER, O'BRIEN & ARMSTRONG
Consulting Engineers
WATERBURY, V.T.

102