

* DENOTES STAGE 2 ITEMS
 Slope Fill For Slope Protection (Light Type) Item 512
 SB 2349+50

* Three Cable Guard Rail w/ Light Steel Posts Item 538
 NB 2348+00-2352+00 LT
 SB 2348+00-2352+00 RT
 SB 2351+02-2355+08 RT

* Treated Timber Curb Item 558
 NB 2348+00-2352+00 LT
 SB 2348+00-2352+00 RT
 SB 2351+02-2355+08 RT

Drilling & Blasting of Solid Rock Subgrade Item 115
 NB 2348+00-2349+00
 NB 2349+00-2350+00
 SB 2357+00-2363+00


Plank Guard Rail Item 540
 NB 2353+66 RT 16 LF
 SB 2353+75 LT 16 LF

Demolition and Disposal of Building Item 506
 NB 2354+06 RT
 NB 2355+02 RT

* Jute Matting Item 623
 NB 2357+00-2358+00 RT
 NB 2357+00-2358+00 LT

PROPERTY LINE FENCE WITH STEEL POSTS ITEM 583-I MOD		
STA.	STA.	POS.
NORTHBOUND		
2348+00	2363+00	RT
SOUTHBOUND		
2348+00	2363+00	LT

○ FILL
 △ CUT

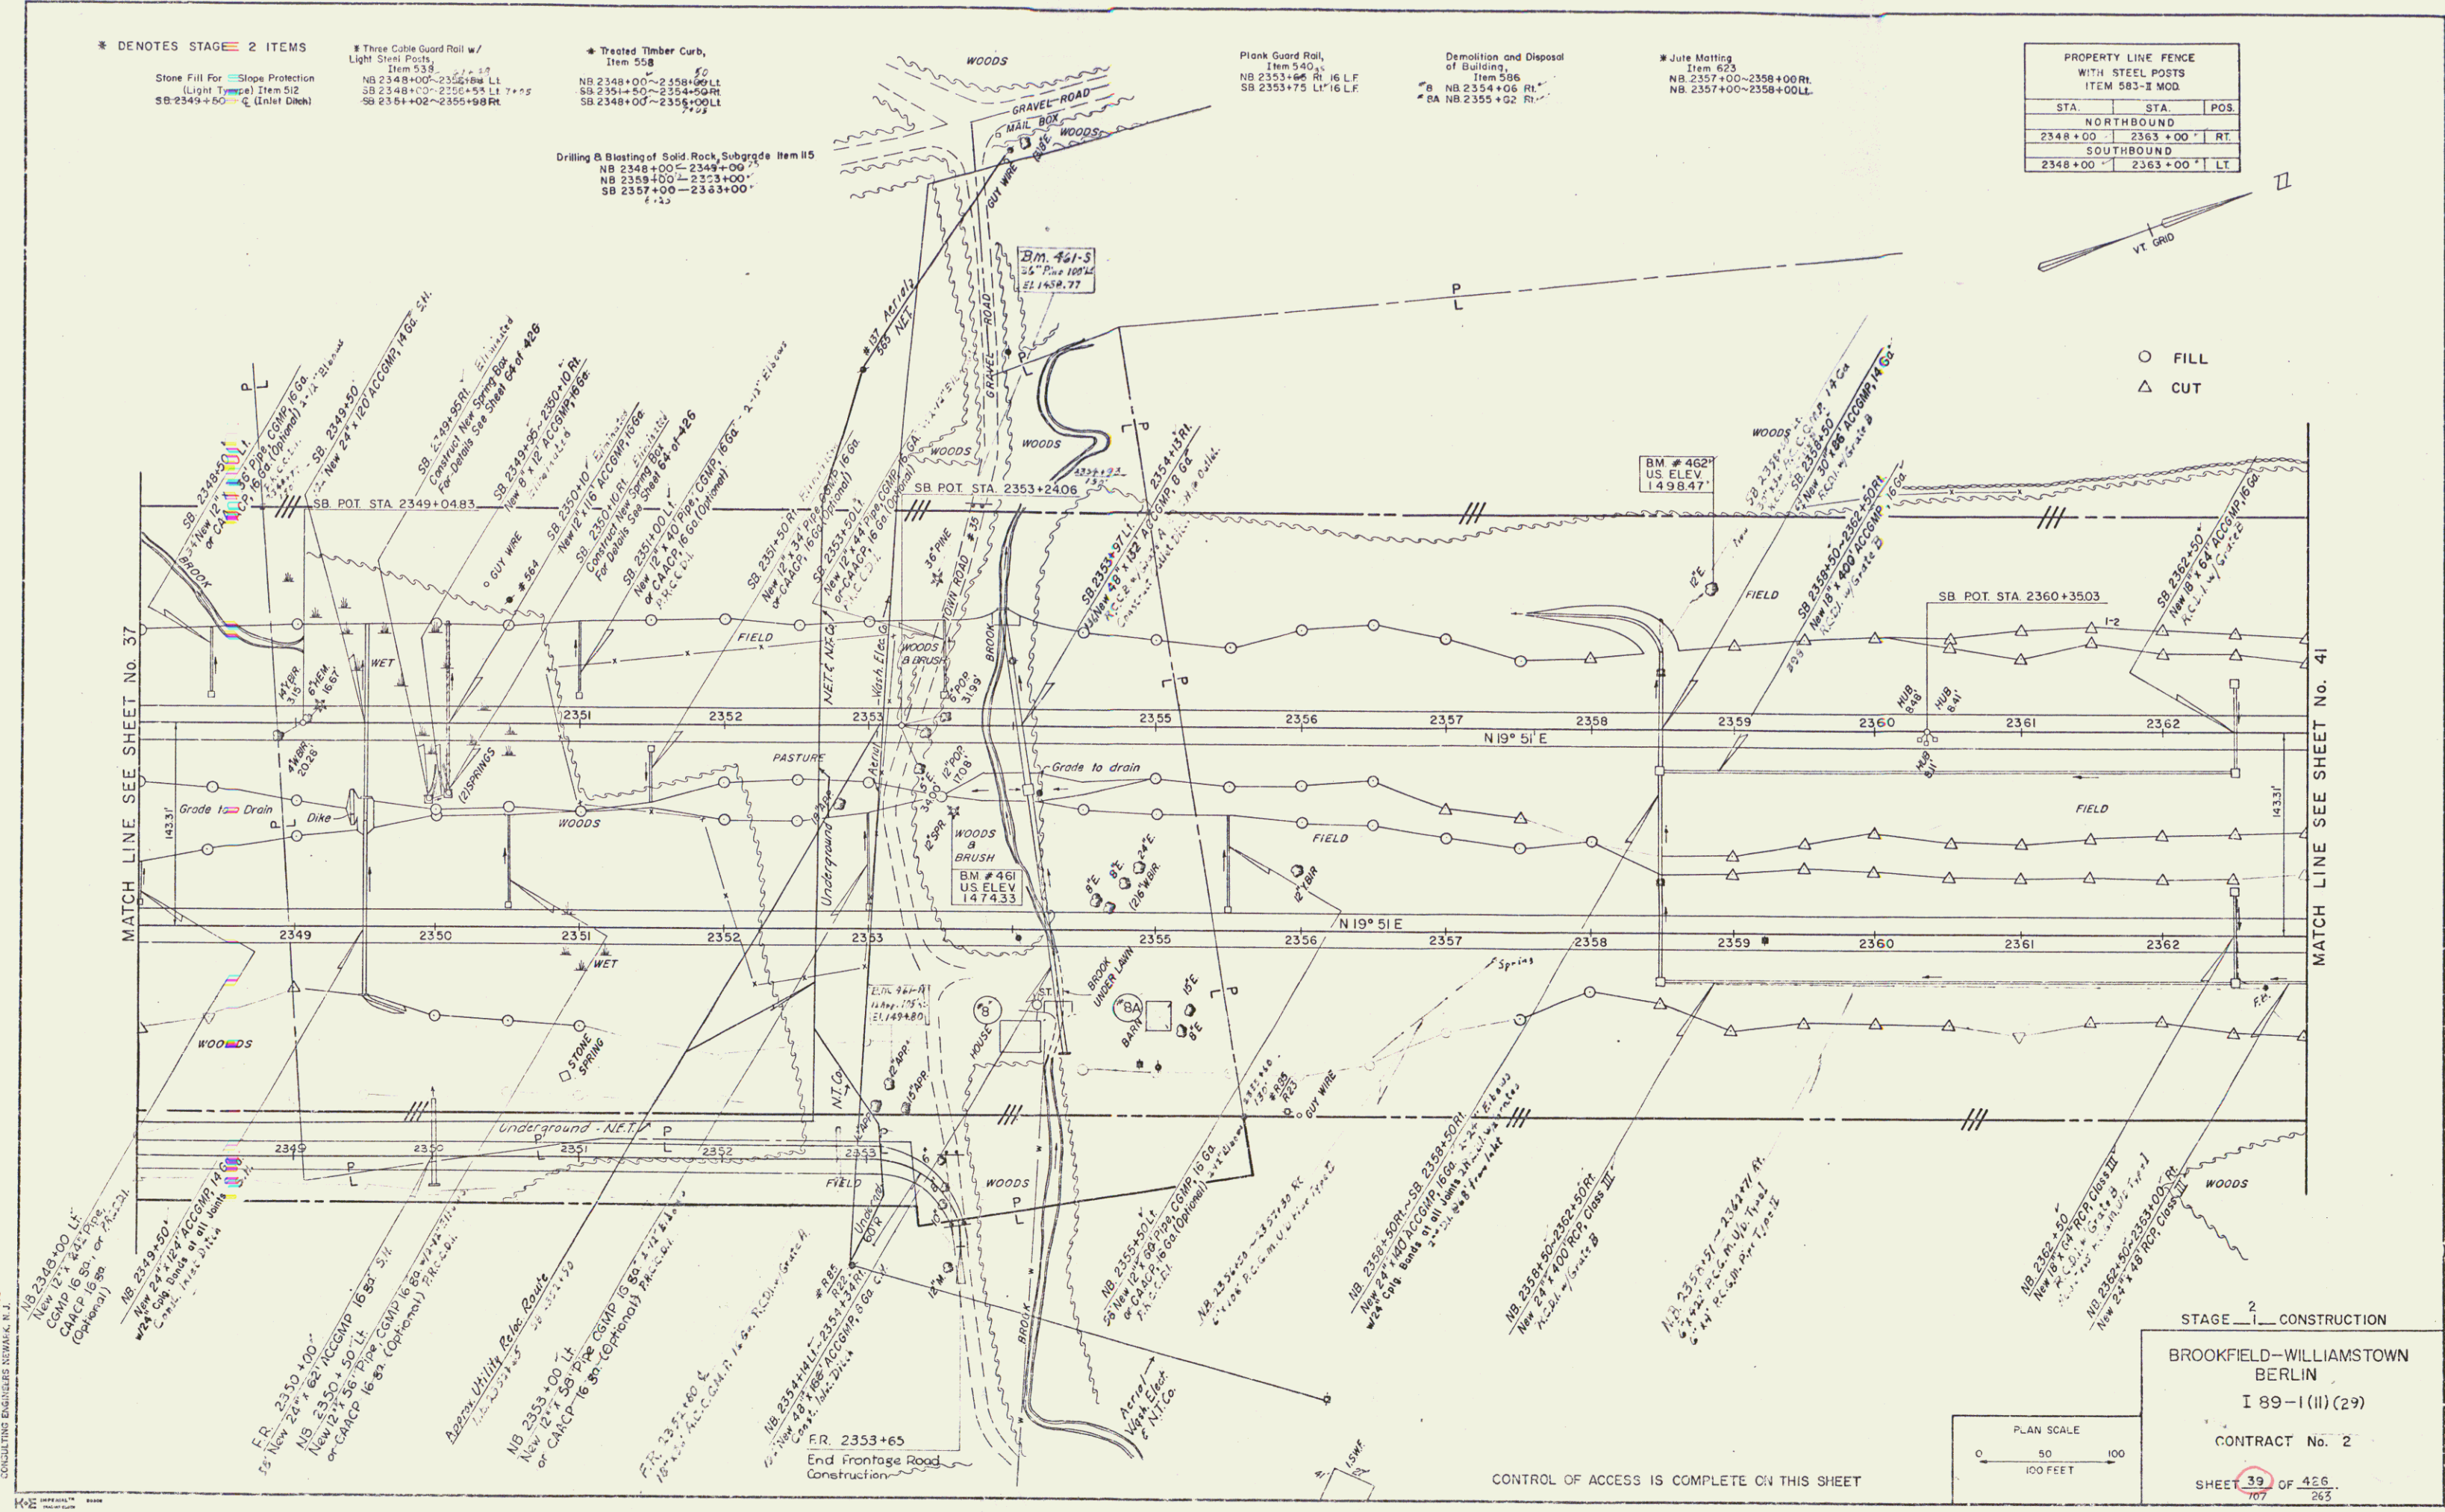

POSTER, OBRIEN & MINTON
 CONSULTING ENGINEERS NEWARK, N.J.

STAGE 2 CONSTRUCTION

BROOKFIELD-WILLIAMSTOWN
 BERLIN
 I 89-1 (II) (29)

CONTRACT No. 2

SHEET 39 OF 426



CONTROL OF ACCESS IS COMPLETE ON THIS SHEET