

DENOTES STAGE 2 ITEMS
 Stone Fill For Slope Protection
 (List Item 52)
 NB 2373+00 RT (Inlet Ditch)



Standard Steel Beam Guard Rail
 w/ Steel Posts (6'-3" Spacing)
 Item 545-A
 NB 2374+00 ~ 2377+00 LT
 SB 2374+50 ~ 2378+00 LL

Treated Timber Curb,
 Item 558
 NB 2376+00 ~ 2378+00 LT

Drilling & Blasting of Solid Rock Subgrade, Item 115
 NB 2363+00 ~ 2372+00
 NB 2373+00 ~ 2377+25
 SB 2363+00 ~ 2377+00

Drilling & Blasting of Solid Rock, Item 114
 2375+00 ~ 2378+00
 2'


PROPERTY LINE FENCE WITH STEEL POSTS ITEM 583-II MOD.		
STA	STA	POS.
NORTHBOUND		
2363+00	2378+00	RT
SOUTHBOUND		
2363+00	2378+00	LT

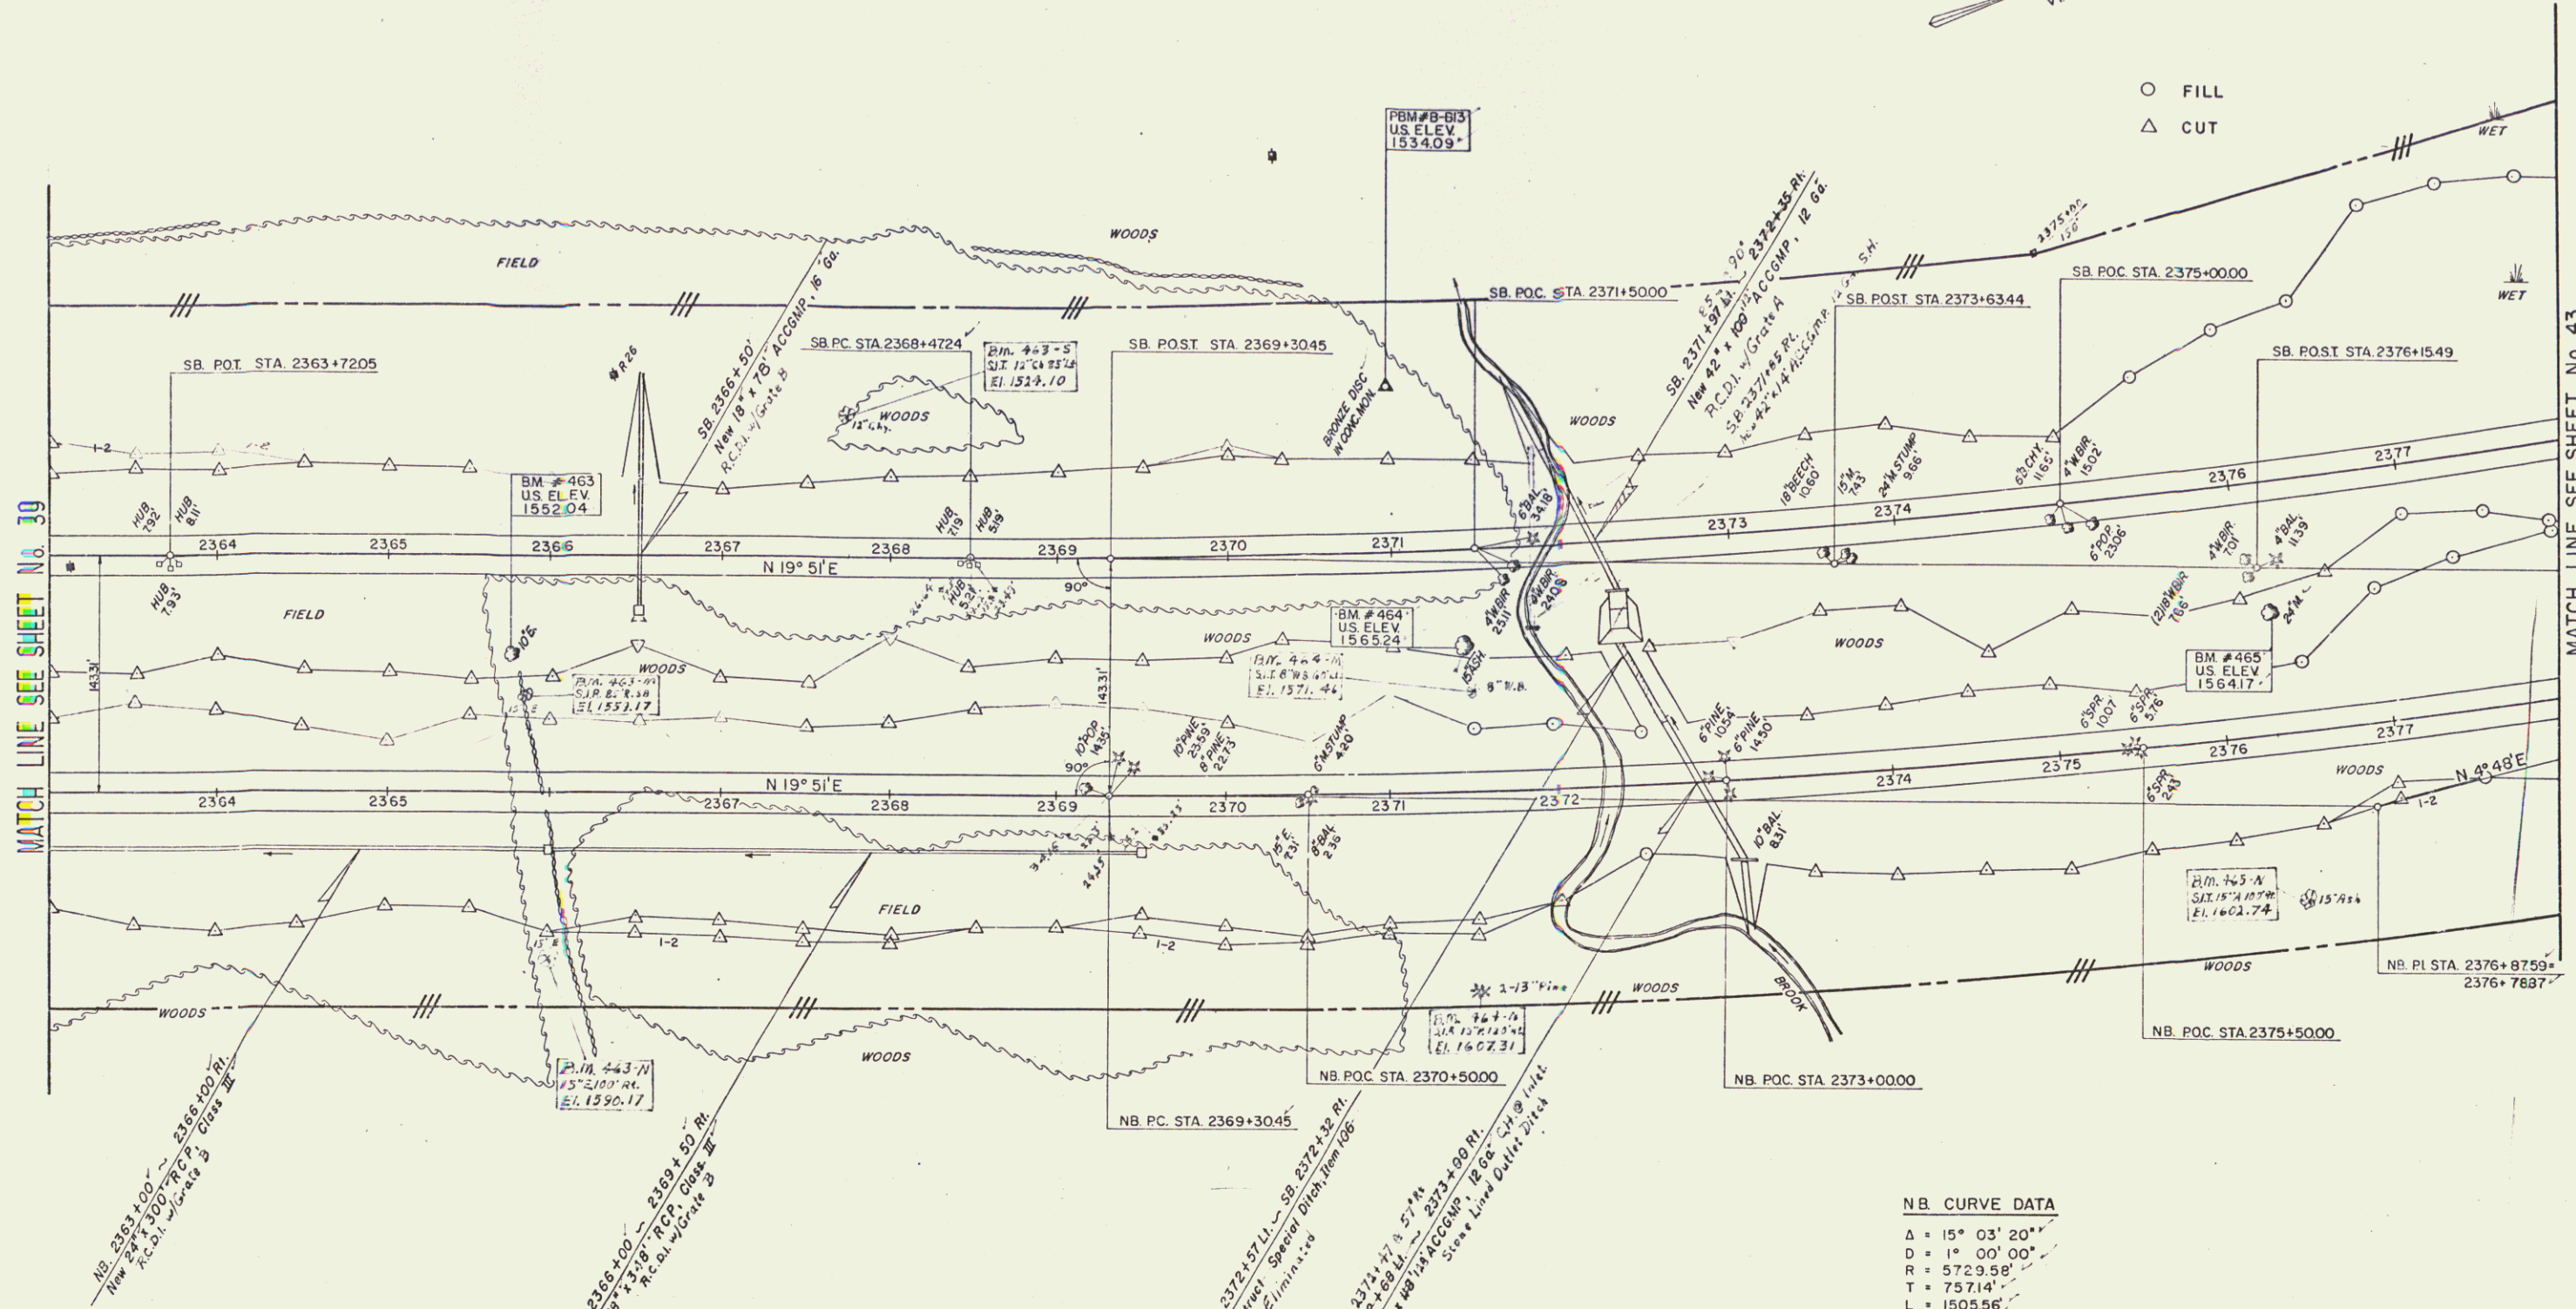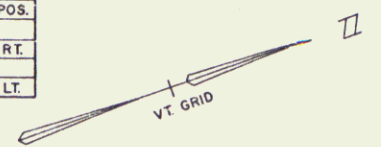

MATCH LINE SEE SHEET No. 39

MATCH LINE SEE SHEET No. 43

N.B. CURVE DATA
 Δ = 15° 03' 20"
 D = 1° 00' 00"
 R = 572.958'
 T = 757.14'
 L = 1505.56'
 E = 498'
 Bank = 5/16' Per Ft.

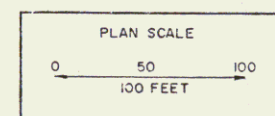

STAGE 2 CONSTRUCTION
 BROOKFIELD-WILLIAMSTOWN
 BERLIN
 I 89-1 (III) (29)
 CONTRACT No. 2
 SHEET 41 OF 426
 169 265

CONTROL OF ACCESS IS COMPLETE ON THIS SHEET

PORTER, O'BRIEN & ARMSTRONG
 Consulting Engineers, P.A.

104