


■ DENOTES STAGE 2 ITEMS

Standard Steel Beam Guard Rail w/ Steel Posts (8'-3" Spacing) Item 545-A NB 2378+00-2388+00 LT SB 2378+00-2383+00 LT
Treated Timber Curb, Item 558 NB 2378+00-2384+50 LT

Drilling & Blasting of Solid Rock, Item 114 2376+00-2379+50


Drilling & Blasting of Solid Rock Subgrade, Item 115 NB 2384+00-2393+00 LT SB 2385+00-2393+00 LT

PROPERTY LINE FENCE WITH STEEL POSTS ITEM 583-2 MOD		
STA.	STA.	POS.
NORTHBOUND		
2378+00	2393+00	RT.
SOUTHBOUND		
2376+00	2393+00	LT.

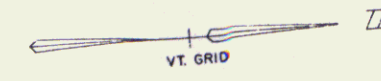


○ FILL
△ CUT

S.B. CURVE DATA
 Δ = 19° 40' 30"
 D = 18° 00' 00"
 R = 5729.58'
 T = 993.53'
 L = 1967.50'
 E = 85.50'
 Bank = 5/16" Per Ft

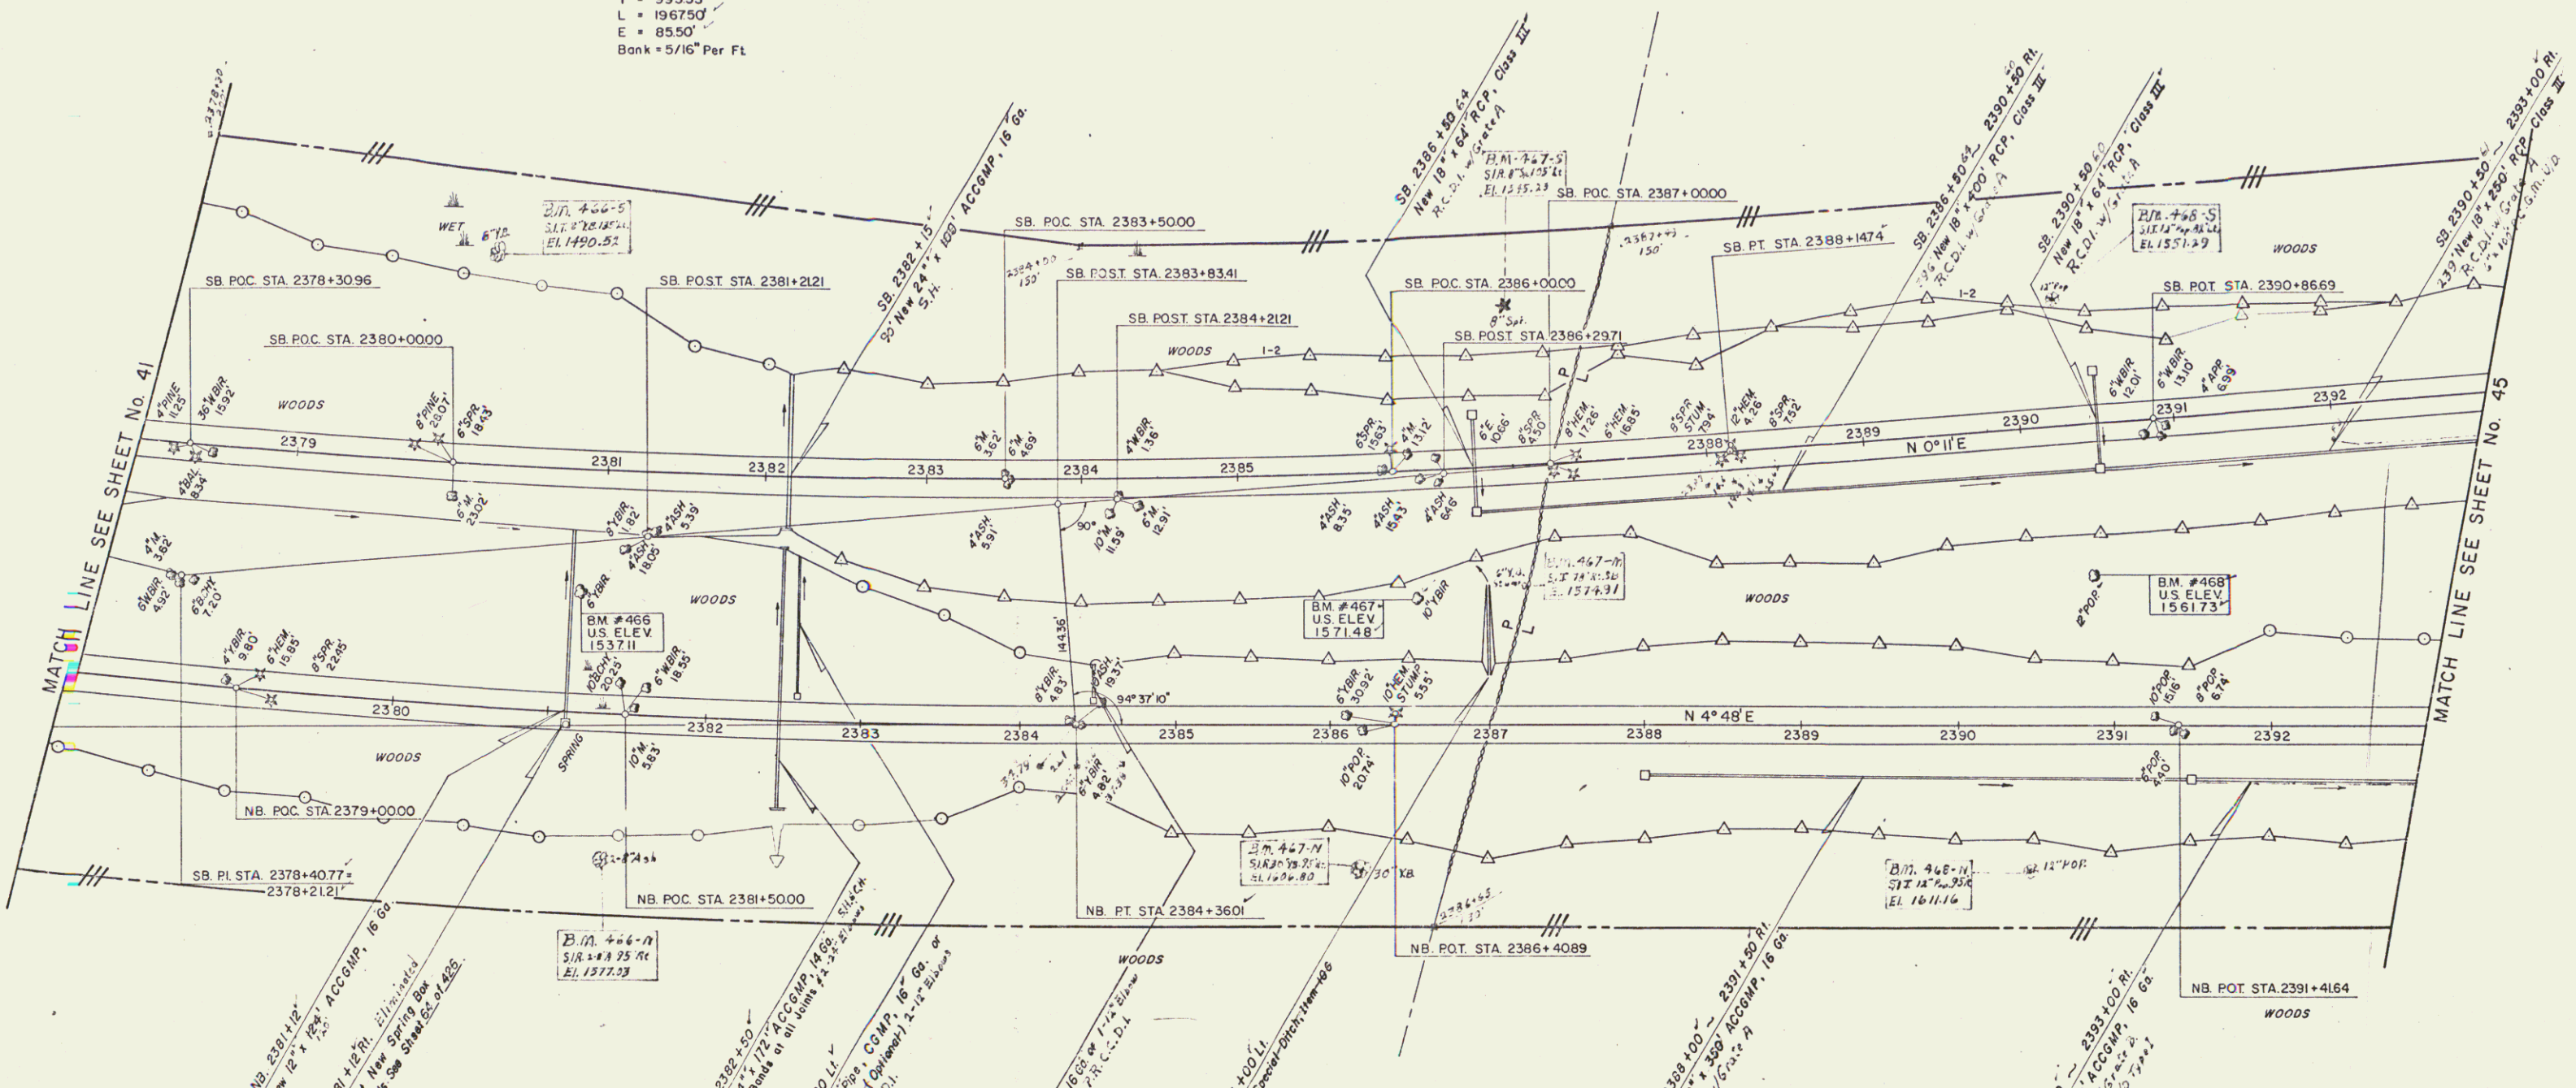

PORTER, GRIFFIN & ALMSTEDT
CONSULTING ENGINEERS NEWARK, N.J.

CONTROL OF ACCESS IS COMPLETE ON THIS SHEET

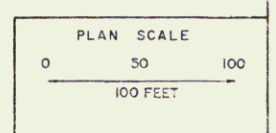

STAGE 2 CONSTRUCTION
 BROOKFIELD-WILLIAMSTOWN
 BERLIN
 I 89-1 (II) (29)
 CONTRACT No. 2
 SHEET 43 OF 426
 263

105