



* DENOTES STAGE 2 ITEMS

* Standard Steel Beam Guard Rail w/ Steel Posts (6-3 Spacing) Item 543-A
NB. 2397+48 ~ 2408+00 Lt.
SB. 2394+42 ~ 2408+00 Lt.

* Three Cable Guard Rail w/ Light Steel Posts Item 538
SB 2396+95 ~ 2404+02 Rt.


Drilling & Blasting of Solid Rock Subgrade, Item 115
N.B. 2393+00 ~ 2398+45
S.B. 2393+00 ~ 2398+45
S.B. 2405+25 ~ 2408+00

PROPERTY LINE FENCE WITH STEEL POSTS ITEM 583-I MOD.		
STA	STA	POS.
NORTHBOUND		
2393+00	2408+00	RT
SOUTHBOUND		
2393+00	2408+00	LT

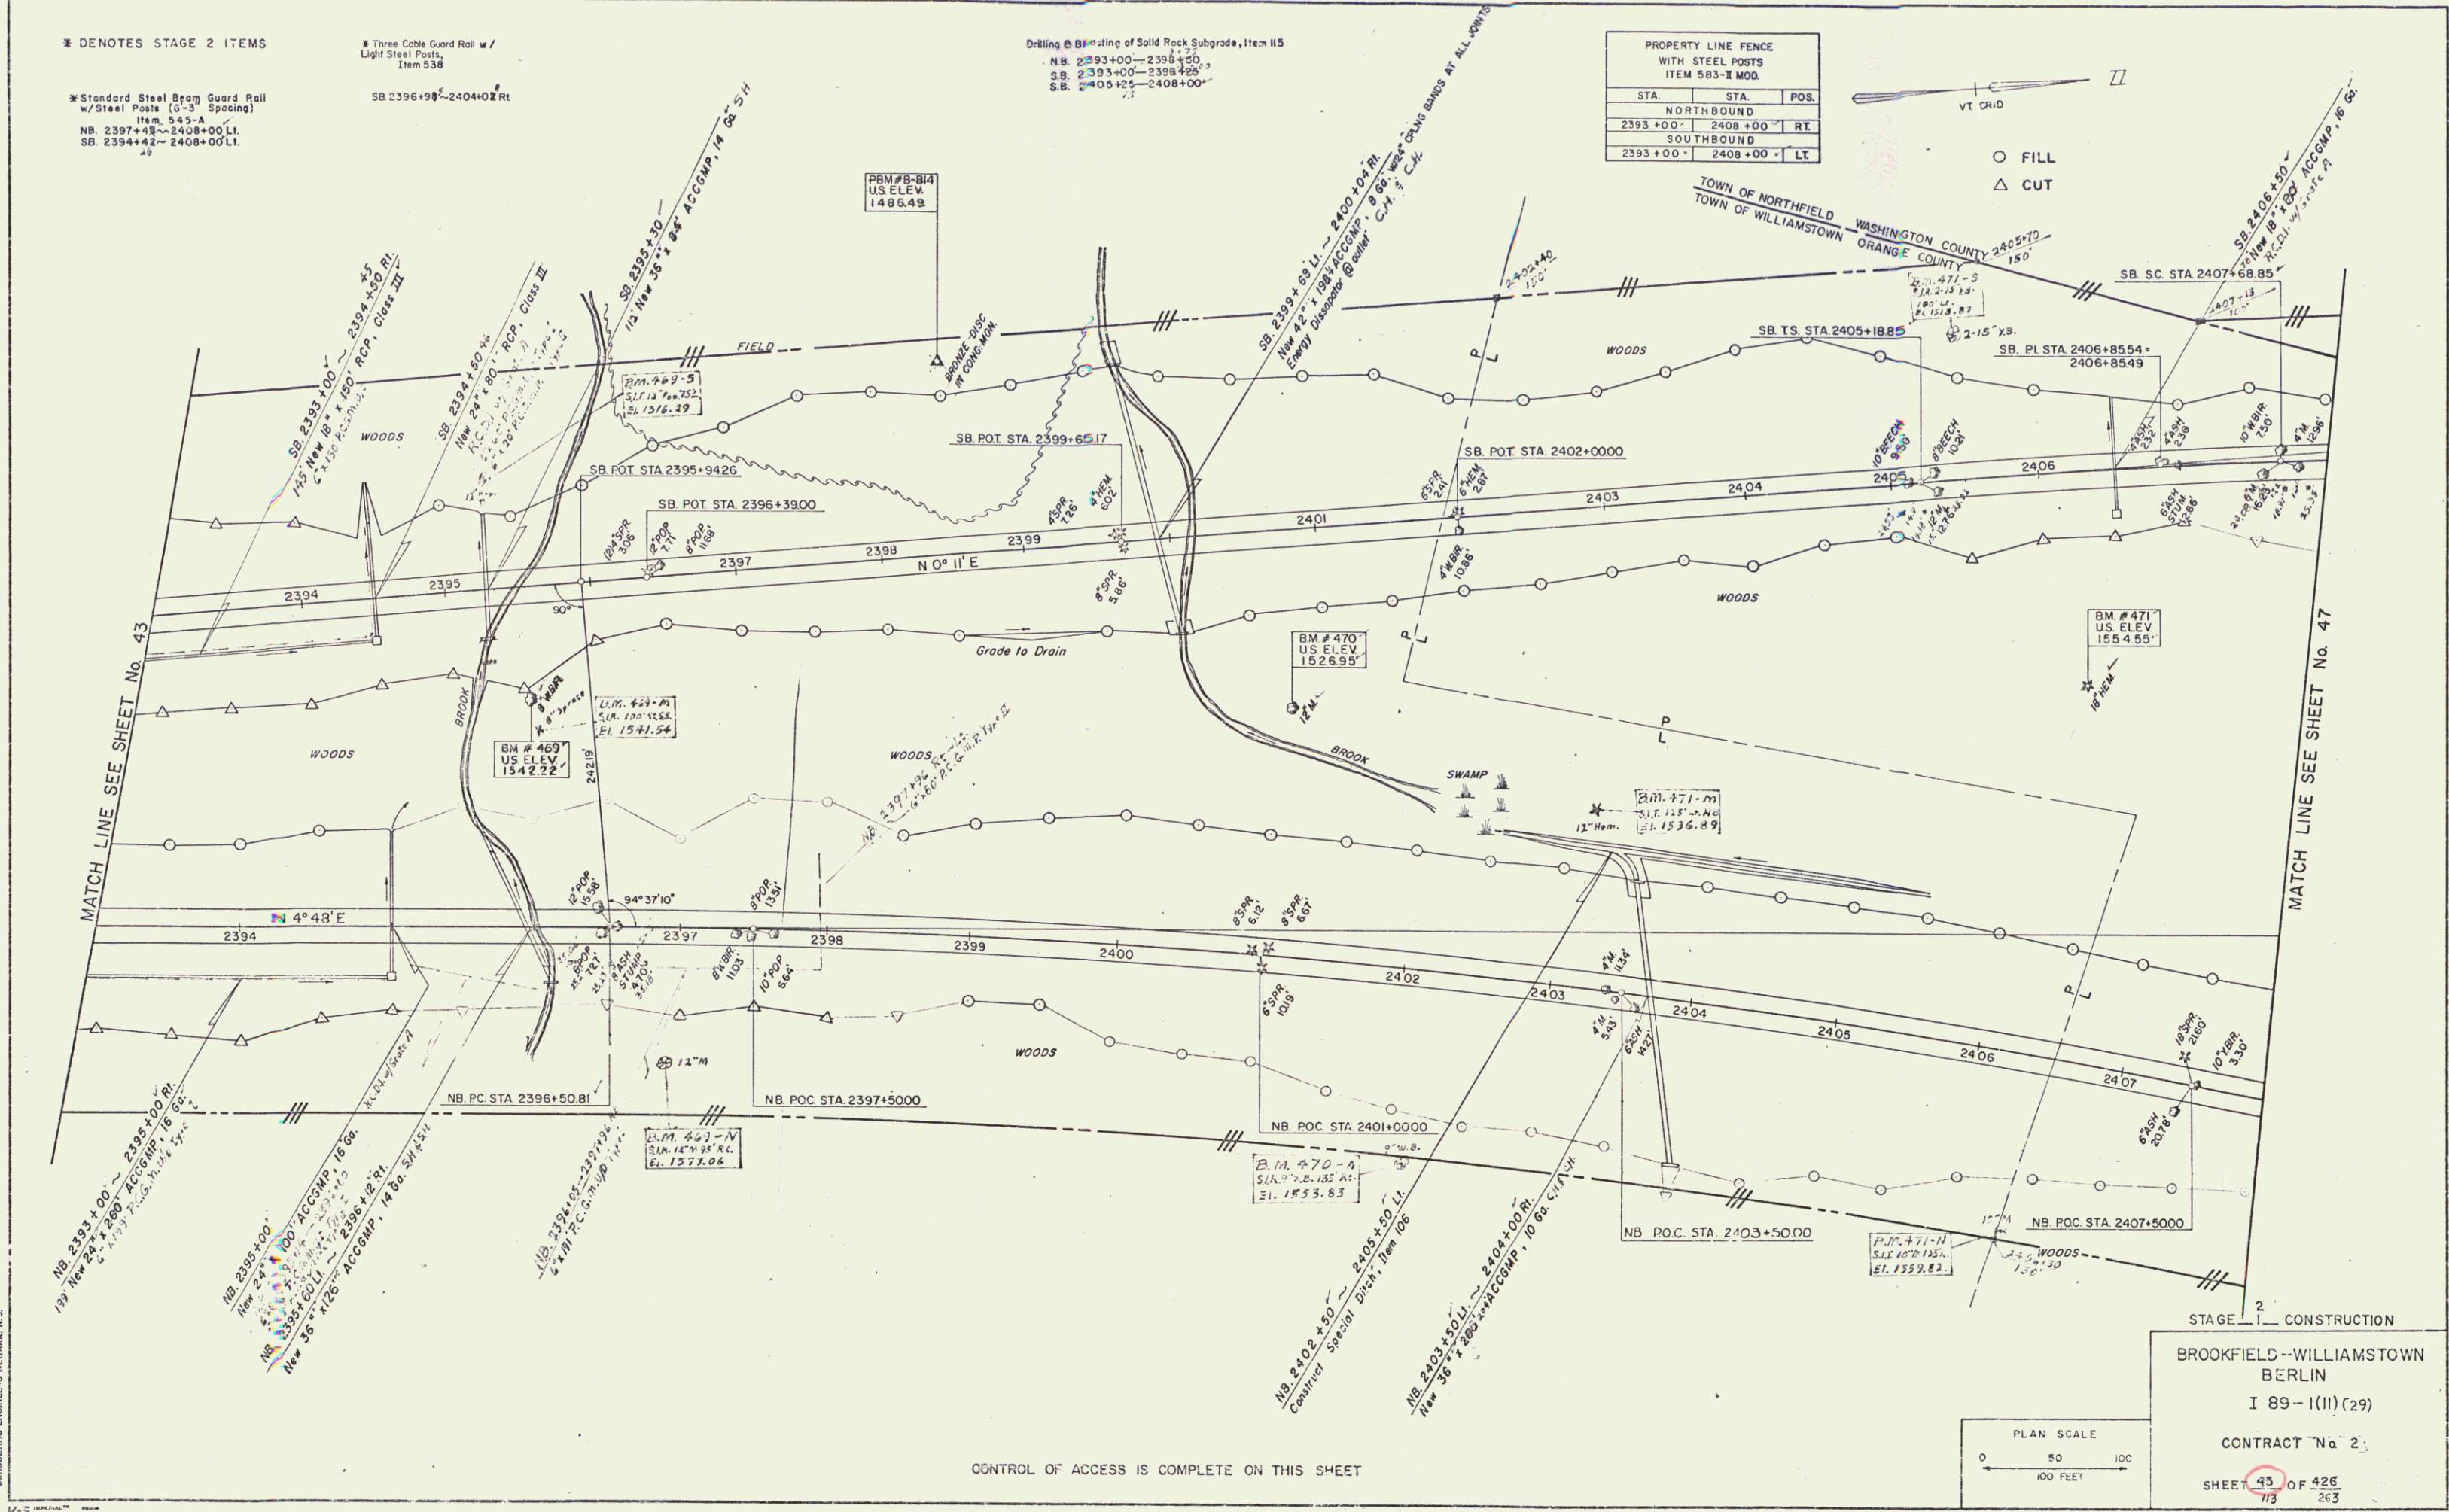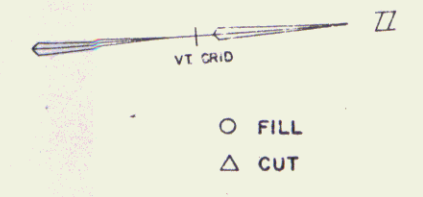

PORTER, O'BRIEN & ARMSTRONG
CONSULTING ENGINEERS NEWARK, N.J.

CONTROL OF ACCESS IS COMPLETE ON THIS SHEET

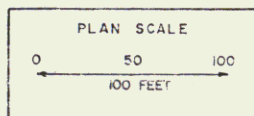

STAGE 2 CONSTRUCTION

BROOKFIELD-WILLIAMSTOWN
BERLIN
I 89-1(II) (29)
CONTRACT No. 2
SHEET 45 OF 426
113 263

106