

★ DENOTES STAGE 2 ITEMS

★ Three Cable Guard Rail w/  
Light Steel Posts  
Item 538  
SB 2451+00~2453+00 LT  
NB 2451+68~2452+00 RT


★ Treated Timber Curb,  
Item 539  
NB 2445+00~2452+00 LT  
S-1-7

★ Standard Steel Beam Guard Rail  
w/ Steel Posts (6'-3" Spacing)  
Item 535-A  
NB 2437+00~2438+23 Lt.  
NB 2453+30~2452+00 Lt.  
SB 2438+00~2447+24 Lt.


Drilling & Blasting of Solid Rock Subgrade, Item 115  
NB 2437+00~2448+75  
SB 2438+00~2452+50  
1-1-2

Drilling & Blasting of Solid Rock, Item 114  
NB 2449+25~2452+50'

PROPERTY LINE FENCE WITH STEEL POSTS ITEM 535-E MOD		
STA.	STA.	POS.
2437+00'	2452+00'	RT
SOUTHBOUND		
2438+00'	2453+00'	LT

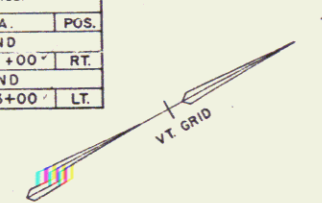

○ FILL  
△ CUT

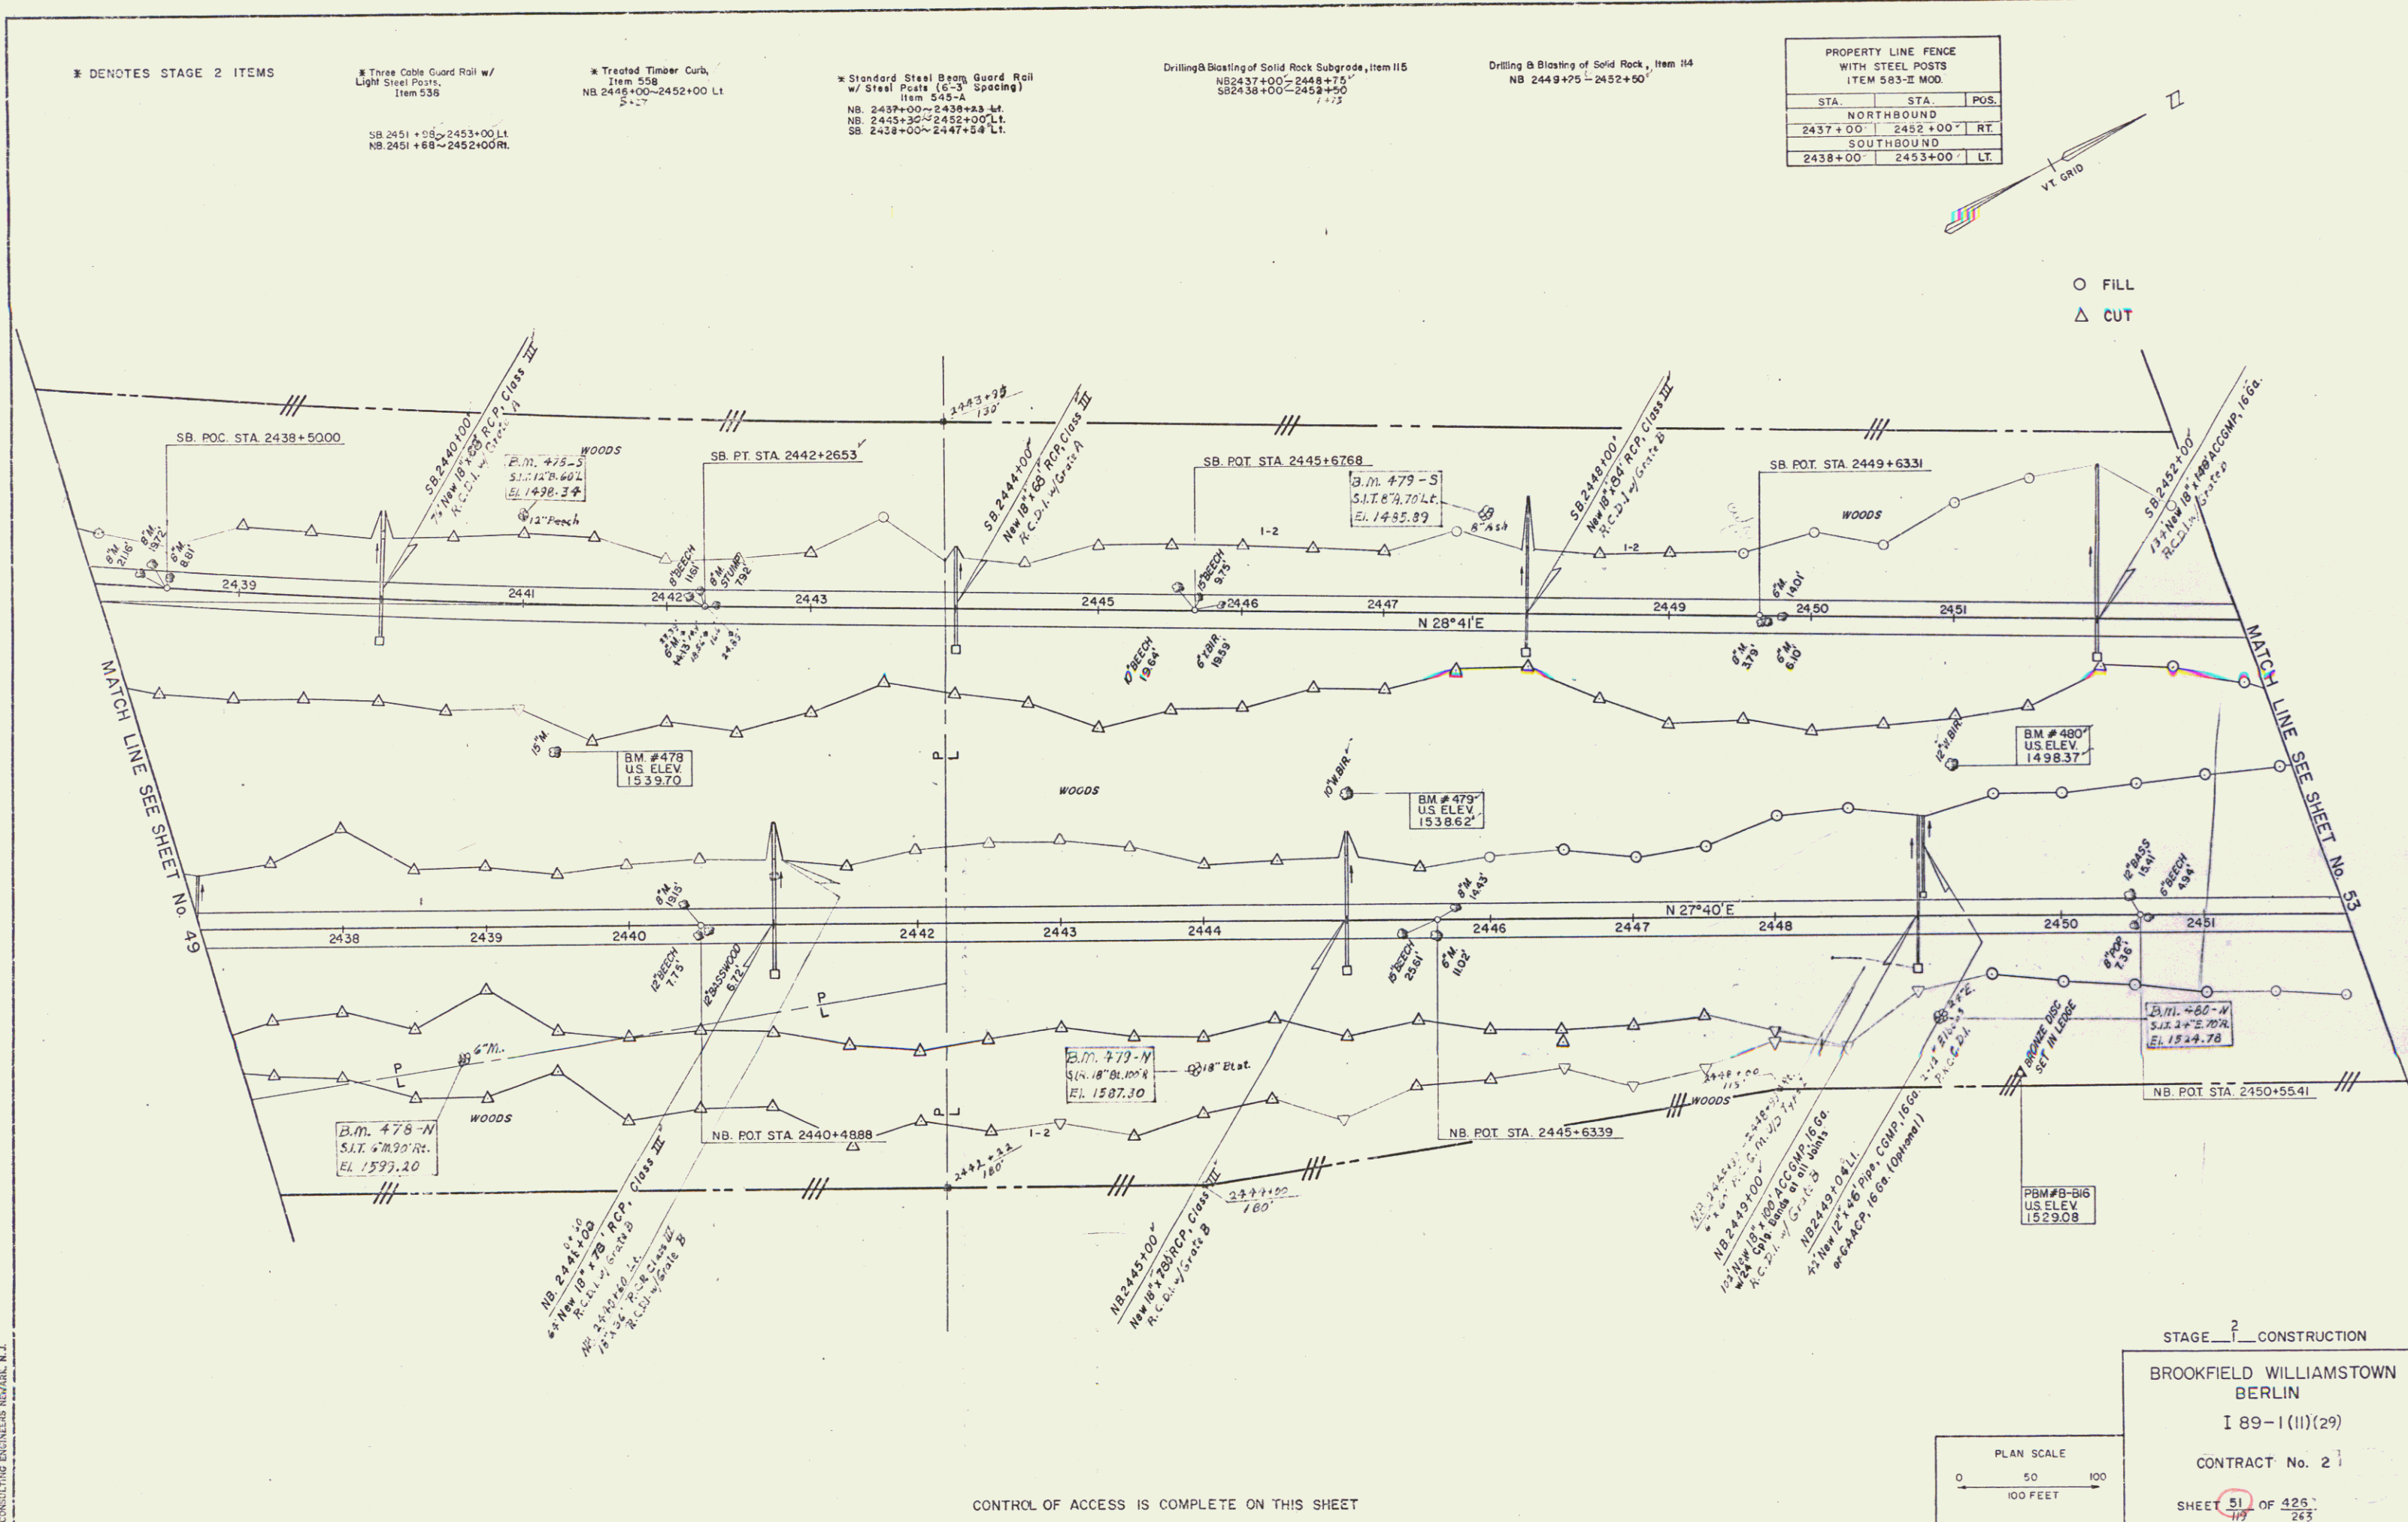

PORTER, ORRIBEN & ARMSTRONG  
CONSULTING ENGINEERS NEWARK, N. J.

CONTROL OF ACCESS IS COMPLETE ON THIS SHEET

STAGE 2 CONSTRUCTION

BROOKFIELD WILLIAMSTOWN  
BERLIN  
I 89-1(11)(29)

CONTRACT No. 21

SHEET 51 OF 126