

* DENOTES STAGE 2 ITEMS


Three Cable Guard Rail w/
Light Steel Posts,
Item 538
NB 2452+00-2461+00 Rt
SB 2452+00-2467+00 Lt

Treated Timber Curt,
Item 538
NB 2452+00-2461+00 Rt
SB 2452+00-2467+00 Lt


Standard Steel Beam Guard Rail
w/ Steel Posts (6'-3" Spacing)
Item 545-A
NB 2452+00-2467+00 Lt

Drilling & Blasting of Solid Rock Subgrade, Item 115
SB 2468+25-2468+00

PROPERTY LINE FENCE WITH STEEL POSTS ITEM 503-E MOD.			
STA.	STA.	POS.	
NORTHBOUND			
2452+00	2467+00	RT	
SOUTHBOUND			
2453+00	2468+00	LT	

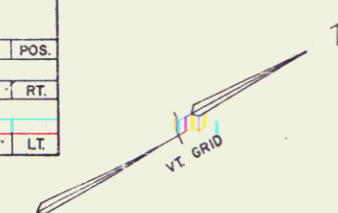


○ FILL
△ CUT

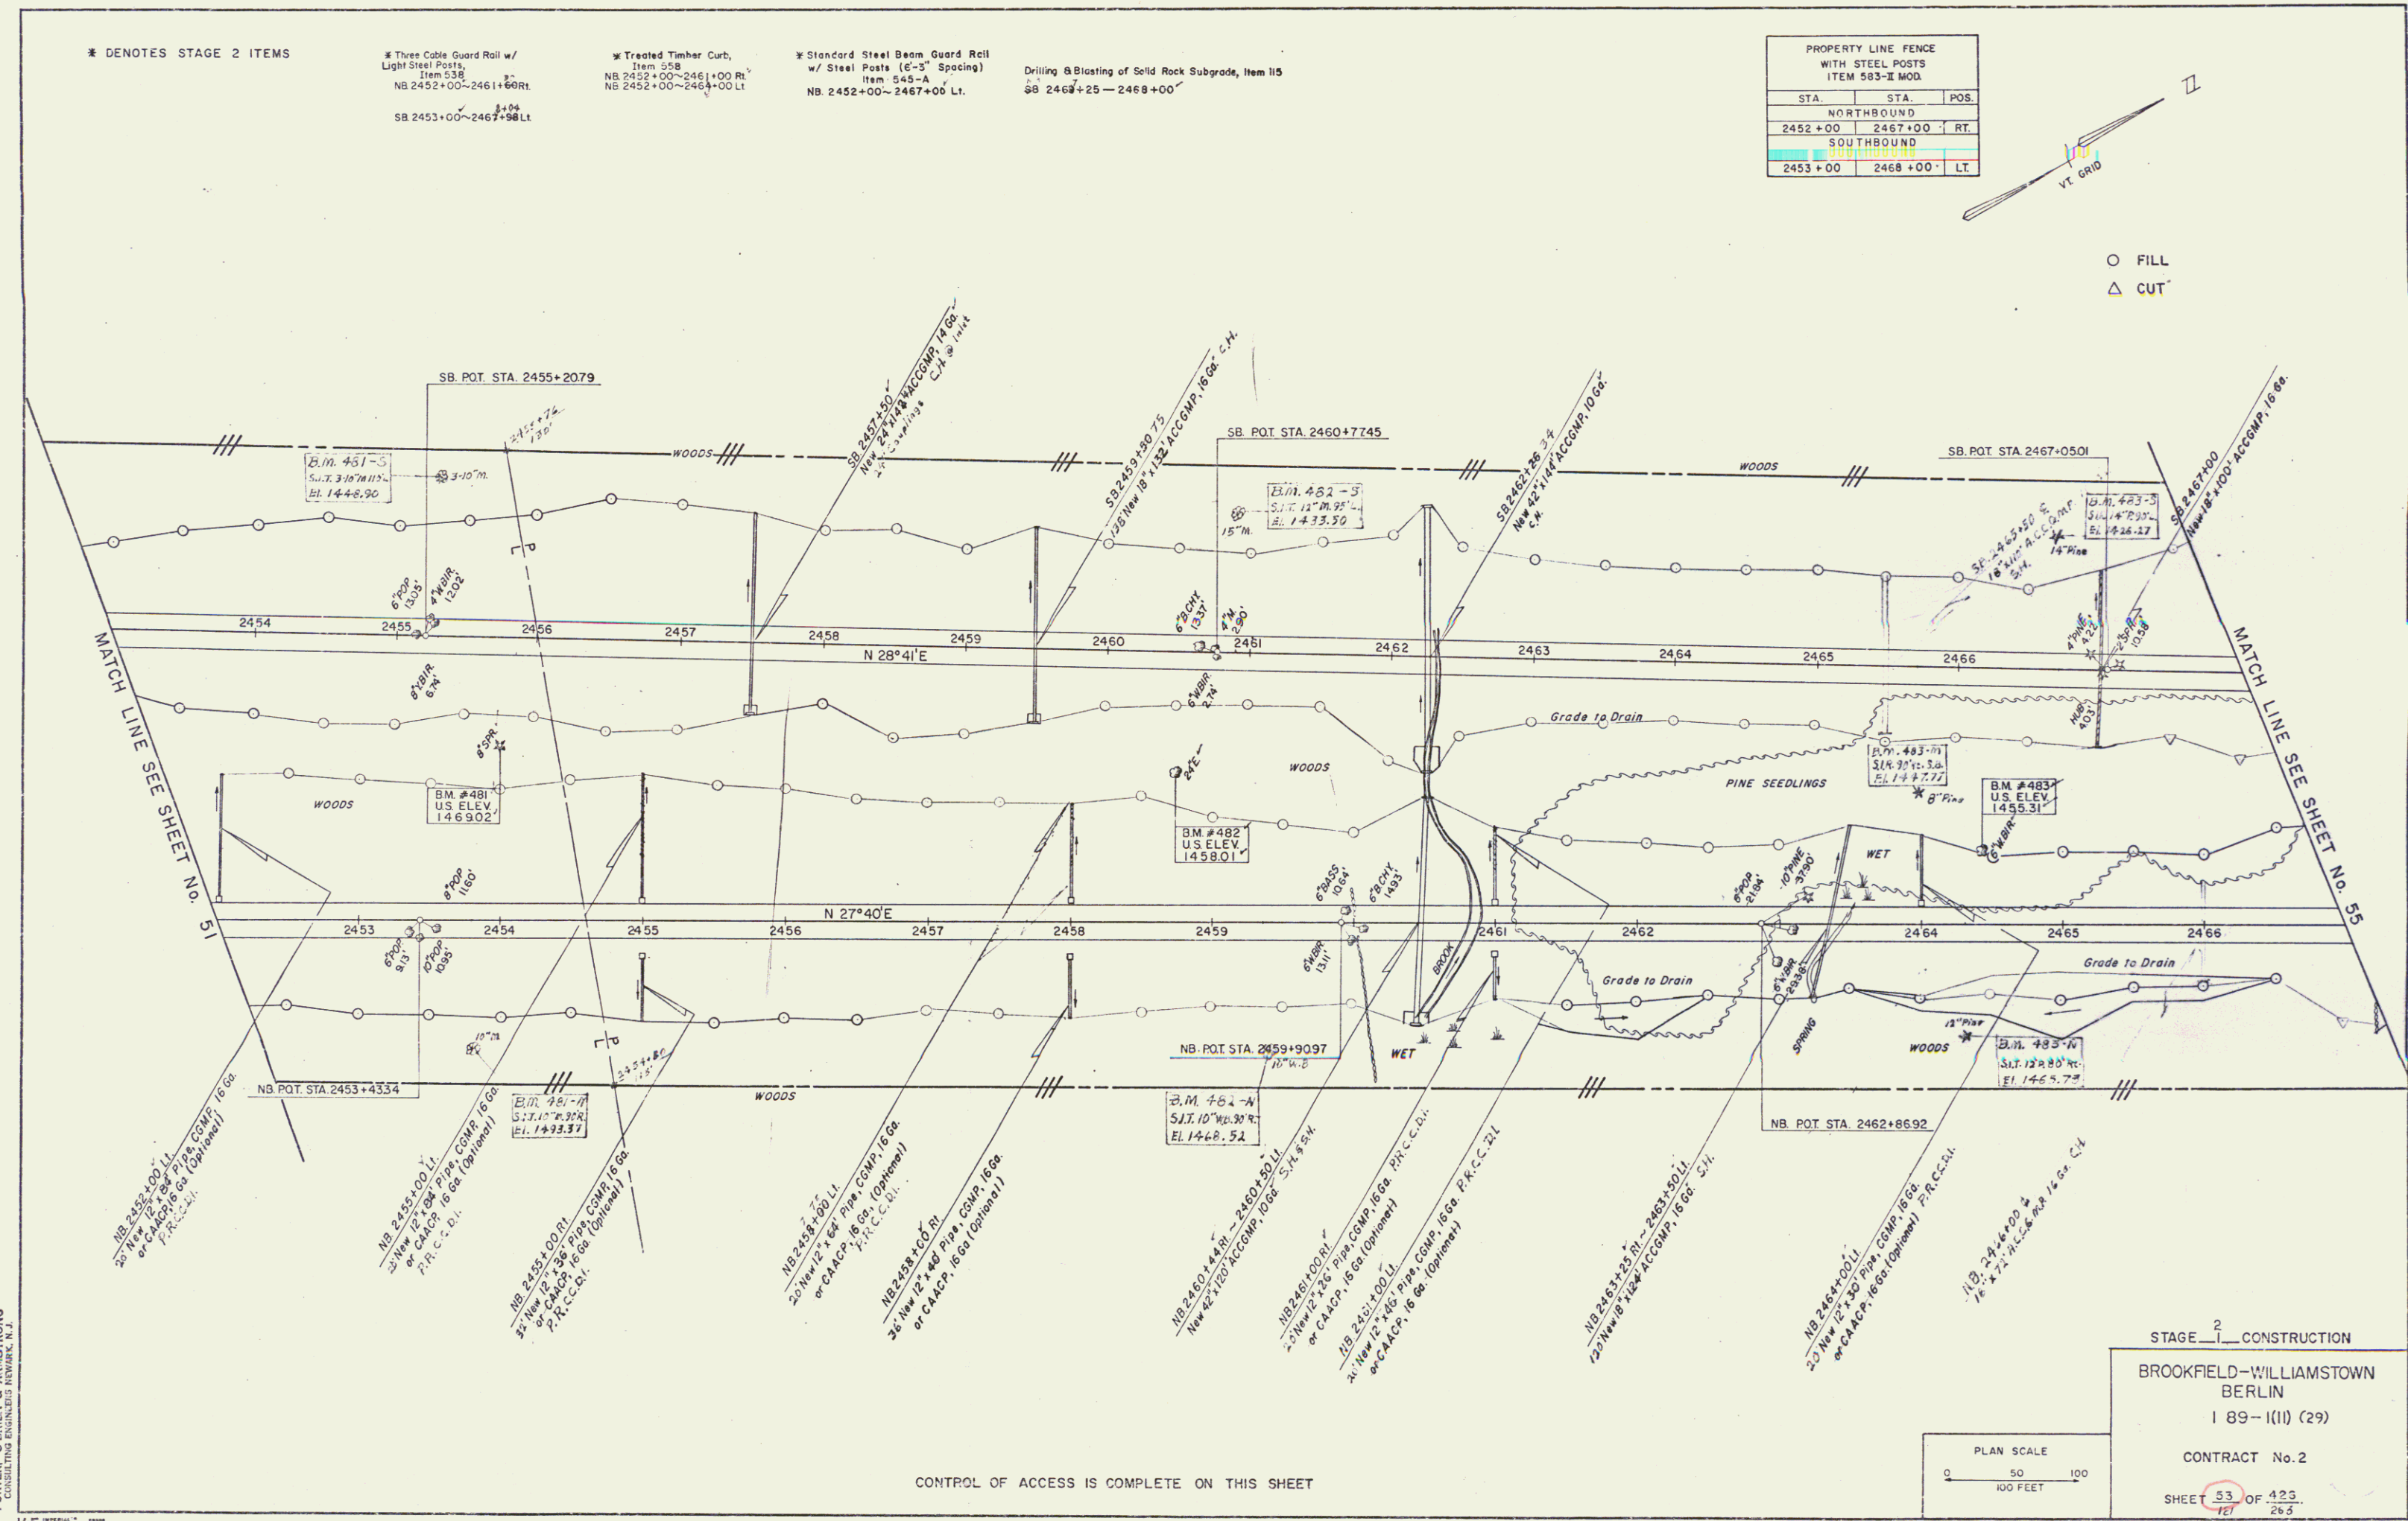

PORTER, CURELL & ARNOLD
CONSULTING ENGINEERS, NEWARK, N.J.

CONTROL OF ACCESS IS COMPLETE ON THIS SHEET

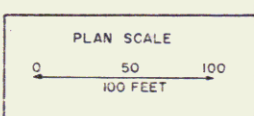

STAGE 2 CONSTRUCTION
 BROOKFIELD-WILLIAMSTOWN
 BERLIN
 1 89-1(11) (29)
 CONTRACT No. 2
 SHEET 53 OF 123
 263