

★ DENOTES STAGE 2 ITEMS

★ Standard Steel Beam Guard Rail
w/ Steel Posts (6'-3" Spacing)
Item 545-A
NB 2467+00~2467+05 Lt.

★ Three Cable Guard Rail/
Light Steel Posts
Item 536
NB 2473+50~2482+00 Lt.
SB 2474+50~2484+00 Lt.


★ Jute Matting
Item 623
SB 2469+00~2470+00 Rt.
SB 2469+00~2470+00 Lt.

Plank Guard Rail,
Item 540
NB 2478+70 Rt. 40 L.F.


Drilling & Blasting of Solid Rock Subgrade Item 115
NB 2467+00 - 2473+25
SB 2469+25 - 2473+75
SB 2473+75 - 2484+00
SB 2483+25 - 2484+00

Drilling & Blasting of Solid Rock, Item 114
SB 2483+25 - 2484+00

PROPERTY LINE FENCE WITH STEEL POSTS ITEM 583-III MOD.		
STA.	STA.	POS.
NORTH BOUND		
2467+00	2482+00	RT.
SOUTHBOUND		
2468+00	2484+00	LT.

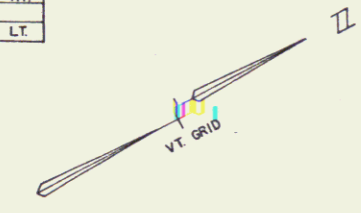


○ FILL
△ CUT

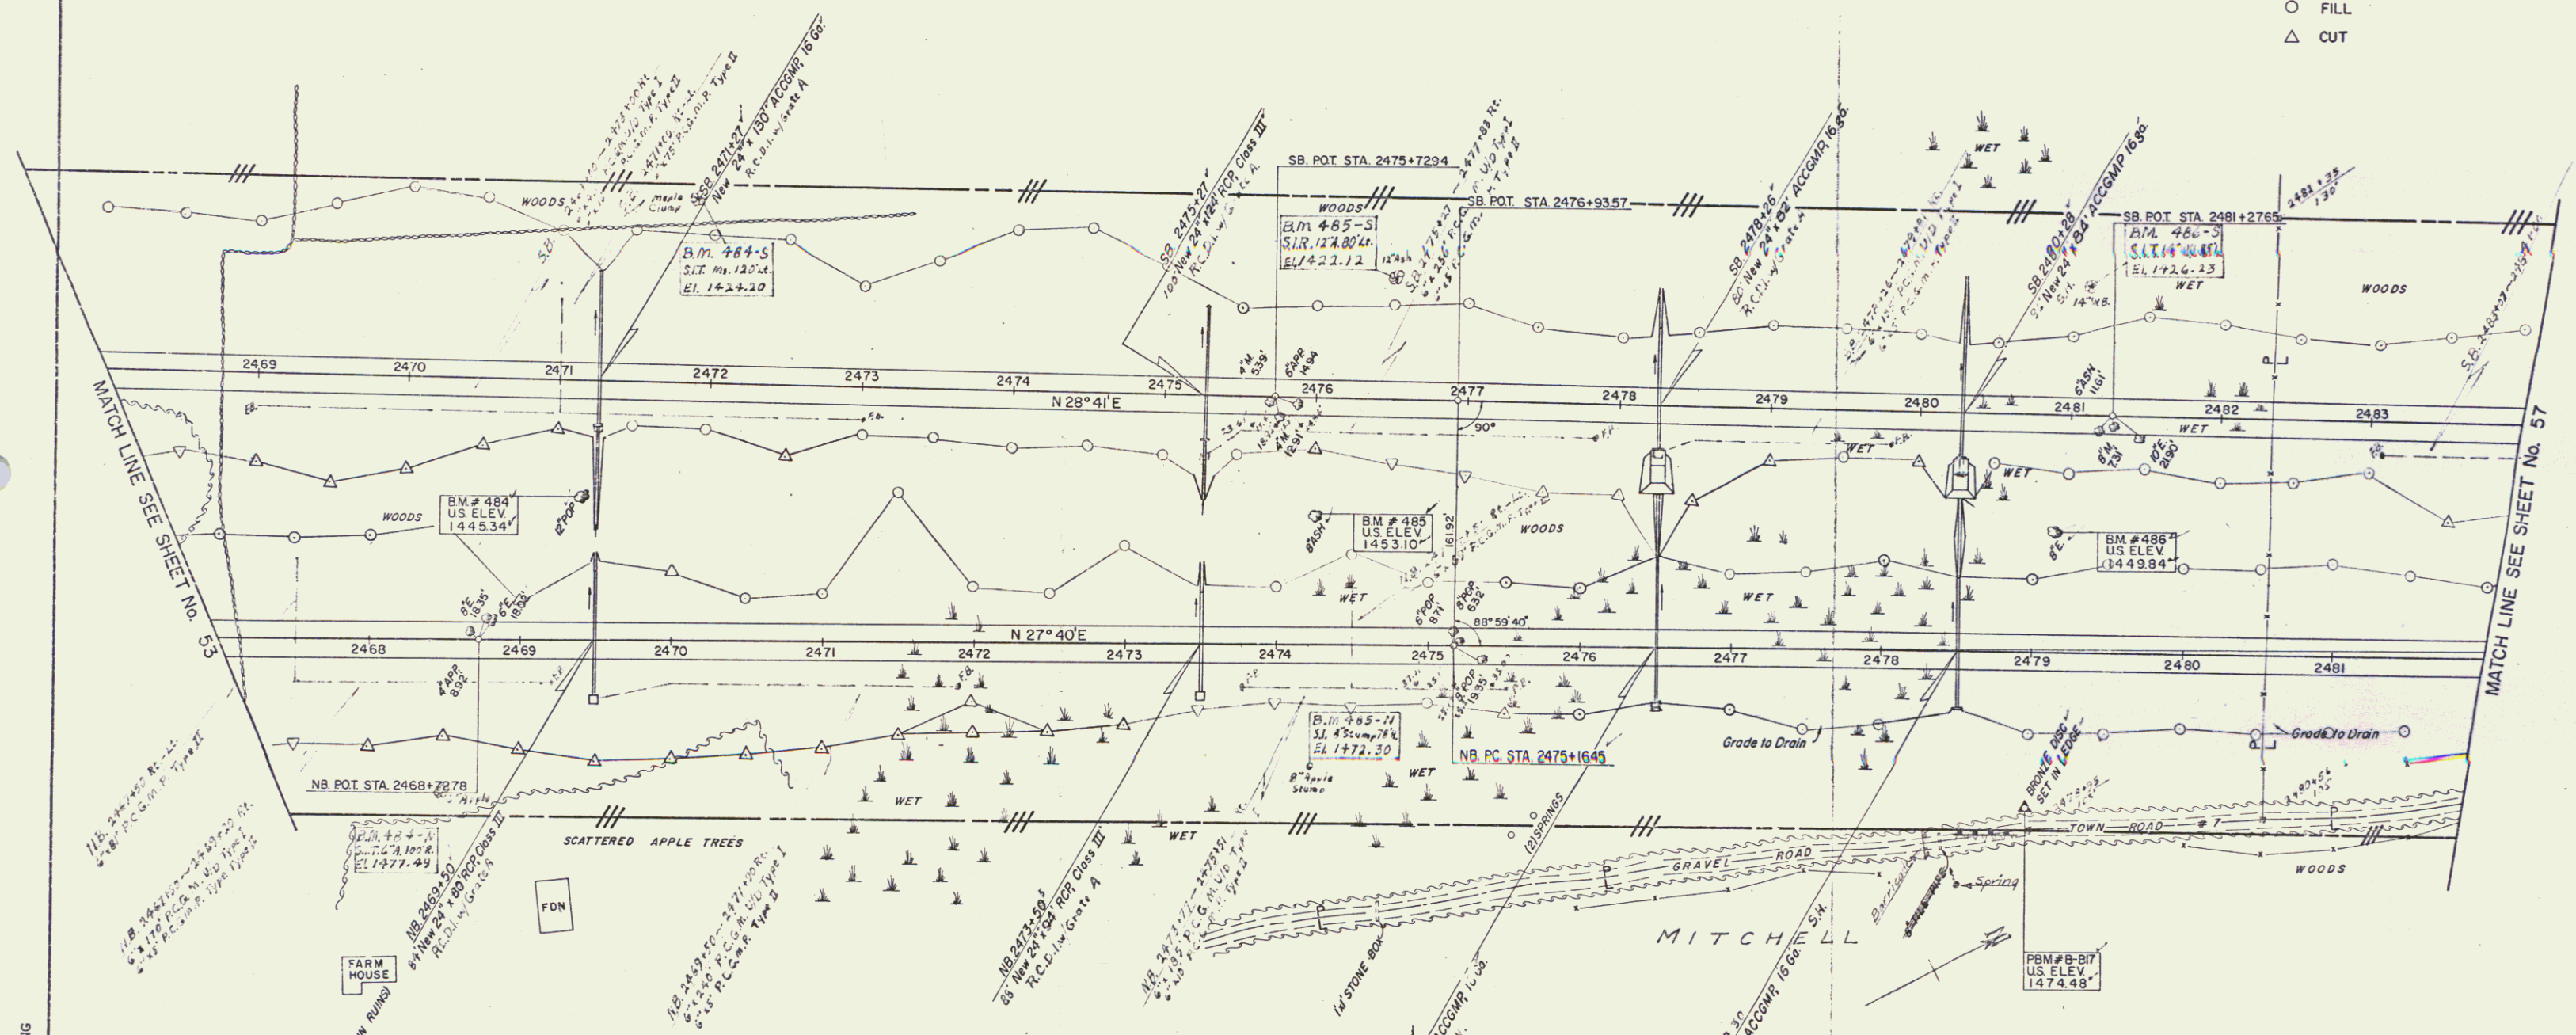

PORTER, O'BRIEN & ARISTONING
 CONSULTING ENGINEERS
 1000 N. 10TH ST.
 PITTSBURGH, PA. 15222

CONTROL OF ACCESS IS COMPLETE ON THIS SHEET

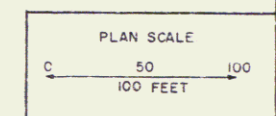

STAGE 2 CONSTRUCTION
 BROOKFIELD-WILLIAMSTOWN
 BERLIN
 I 89-1(11) (29)
 CONTRACT No. 2
 SHEET 55 OF 425
 125 263