

* DENOTES STAGE 2 ITEMS


Stone Fill For Slope Protection (Light Type)
Item 502
NB 2516+00 LT - SB 2519+50 Rt.

Standard Steel Beam Guard Rail w/Steel Posts (5'-3" Spacing)
Item 545-3
Ramp C 26+92 - 37+00 Lt.
Ramp D 35+97 - 38+00 Rt.


Granite Slope Edging
Item 556-A

Drilling and Blasting of Solid Rock
Subgrade Item 115
SB 2515+00 - 2530+00
NB 2513+00 - 2513+25
NB 2514+50 - 2529+00

| PROPERTY LINE FENCE WITH STEEL POSTS ITEM 563-1 MOD. | | | |
|--|---------|------|--|
| STA. | STA. | POS. | |
| 2513+00 | 2523+00 | RT | |
| 2515+00 | 2515+00 | LT | |

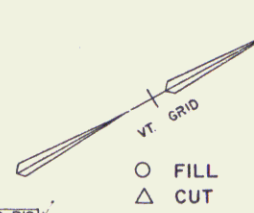

RAMP "C" CURVE DATA
 $\Delta = 42^\circ 04' 21"$
 $D = 9^\circ 00' 00"$
 $R = 716.20'$
 $T = 275.44'$
 $L = 525.90'$
 $E = 511.4'$
 Bank = 7/8' Per Ft

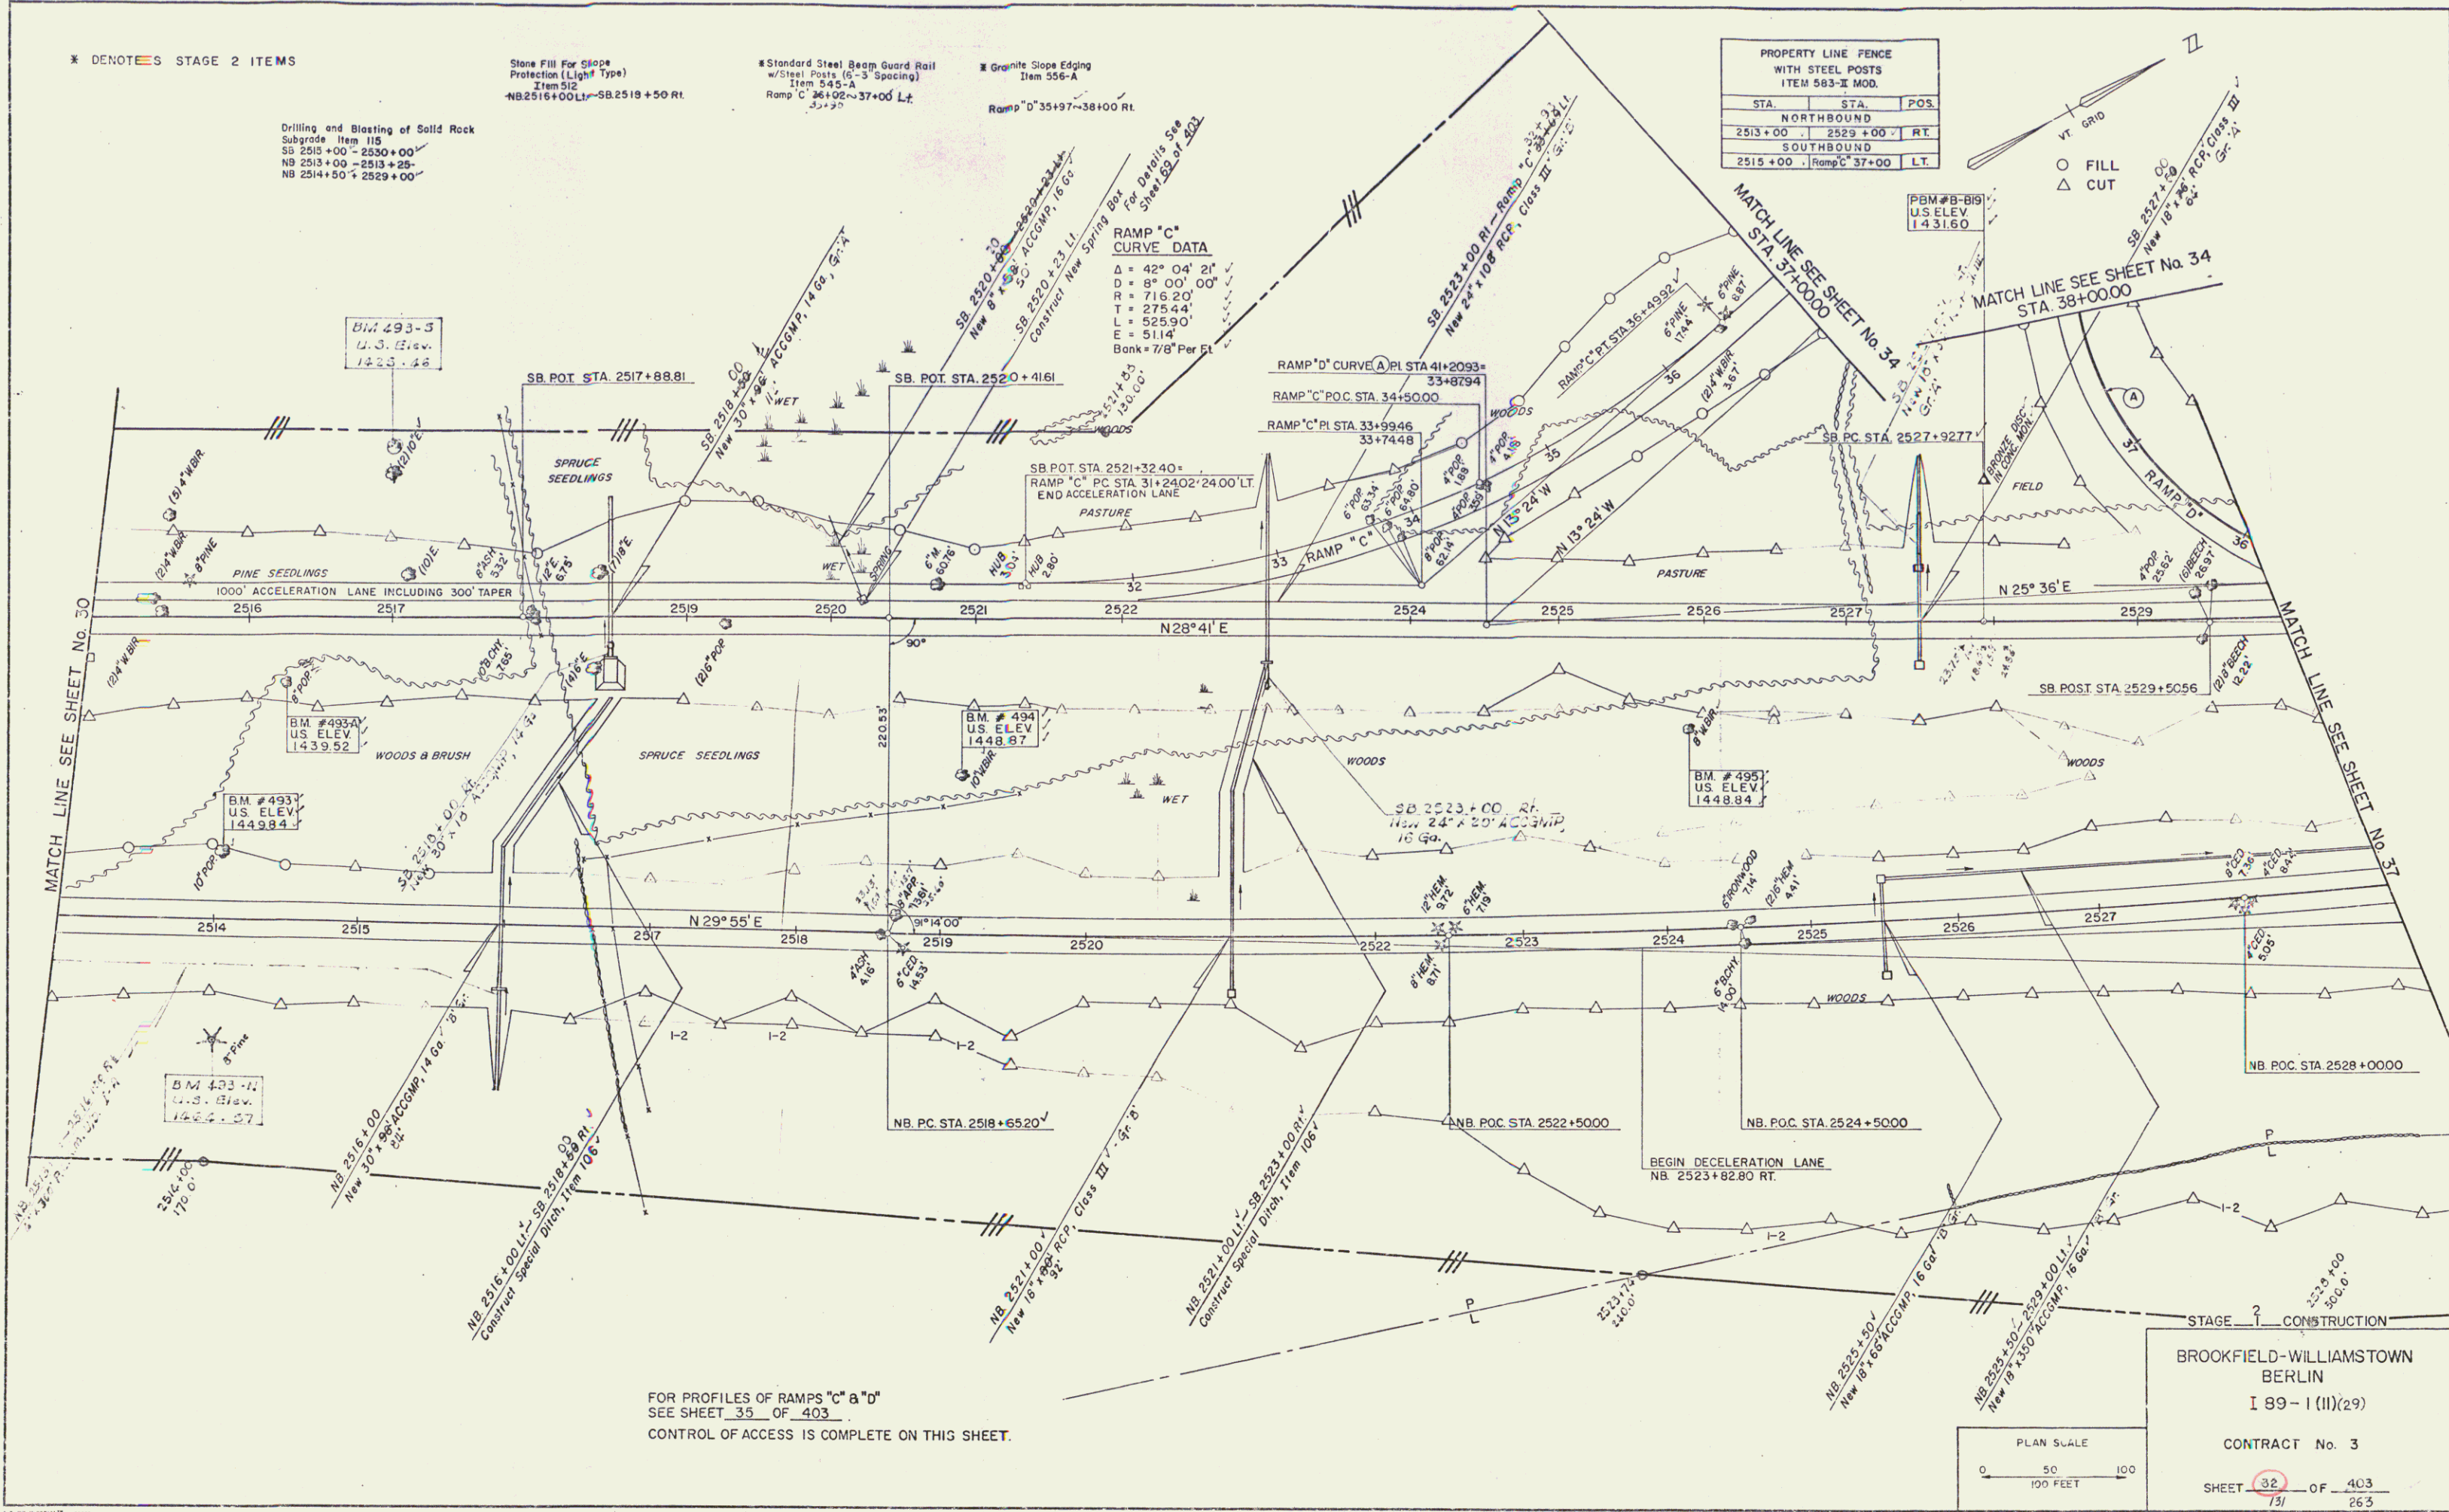

PORTER, O'BRIEN & ARMSTRONG
INCORPORATED
1000 W. BROADWAY
NEW YORK, N.Y. 10011

STAGE 2 CONSTRUCTION

BROOKFIELD-WILLIAMSTOWN
BERLIN
I 89-1 (11)(29)

CONTRACT No. 3

SHEET 32 OF 403
151 OF 265