

\* DENOTES STAGE 2 ITEMS

Bridge Rolling for Bridge Approaches  
 Item 572  
 NB 2537+82 ~ 2535+82 RT  
 NB 2537+82 ~ 2535+82 RL  
 NB 2537+77 ~ 2535+77 RT  
 NB 2537+77 ~ 2535+77 RL  
 SB 2538+63 ~ 2536+63 RT  
 SB 2538+63 ~ 2536+63 RL

Treated Timber Curb, Item 598  
 NB 2544+95 ~ 2544+00 RT  
 NB 2537+71 ~ 2544+00 LT  
 SB 2538+69 ~ 2546+00 LT  
 Ramp B Rev. 7+00 ~ 2+63 RT


Groove Slope Edging, Item 536-A  
 SB AR 49+84.52 55+00 Median  
 Ramp 'D' 34+7+43 ~ 35+97 RT

Jute Matting, Item 623  
 NB 2540+25 ~ 2544+00 LT

Drilling and Blasting of Solid Rock Subgrade, Item 108  
 NB 2550+00 ~ 2535+75  
 NB 2539+00 ~ 2536+95  
 Ramp B 7+00 ~ 2+63  
 SB AR 49+84.52 ~ 35+97  
 SB AR 25+10 ~ 25+10

| PROPERTY LINE FENCE WITH STEEL POSTS ITEM 583-II MOD. |             |      |
|---|-------------|------|
| STA.  | STA.        | POS. |
| NORTHBOUND  |             |      |
| 2539+00   | Ramp A 3+00 | RT   |
| Ramp B 7+00   | 2544+00     | RT   |
| SOUTHBOUND  |             |      |
| 2539+72   | 2546+00     | LT   |

RAMP "D" CURVE (A)  
 Δ = 141° 00' 00"  
 D = 2 54' 40"  
 R = 2330.00'  
 T = 6 59' 50"  
 L = 5 59' 01"  
 E = 4 9' 02"  
 Bank = 1 Per Ft.

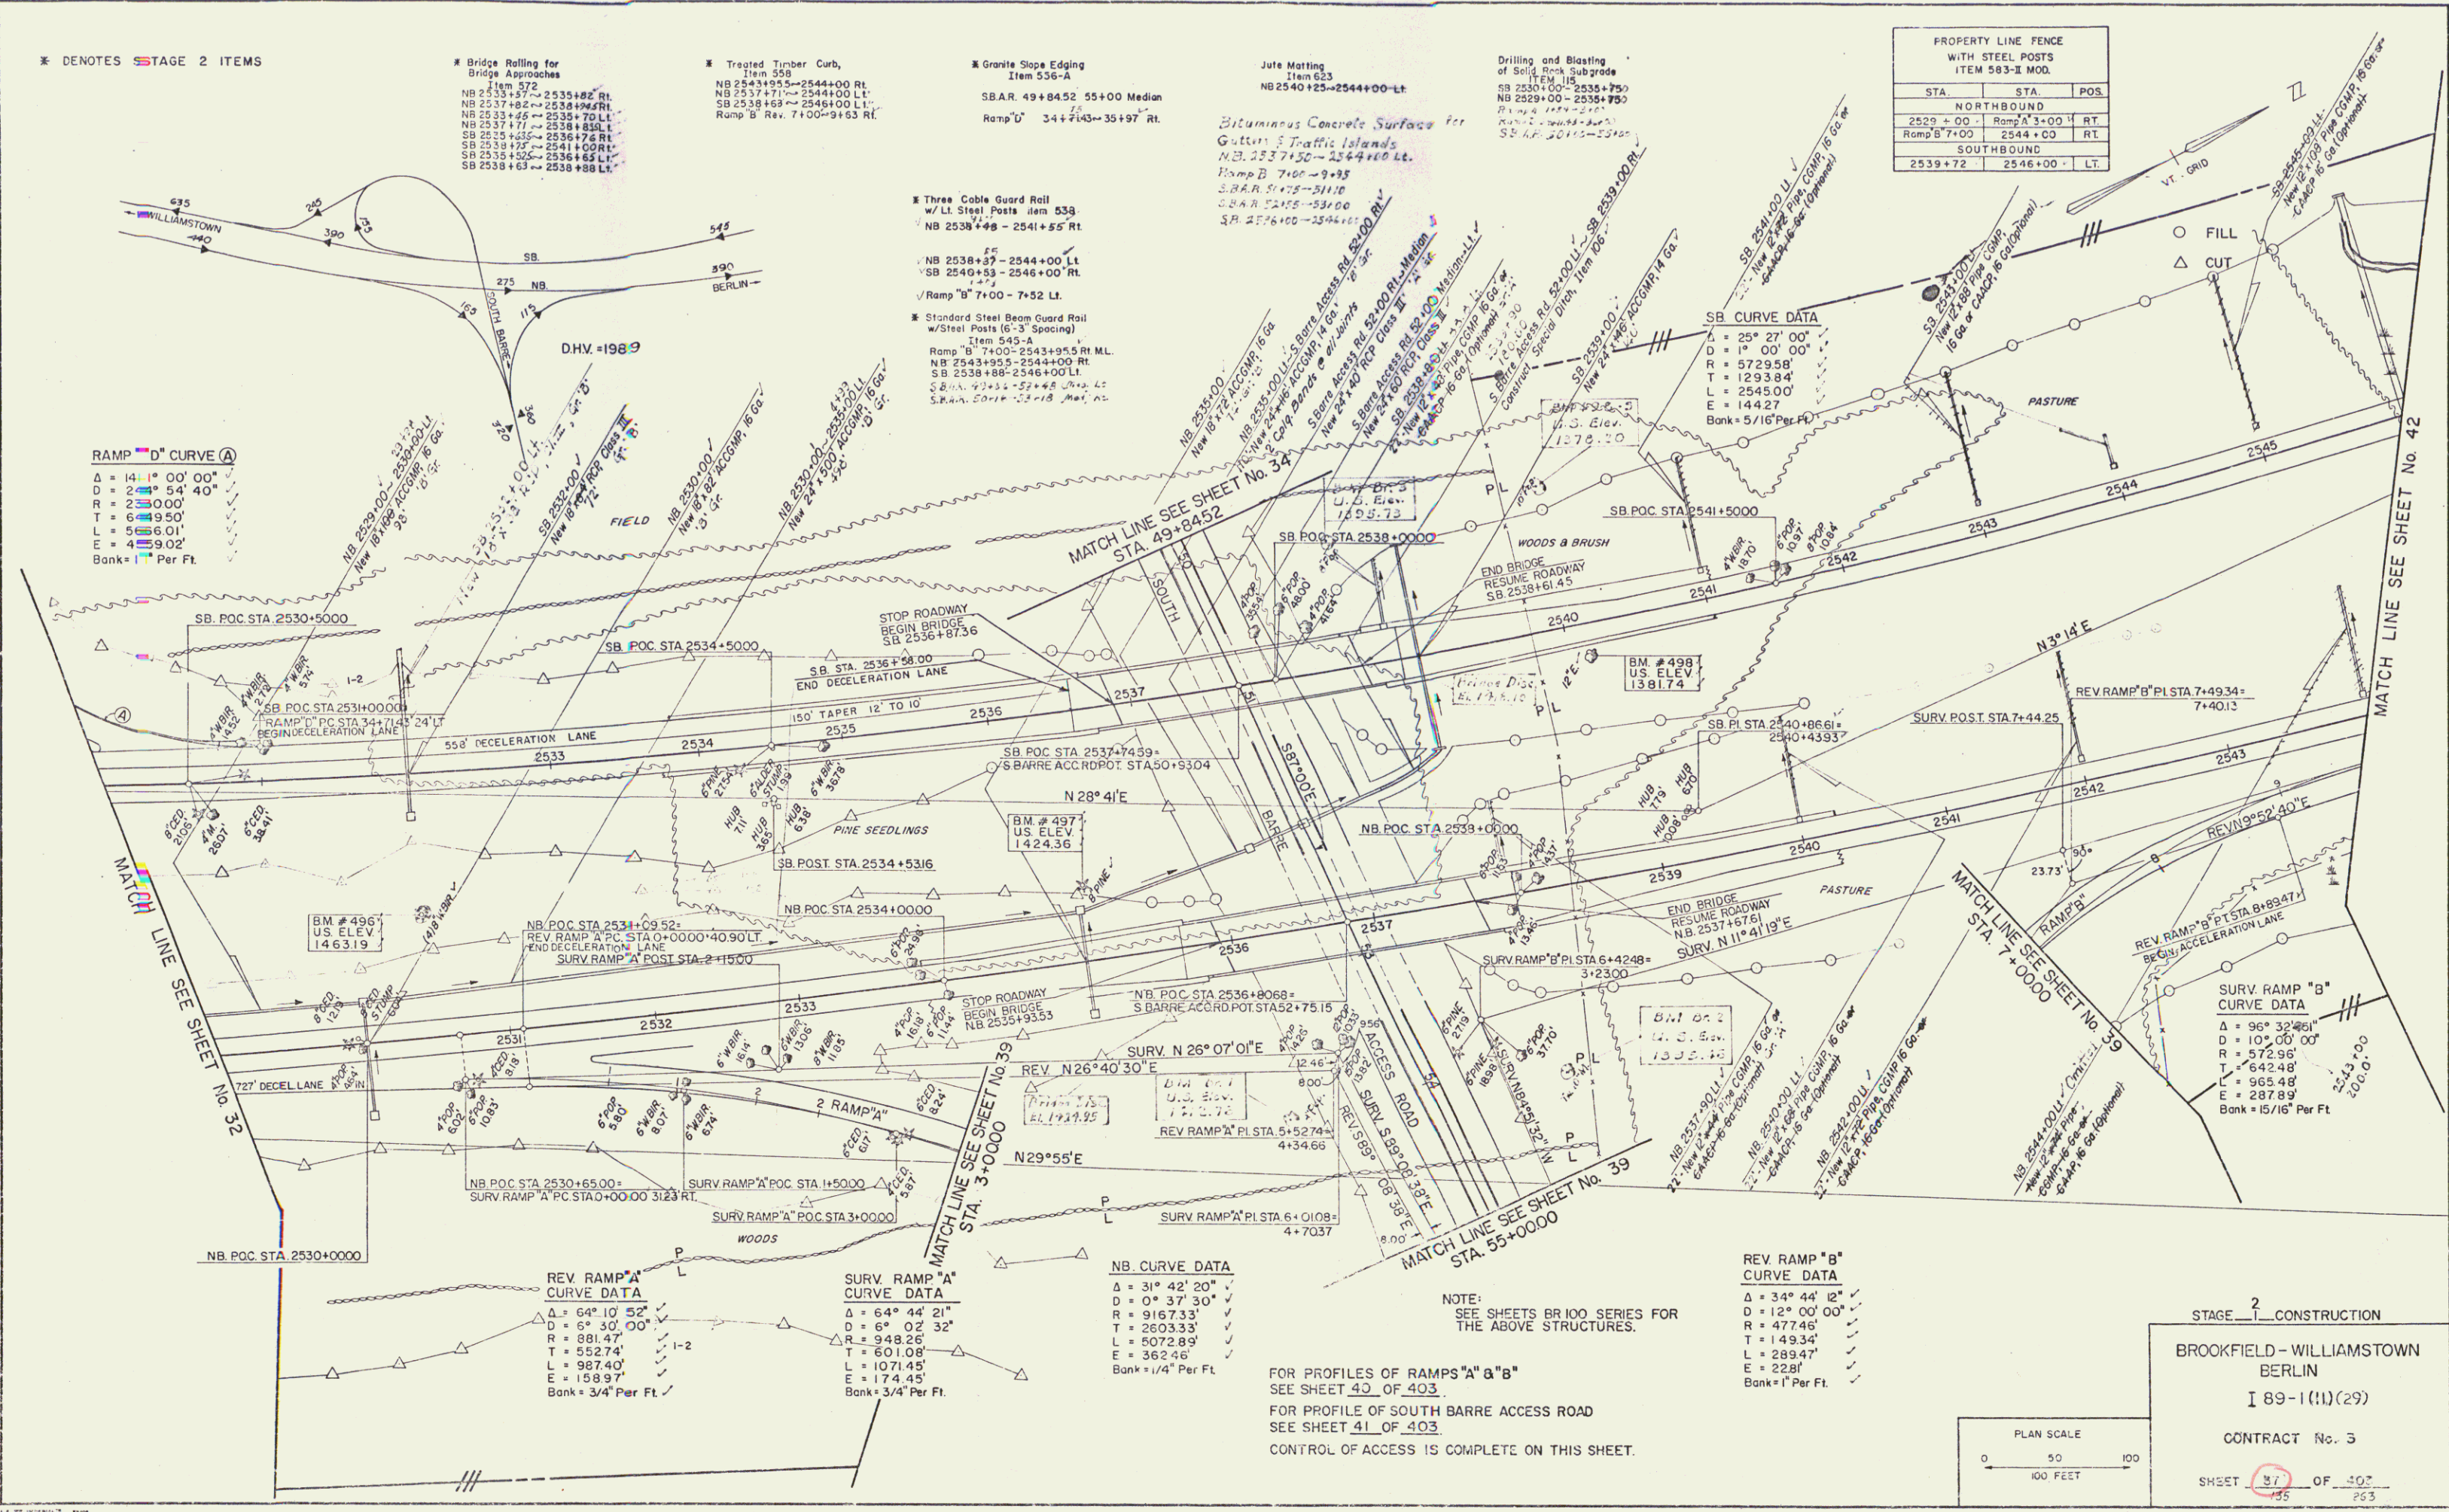


REV RAMP "A" CURVE DATA  
 Δ = 64° 10' 52"  
 D = 6° 30' 00"  
 R = 881.47'  
 T = 552.74'  
 L = 987.40'  
 E = 198.97'  
 Bank = 3/4 Per Ft.

SURV RAMP "A" CURVE DATA  
 Δ = 64° 44' 21"  
 D = 6° 02' 32"  
 R = 948.26'  
 T = 601.08'  
 L = 1071.45'  
 E = 174.45'  
 Bank = 3/4 Per Ft.

NB CURVE DATA  
 Δ = 31° 42' 20"  
 D = 0° 37' 30"  
 R = 9167.33'  
 T = 2503.33'  
 L = 6072.89'  
 E = 362.46'  
 Bank = 1/4 Per Ft.

REV RAMP "B" CURVE DATA  
 Δ = 34° 44' 12"  
 D = 12° 00' 00"  
 R = 477.45'  
 T = 149.34'  
 L = 289.47'  
 E = 228'  
 Bank = 1 Per Ft.

NOTE:  
 SEE SHEETS BR 100 SERIES FOR THE ABOVE STRUCTURES.  
 FOR PROFILES OF RAMPS "A" & "B" SEE SHEET 40 OF 403.  
 FOR PROFILE OF SOUTH BARRE ACCESS ROAD SEE SHEET 41 OF 403.  
 CONTROL OF ACCESS IS COMPLETE ON THIS SHEET.

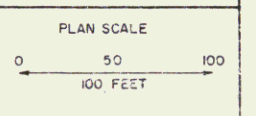

STAGE 2 CONSTRUCTION  
 BROOKFIELD - WILLIAMSTOWN  
 BERLIN  
 I 89-1(11)(29)  
 CONTRACT No. 3  
 SHEET 37 OF 40  
 25 263

POSTER, CURRIEN & HANFORD  
 CONSULTING ENGINEERS  
 100 N. W. 10th St.  
 MIAMI, FL 33136