

* DENOTES STAGE 2 ITEMS

Stone Fill For Slope Protection (Light Type)
Item 512
G.G.A. R. 62 + 50 Rt.
(Treat Ditch)

Three Cable Guard Rail w/LI Steel Posts
Item 538
Ramp "B" 3+52 ~ Rev. 7+00 Lt.

Treated Timber Curb
Item 558
S.B.A. 50+16.09 ~ 60+53 Lt.
Ramp "B" 0+00 ~ Rev. 7+00 Rt.

Drilling & Blasting of Sella Rock Shafts
Item 558
S.B.A. 50+16.09 ~ 60+53 Lt.
Ramp "B" 0+00 ~ Rev. 7+00 Rt.

Rip Rap (Light Type)
Item 513-B
Ramp "A" Rev. 8+05 ~ 8+11 Rt.

Standard Steel Beam Guard Rail w/Steel Posts (6'-3" Spacing)
Item 545-A
S.B.A. 57+85 ~ 59+35 Median Rt.
S.B.A. 58+35 ~ 59+85 Median Lt.
Ramp "B" 0+00 ~ 7+00 Rt. (60+16 S.B.A. Ramp "B" 0+00)
S.B.A. 60+16 ~ 61+03 Lt.

Granite Slope Edging
Item 556-A
S.B.A. 55+00 ~ 60+16.09 Median


Bituminous Concrete Surface for Gutters & Traffic Islands
Ramp "B" 1+00 ~ 7+00

PROPERTY LINE FENCE WITH STEEL POSTS ITEM 583-E MOD.		
STA.	STA.	POS.
NORTHBOUND		
Ramp "A" 3+00	S.B.A. 63+00	RT.
S.B.A. 63+00	Ramp "B" 7+00	RT.



○ FILL
△ CUT

FOR PROFILES OF RAMPS "A" & "B" SEE SHEET 40 OF 403
FOR PROFILE OF SOUTH BARRE ACCESS ROAD SEE SHEET 41 OF 403
CONTROL OF ACCESS IS COMPLETE ON THIS SHEET EXCEPT AT STA 59+00 S BARRE ACCESS RD.

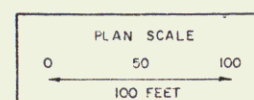

STAGE 2 CONSTRUCTION
BROOKFIELD-WILLIAMSTOWN
BERLIN
I 89-1 (11)(29)
CONTRACT No. 3
SHEET 39 OF 403
253

POSTER, BISHOP & ARMSTRONG
CONSULTING ENGINEERS, P.C.
1000 W. 10th St., Des Moines, IA 50319

