

\* DENOTES STAGE 2 ITEMS

Bituminous Concrete Surface  
in 5" Lifts & 1" Tolerances  
No. 2544+00~2549+00 RT  
No. 2544+00~2550+00 LT  
No. 2544+00~2551+00 LT

Stone Fill For Slope  
Protection (Light Type)  
Item 512  
No. 2544+00~2547+50-RT


Three Cable Guard Rail  
w/LL Steel Posts  
Item 538  
No. 2544+00~2549+00 LT  
No. 2546+00~2551+12 RT

Treated Timber Curb,  
Item 553  
No. 2544+00~2546+00 RT  
No. 2544+00~2548+00 LT  
No. 2546+00~2550+50 LT  
Ramp's Rev. 7-00-9163 RT

Jute Matting  
Item 633  
No. 2544+00~2546+50-LT

PROPERTY LINE FENCE WITH STEEL POSTS ITEM 583-II MOD		
STA	STA	POS
NORTHBOUND		
2544+00	2553+00	RT
SOUTHBOUND		
2546+00	2551+00	LT

Drilling and Blasting of Solid Rock Subgrade Item 115  
No. 2546+25 - 2559+00  
No. 2551+25 - 2561+00

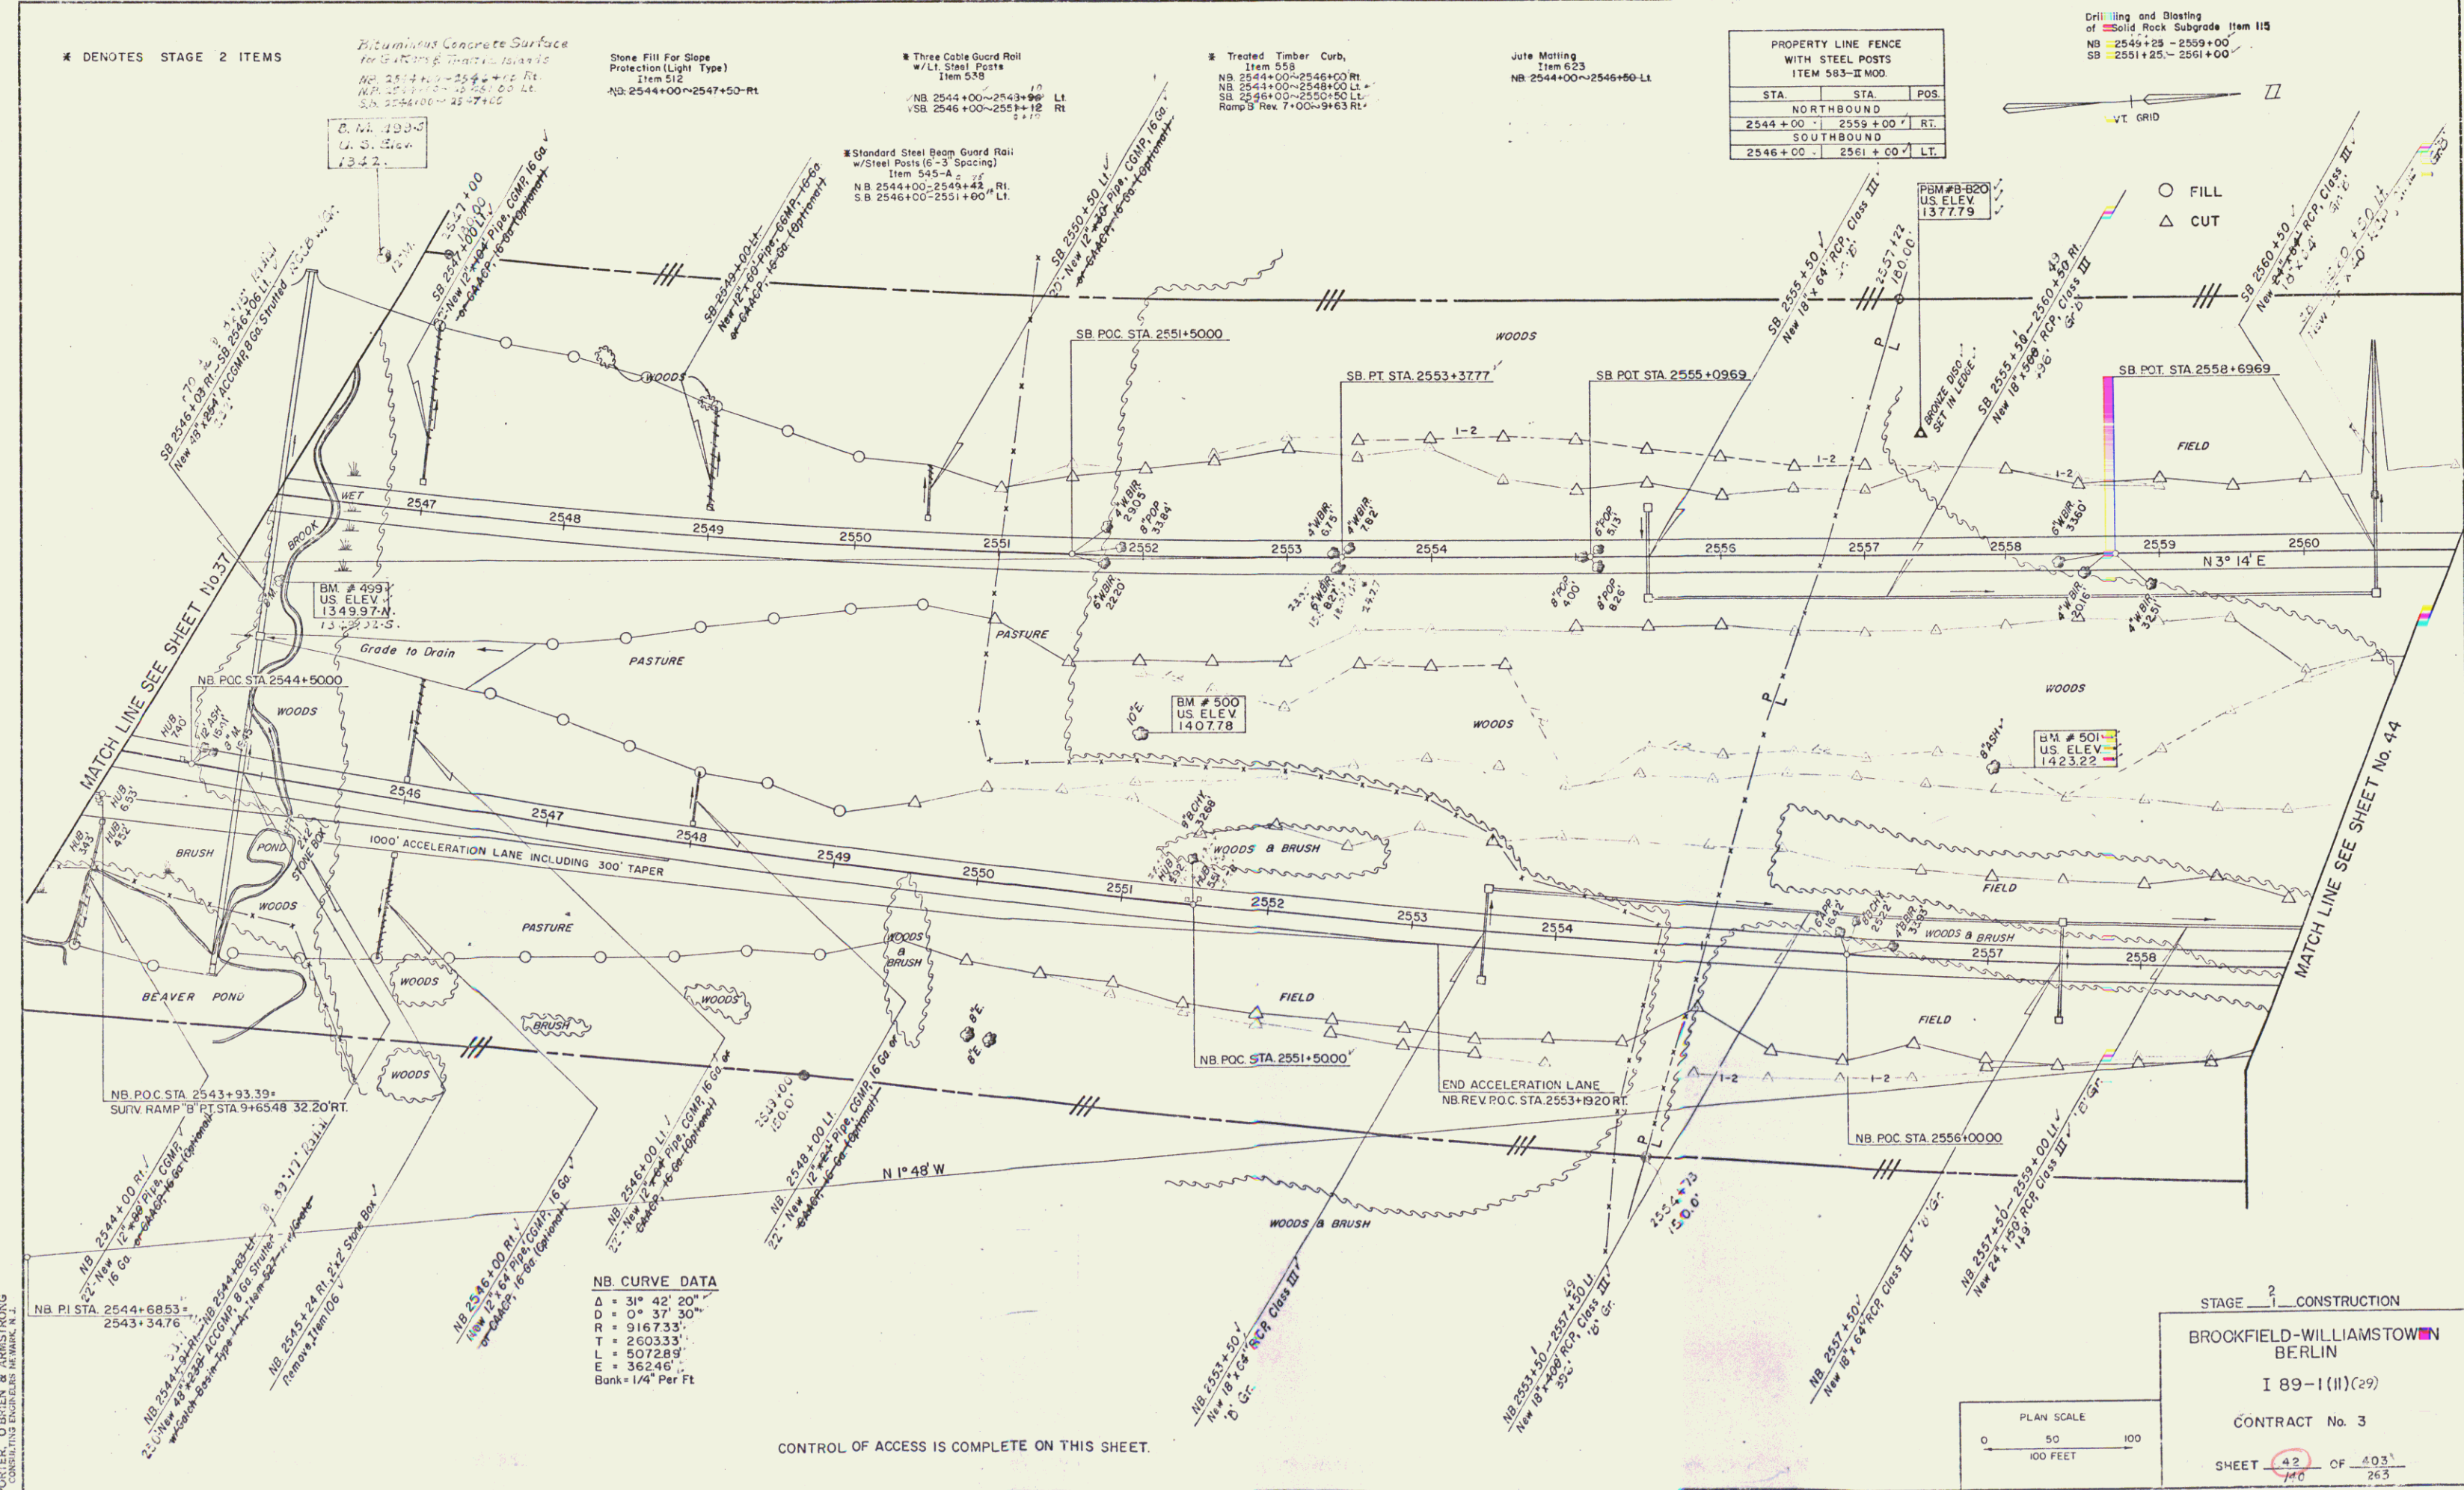


PORTER, O'BRIEN & ARMSTRONG  
CONSULTING ENGINEERS

**NB CURVE DATA**

Δ	= 31° 42' 20"
D	= 0° 37' 30"
R	= 9167.33'
T	= 2603.33'
L	= 5072.89'
E	= 362.46'
Bank	= 1/4" Per Ft

CONTROL OF ACCESS IS COMPLETE ON THIS SHEET.

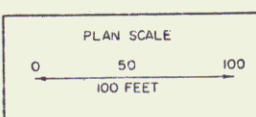

STAGE 2 CONSTRUCTION

**BROCKFIELD-WILLIAMSTOWN  
BERLIN**

I 89-1(III)(29)

CONTRACT No. 3

SHEET 42 OF 403  
JFC 265