

* DENOTES STAGE 2 ITEMS

Rip Rap (Light Type),
Item 511-B
NB 2567+27-2587+33 Rt.
Reloc. T-57 20+96-27+04 Rt.



Drilling and Blasting
of Solid Rock Subgrade Item 115
NB 2575+00-2585+25 Lt.
SB 2578+22-2587+28 Lt.
T.H. 17 1+50-31+50

Two Cable Guard Rail
Item 541
Reloc. T-57 22+10-27+46 Lt.

Standard Steel Beam Guard Rail
w/ Steel Posts (6'-3" Spacing)
Item 543-A
SB 2575+00-2575+36 Rt.
SB 2575+00-2575+84 Lt.

Three Cable Guard Rail
w/ Lt. Steel Posts Item 538
NB 2589+46-2590+00 Rt.

PROPERTY LINE FENCE WITH STEEL POSTS ITEM 583-II MOD.		
STA	STA	POS
NORTHBOUND		
2575+00	2590+00	RT.
SOUTHBOUND		
2575+00	2591+00	LT.

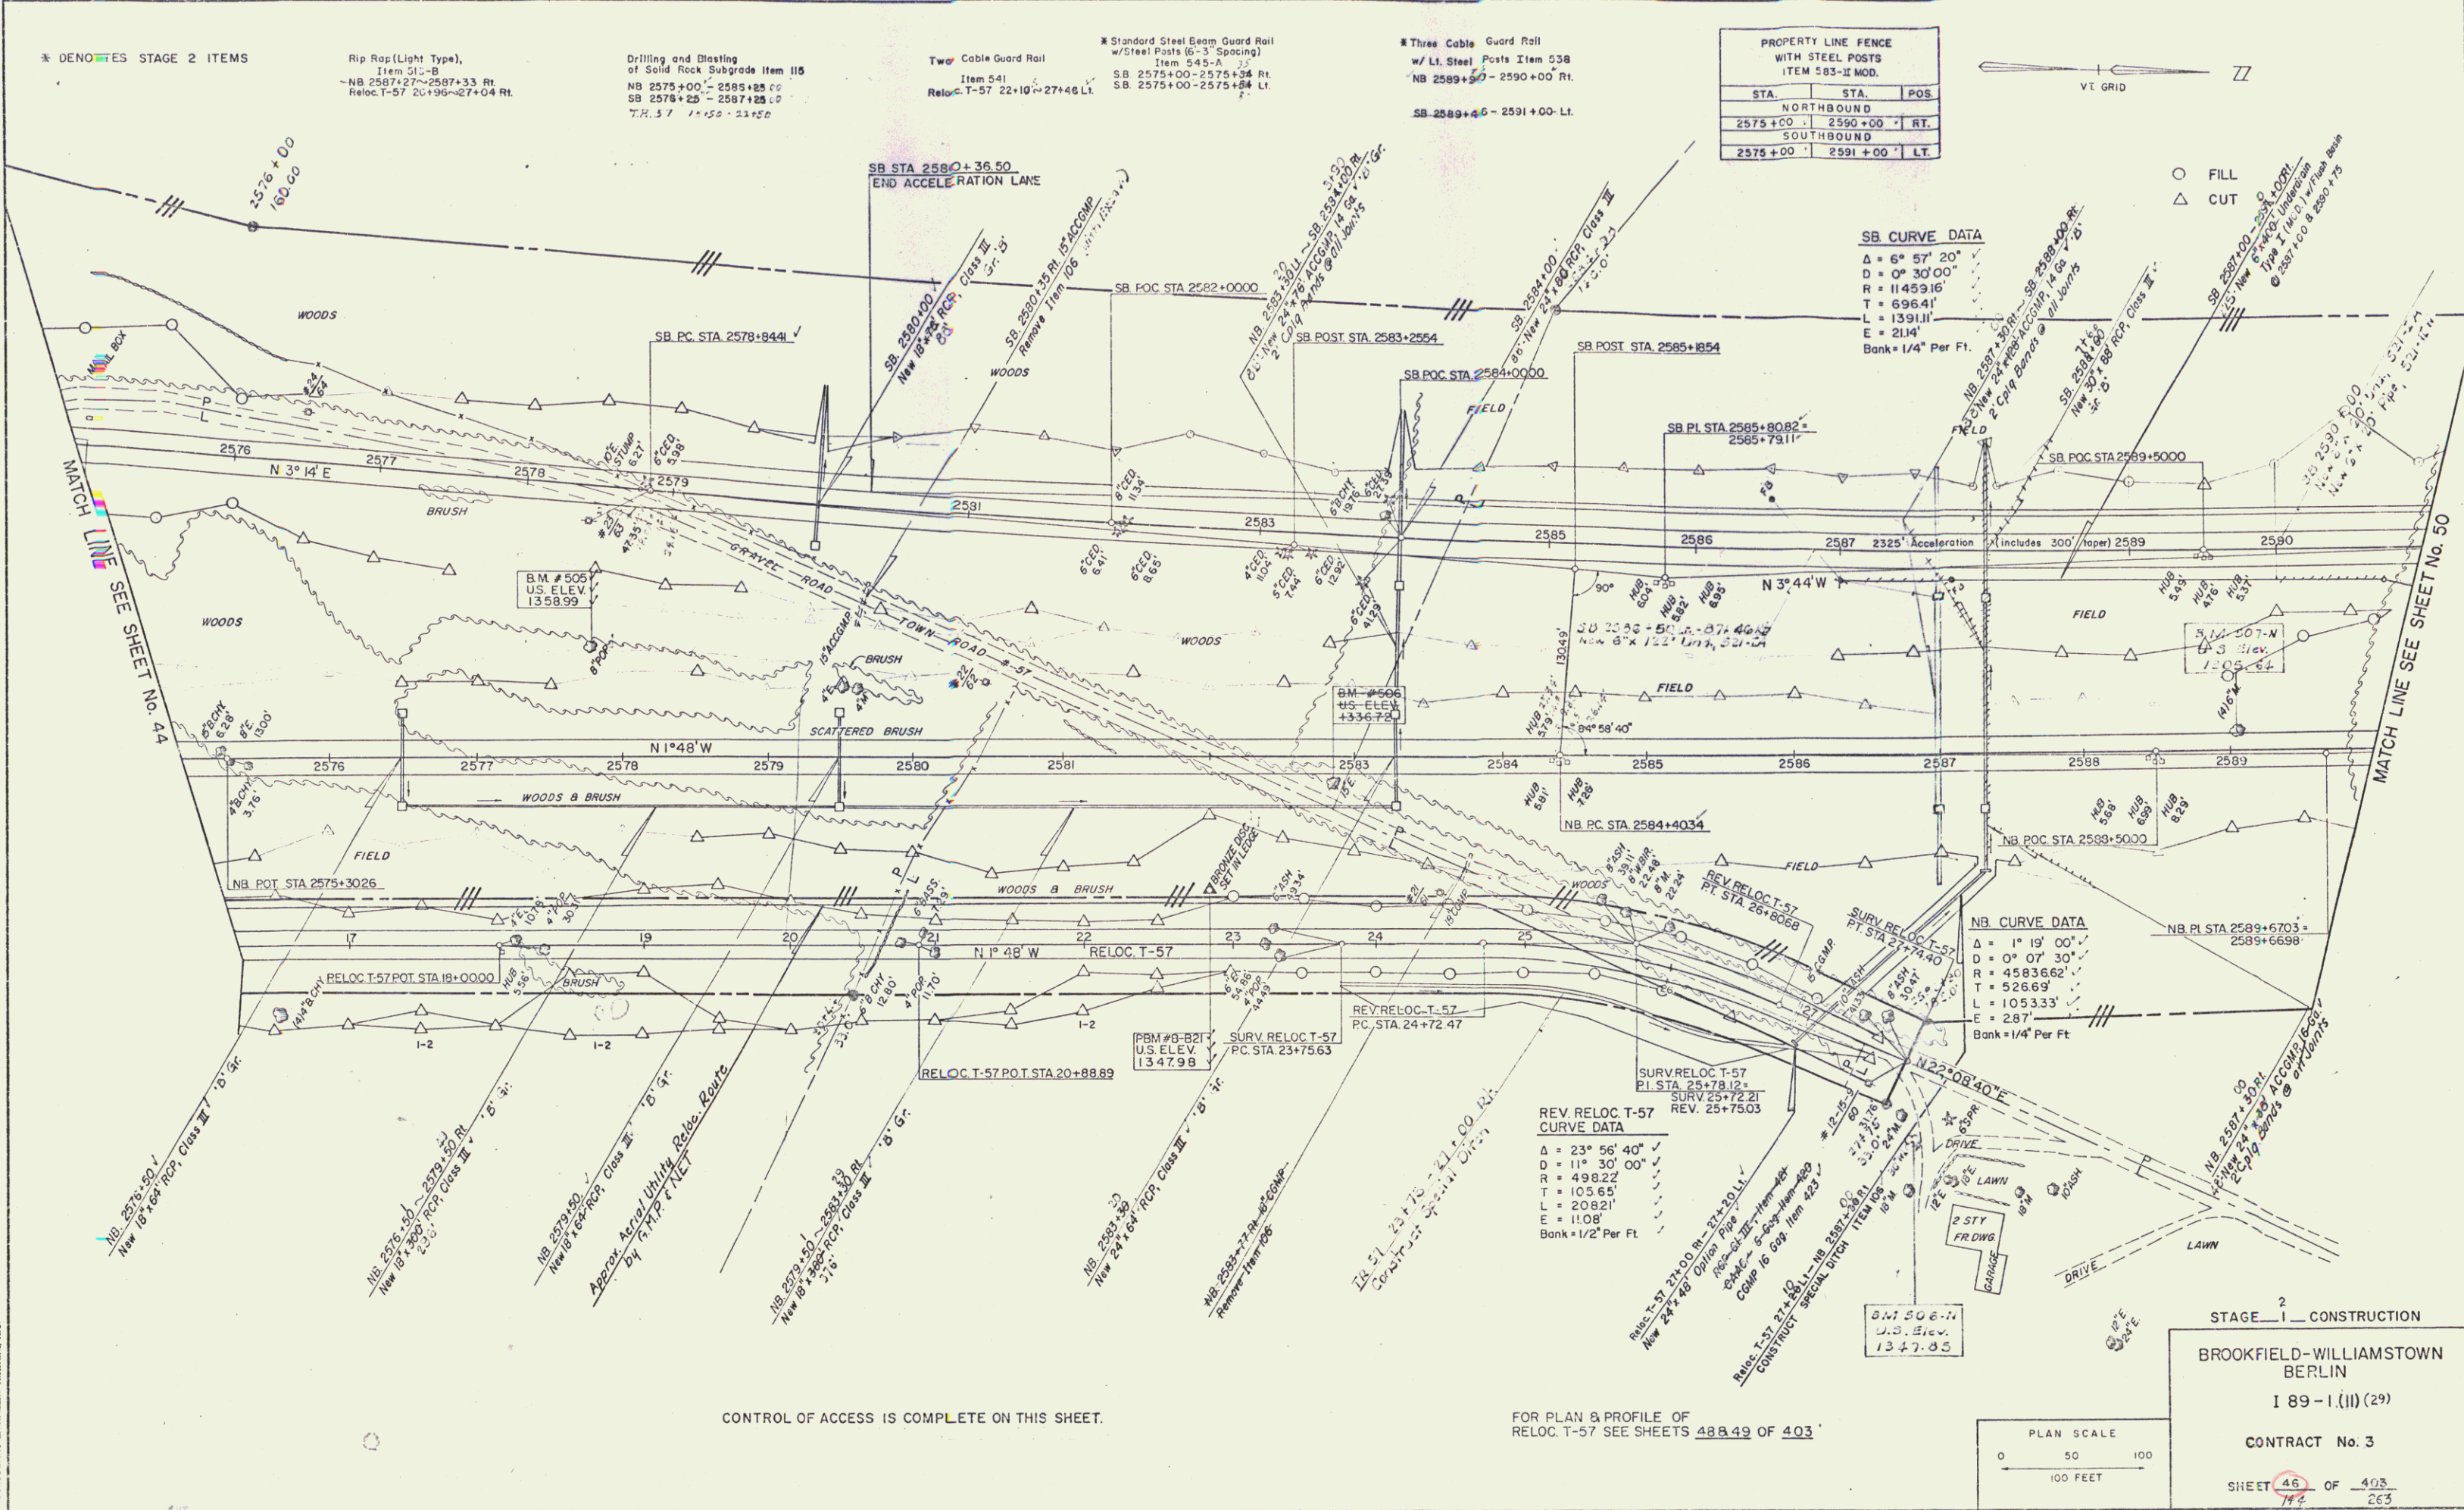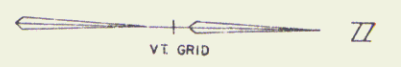

SB CURVE DATA

Δ	6° 57' 20"
D	0° 30' 00"
R	11459.16'
T	696.41'
L	1391.11'
E	211.4'
Bank	1/4" Per Ft.

NB CURVE DATA

Δ	1° 19' 00"
D	0° 07' 30"
R	45836.62'
T	526.69'
L	1053.33'
E	2.87'
Bank	1/4" Per Ft.


REV. RELOC. T-57 CURVE DATA

Δ	23° 56' 40"
D	11° 30' 00"
R	498.22'
T	105.65'
L	208.21'
E	110.8'
Bank	1/2" Per Ft.

PORTER, O'BRIEN & ARMSTRONG
CONSULTING ENGINEERS, NEWARK, N.J.

CONTROL OF ACCESS IS COMPLETE ON THIS SHEET.

FOR PLAN & PROFILE OF RELOC. T-57 SEE SHEETS 488.49 OF 403

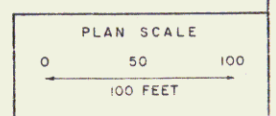

STAGE 2 CONSTRUCTION

BROOKFIELD-WILLIAMSTOWN
BERLIN

189-1.11(29)

CONTRACT No. 3

SHEET 46 OF 403
14