

\* DENOTES STAGE 2 ITEMS

CONSTRUCT DRIVE  
10+50 RT.



PROPERTY LINE FENCE WITH STEEL POSTS ITEM 583-X MOD.		
STA.	STA.	POS.
NORTHBOUND		
2572+00 RT.	RELOC T-57	19+00 LT.

**RELOC T-57  
CURVE DATA**

Δ = 66° 45' 00"  
 D = 12° 00' 00"  
 R = 477.46'  
 T = 314.53'  
 L = 556.25'  
 E = 94.29'  
 Bank = 1/2" Per Ft.

NOTE: RELOCATED T-57 IS TO BE BUILT  
IN ITS ENTIRETY DURING STAGE  
I CONSTRUCTION.

○ FILL  
△ CUT

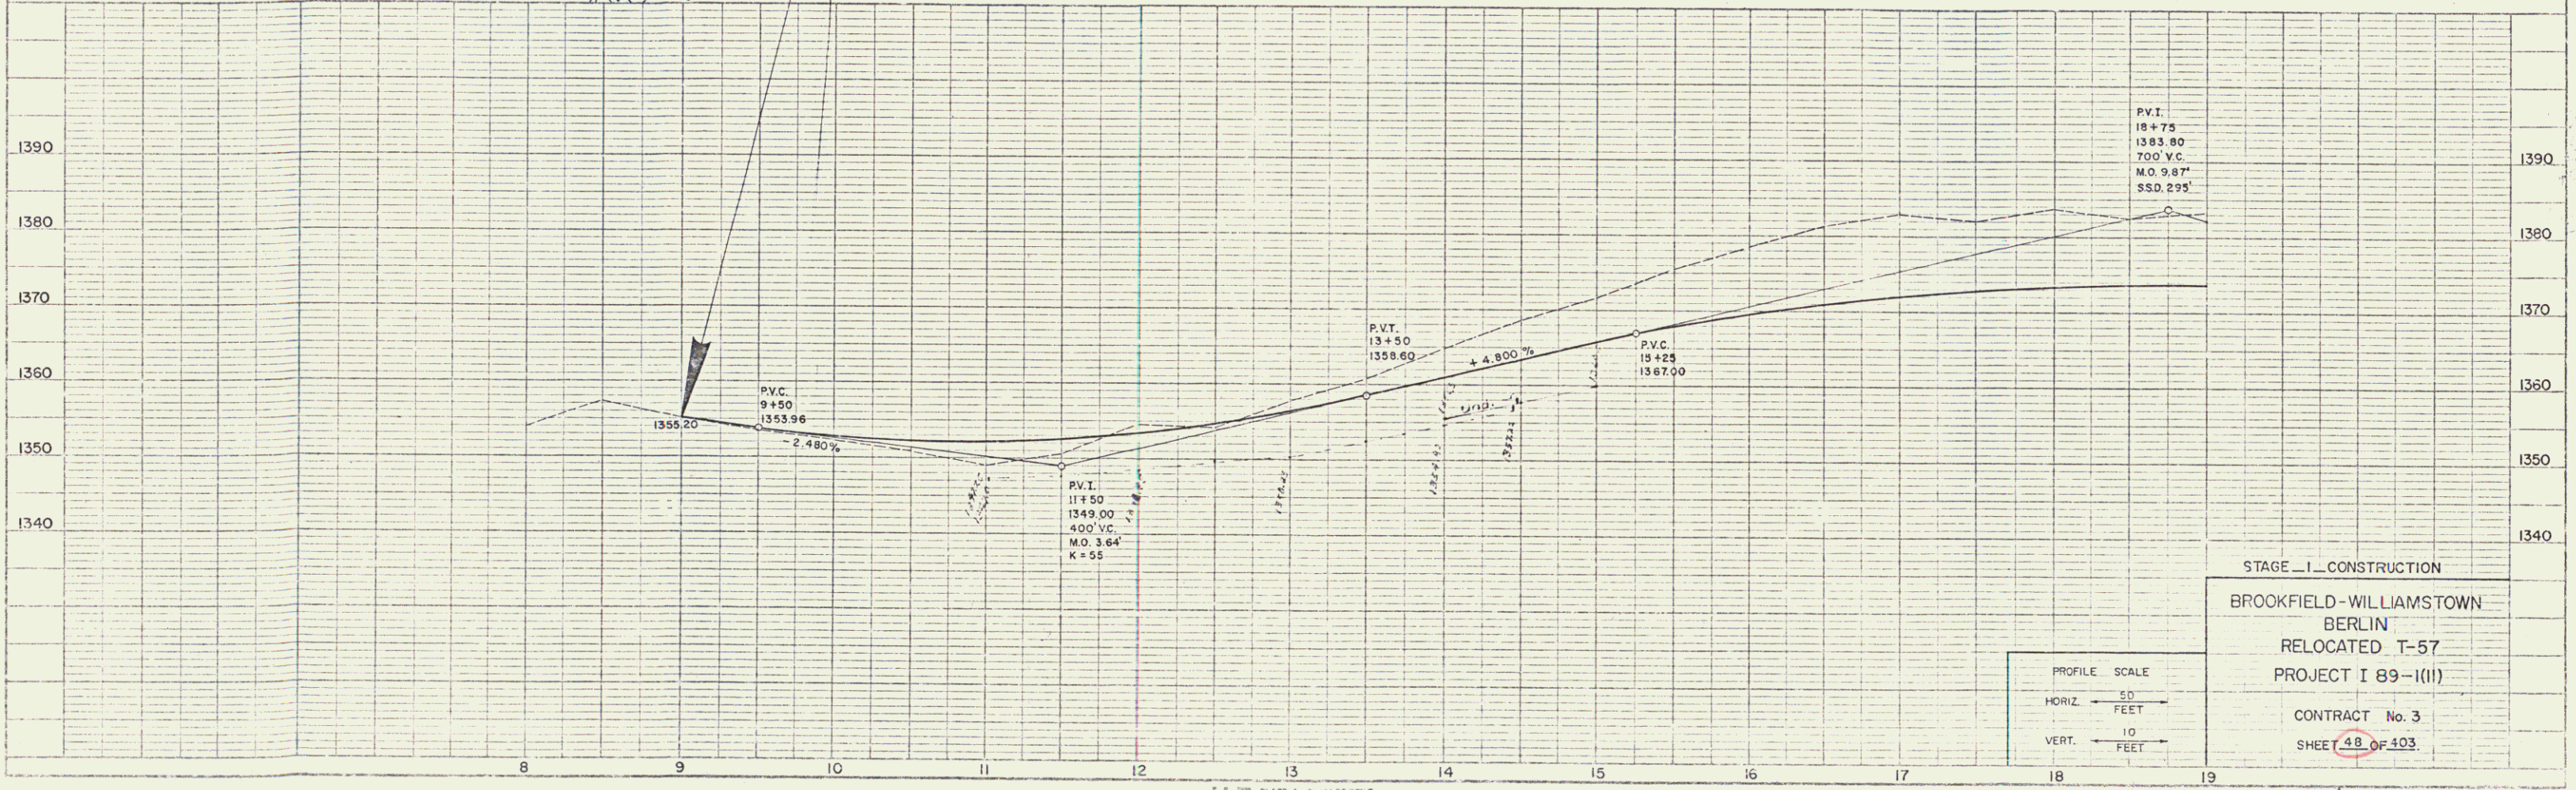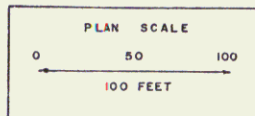

PROFILE SCALE  
 HORIZ. 50 FEET  
 VERT. 10 FEET

STAGE I CONSTRUCTION  
 BROOKFIELD-WILLIAMSTOWN  
 BERLIN  
 RELOCATED T-57  
 PROJECT I 89-I(II)  
 CONTRACT No. 3  
 SHEET 48 OF 103

PLATE 1, PLAN/PROFILE

123