

* DENOTES STAGE 2 ITEMS



Rip Rap (Light Type),
Item 513-B
NB 2591+27-2591+37 Rt.

Three Cable Guard Rail
w/lt Steel Posts,
Item 538
NB 2590+00-2591+56 Rt.
SB 2591+00-2593+00 Lt.


Stone Wall Item 512
NB 2590+00-2591+56 Rt.

Jute Matting
Item 623
NB-2590+25-2591+75-Lt.

| PROPERTY LINE FENCE WITH STEEL POSTS ITEM 583-II MOD. | | |
|---|---------|------|
| STA. | STA. | POS. |
| NORTHBOUND | | |
| 2590+00 | 2605+00 | RT |
| SOUTHBOUND | | |
| 2591+00 | 2605+00 | LT |

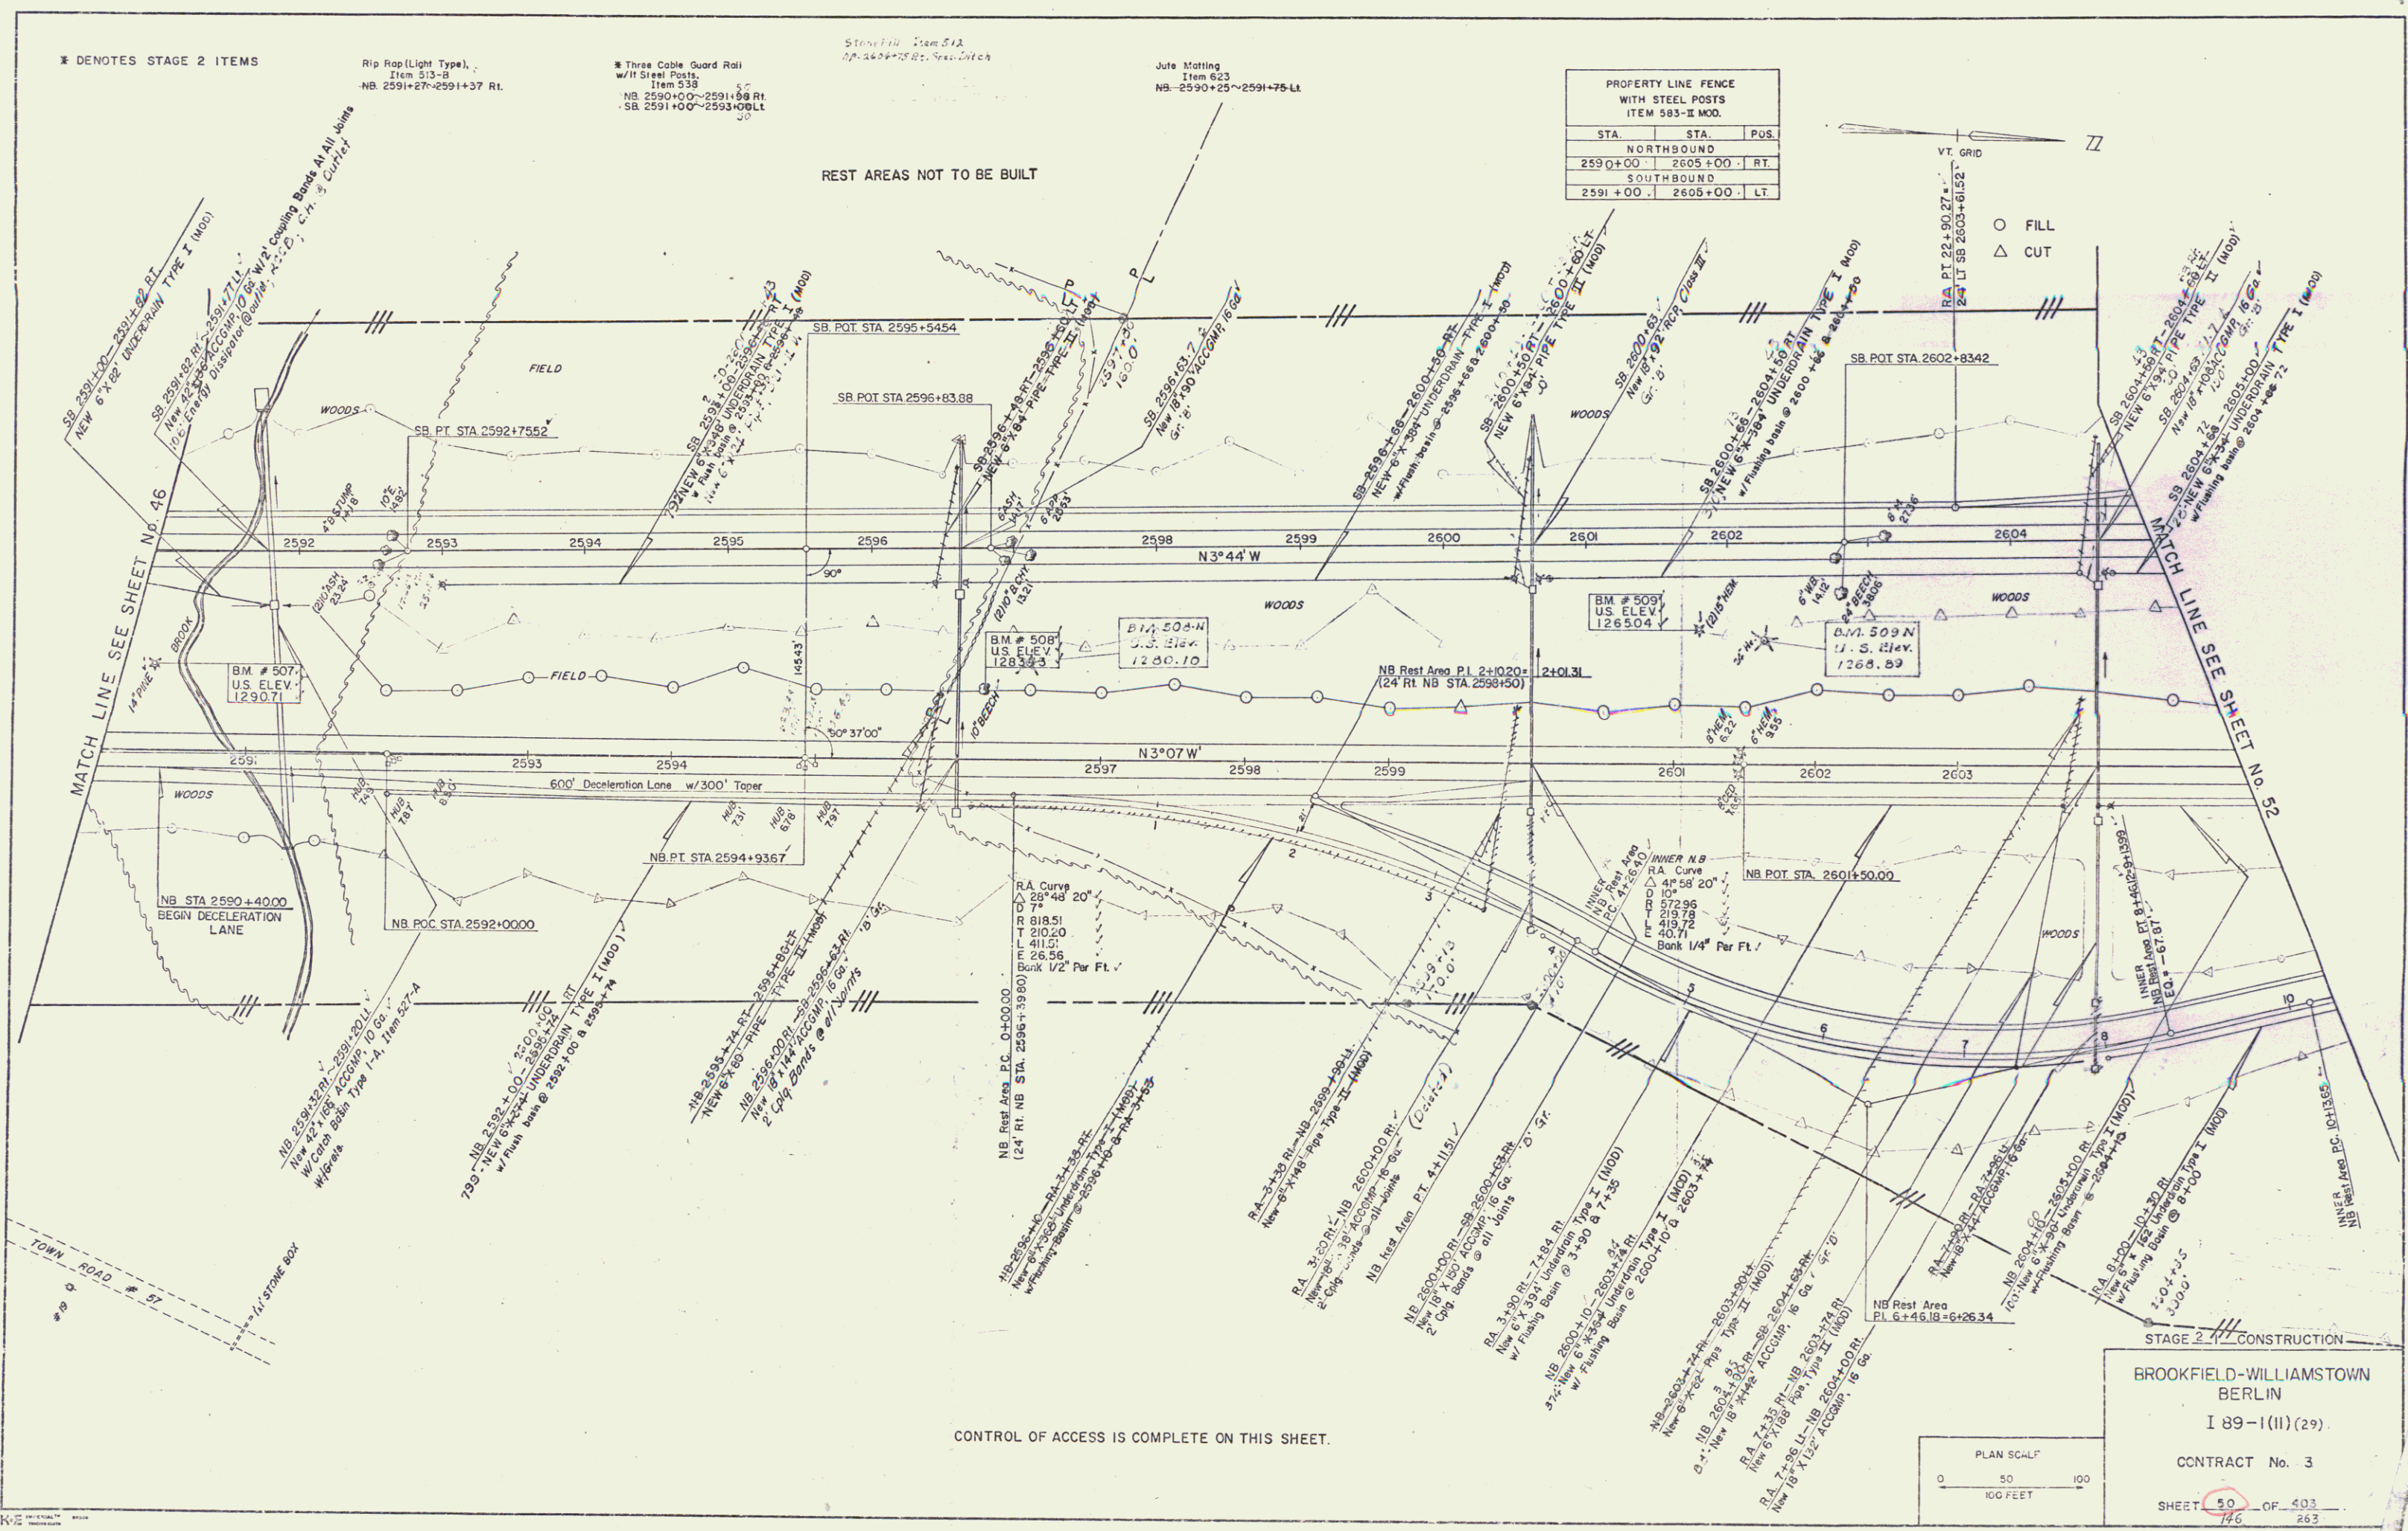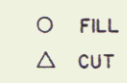

POSTER, O'BRIEN & HANCOCK
CONSULTING ENGINEERS NEWBURGH, N.Y.

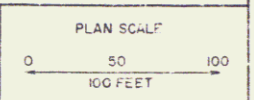

STAGE 2 CONSTRUCTION
 BROOKFIELD-WILLIAMSTOWN
 BERLIN
 I 89-1(II) (29)
 CONTRACT No. 3
 SHEET 50 OF 403
 146 263