

★ DENOTES STAGE 2 ITEMS


REST AREAS NOT TO BE BUILT

SB REST AREA
 L 23'00 RT
 D 4°53'17"
 R 1172.17
 T 238.48
 L 470.54
 E 23.92
 BANK 1/4" PER FT.

DRILLING AND BLASTING OF
 SOLID ROCK SUBGRADE, ITEM 115
 NB 2607+25 - 2608+25
 2608+25 - 2609+25
 2609+25 - 2610+25


PROPERTY LINE FENCE WITH
 STEEL POSTS, ITEM 583-II MOD

STA.	STA.	POS
NORTHBOUND		
2605+00	2620+00	ZI RT
SOUTHBOUND		
2605+00	2620+00	LI LT

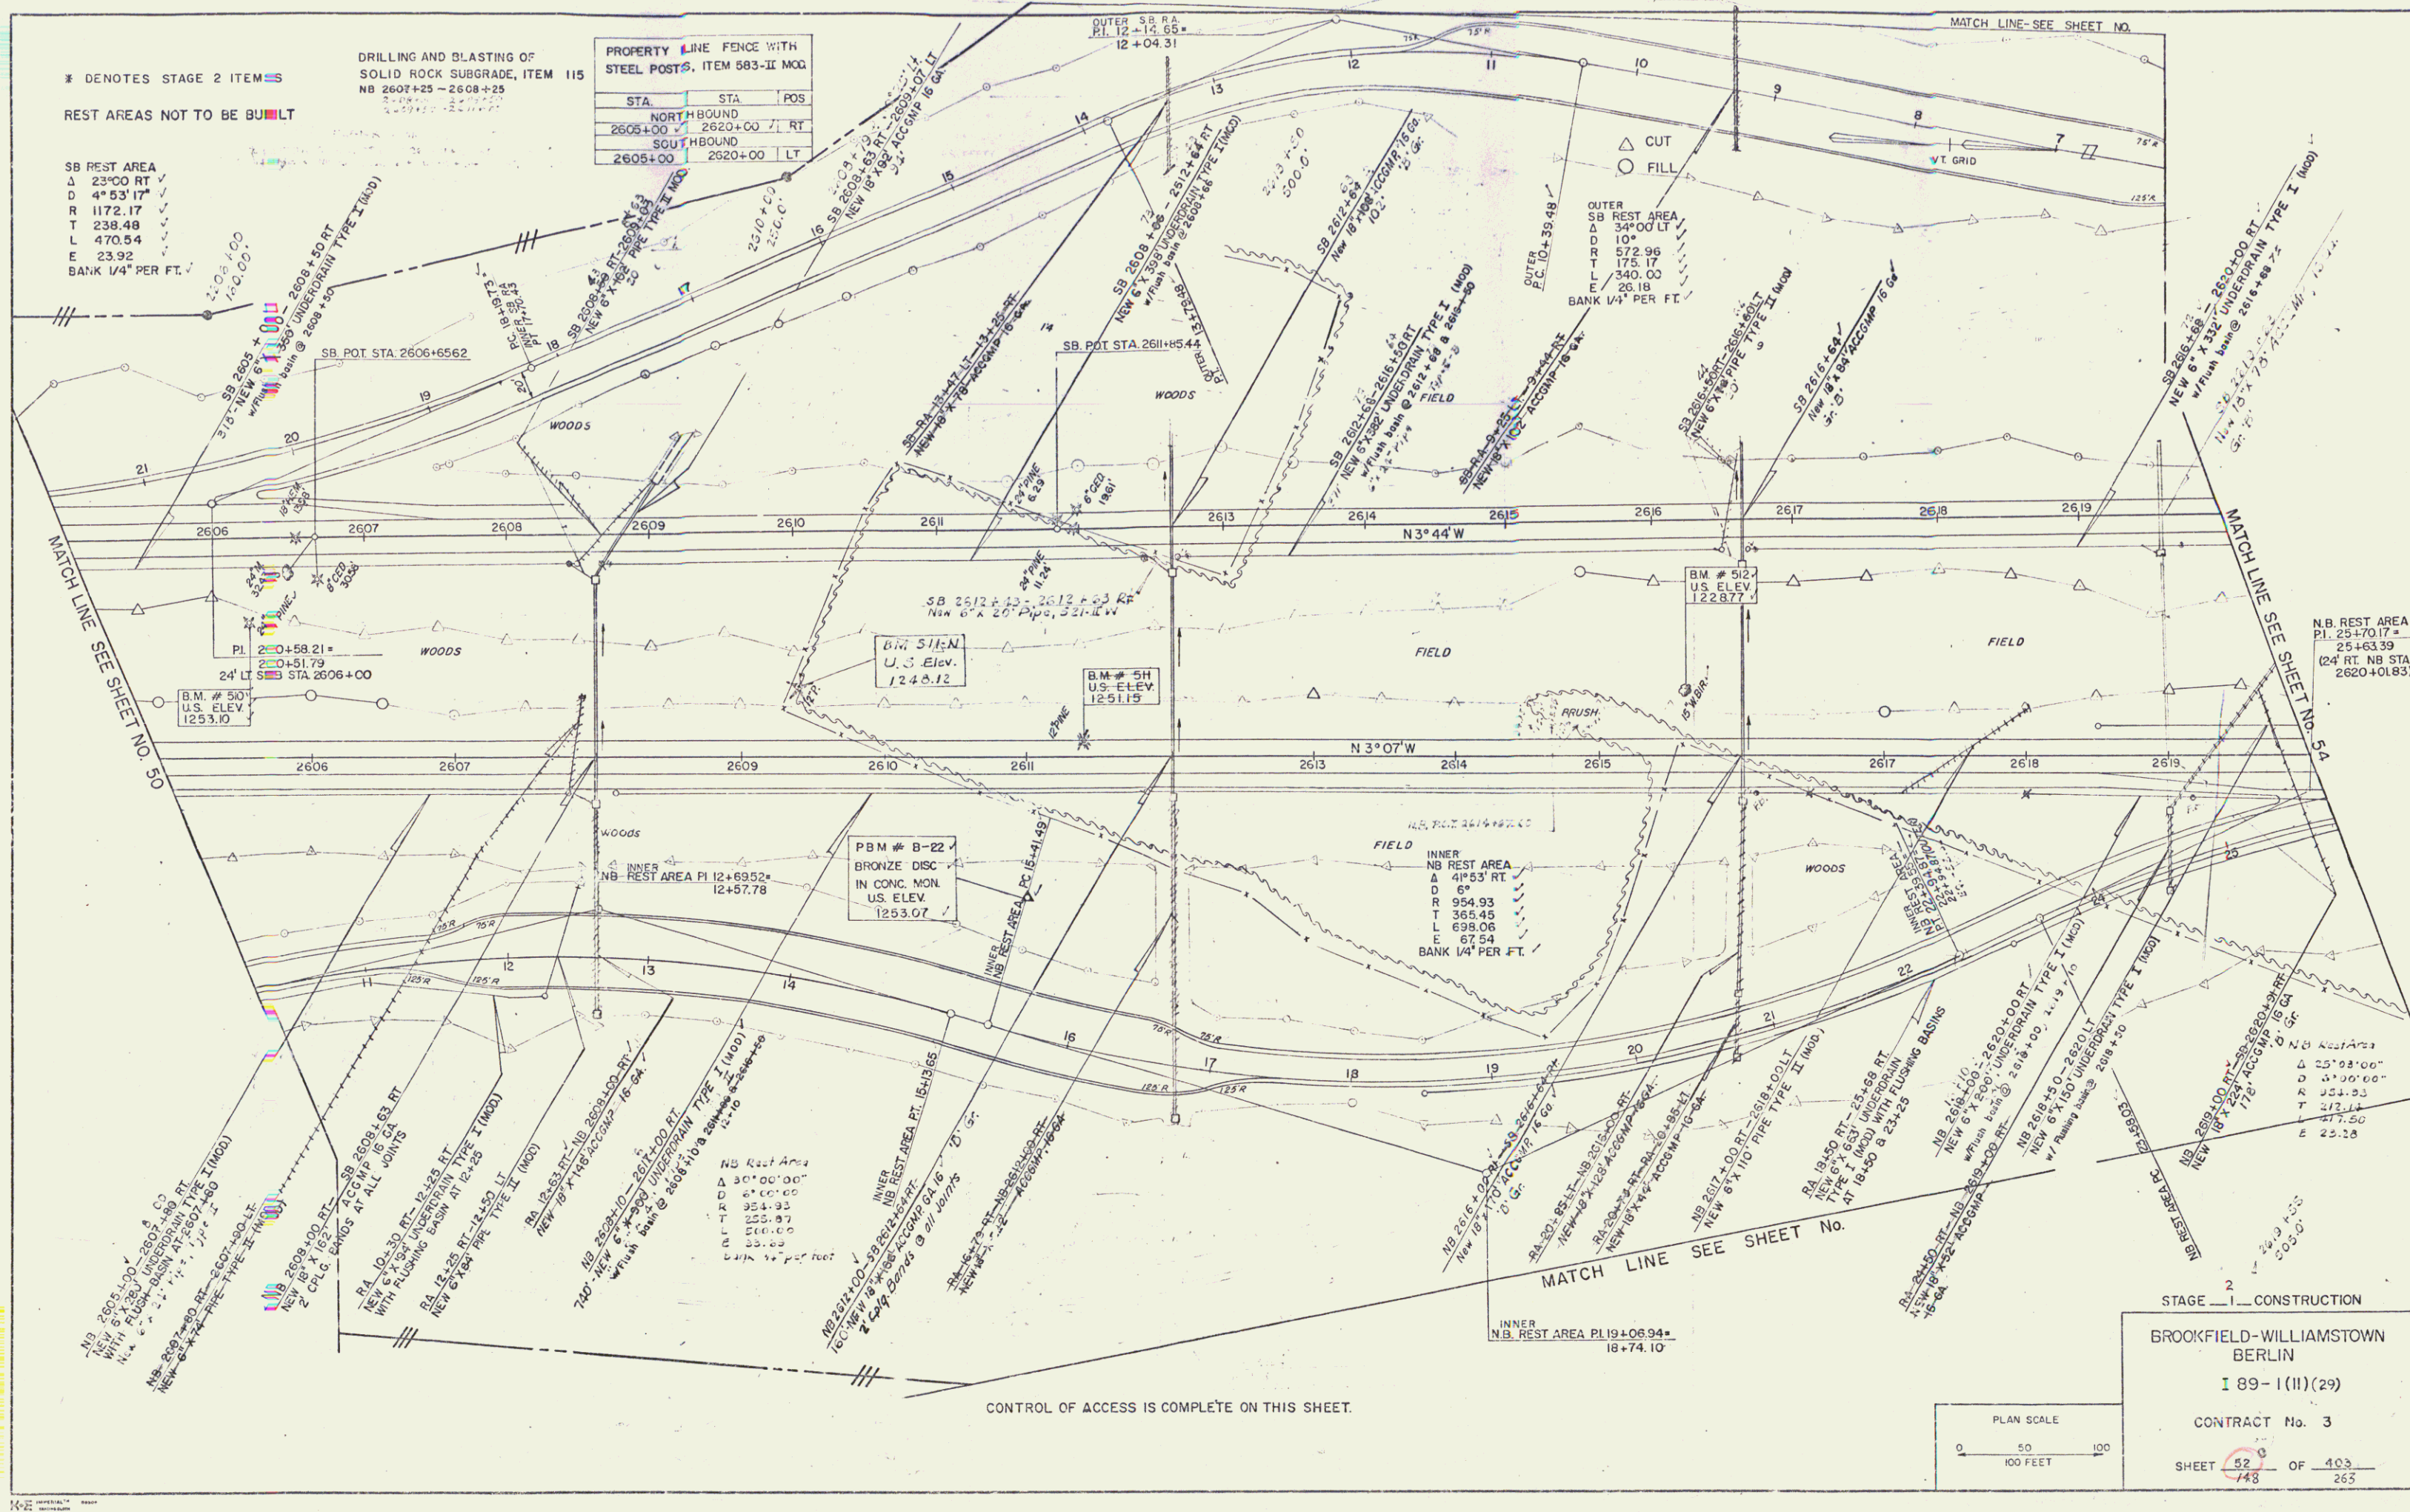

PORTER, CURRIE & ASSOCIATES
 CONSULTING ENGINEERS
 1100 WEST 10TH AVENUE
 DENVER, CO 80202

CONTROL OF ACCESS IS COMPLETE ON THIS SHEET.

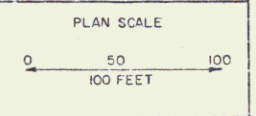

STAGE 1 - CONSTRUCTION

**BROOKFIELD-WILLIAMSTOWN
 BERLIN**

189-1(11)(29)

CONTRACT No. 3

SHEET 52 OF 403
 148 265