

* DENOTES STAGE 2 ITEMS

Stone Fill For Slope Protection (Light Type), Item 512
SB 2634+20~2634+75 Lt.
NB 2623+82~2623+92 Rt.


Rip Rip (Light Type), Item 513-B
NB 2623+82~2623+92 Rt.

Three Cable Guard Rail w/ Lt. Steel Posts, Item 518
NB 2623+58~2626+00 Rt.

Jute Matting, Item 623
NB 2624+90~2626+25 Lt.

PROPERTY LINE FENCE WITH STEEL POSTS ITEM 583-II MOD.		
STA.	STA.	POS.
NORTHBOUND		
2620+00	2635+00	RT.
SOUTHBOUND		
2620+00	2636+00	LT.

○ FILL
△ CUT

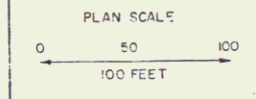

STAGE 2 CONSTRUCTION
BROOKFIELD-WILLIAMSTOWN
BERLIN
I 89-1 (II) (29)
CONTRACT No. 3
SHEET 54 OF 150

CONTROL OF ACCESS IS COMPLETE ON THIS SHEET.

OWNER: CHERIE & ARMSTRONG CONSULTING ENGINEERS AND ARCHITECTS, INC.