



* DENOTES STAGE 2 ITEMS

- Rip Rap (Light Type), Item 513-B
- Three Cable Guard Rail w/11 Steel Posts, Item 538
- Jute Matting, Item 623
- NB 2541+39~2541+49 RT
- NB 2546+47~2546+53 RT
- NB 2590+18~2590+24 RT
- NB 2638+96~2642+48 RL
- NB 2639+38~2644+98 LL-1
- NB 2639+40~2645+98 RL-2
- SB 2636+00~2636+88 LL-1
- SB 2639+40~2645+48 LL-2

PROPERTY LINE FENCE WITH STEEL POSTS ITEM 583-1E MOD.		
STA.	STA.	POS.
NORTHBOUND		
2635+00	2651+00	RT
SOUTHBOUND		
2636+00	2651+00	LT

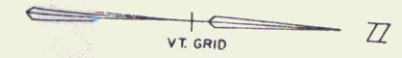

○ FILL
△ CUT

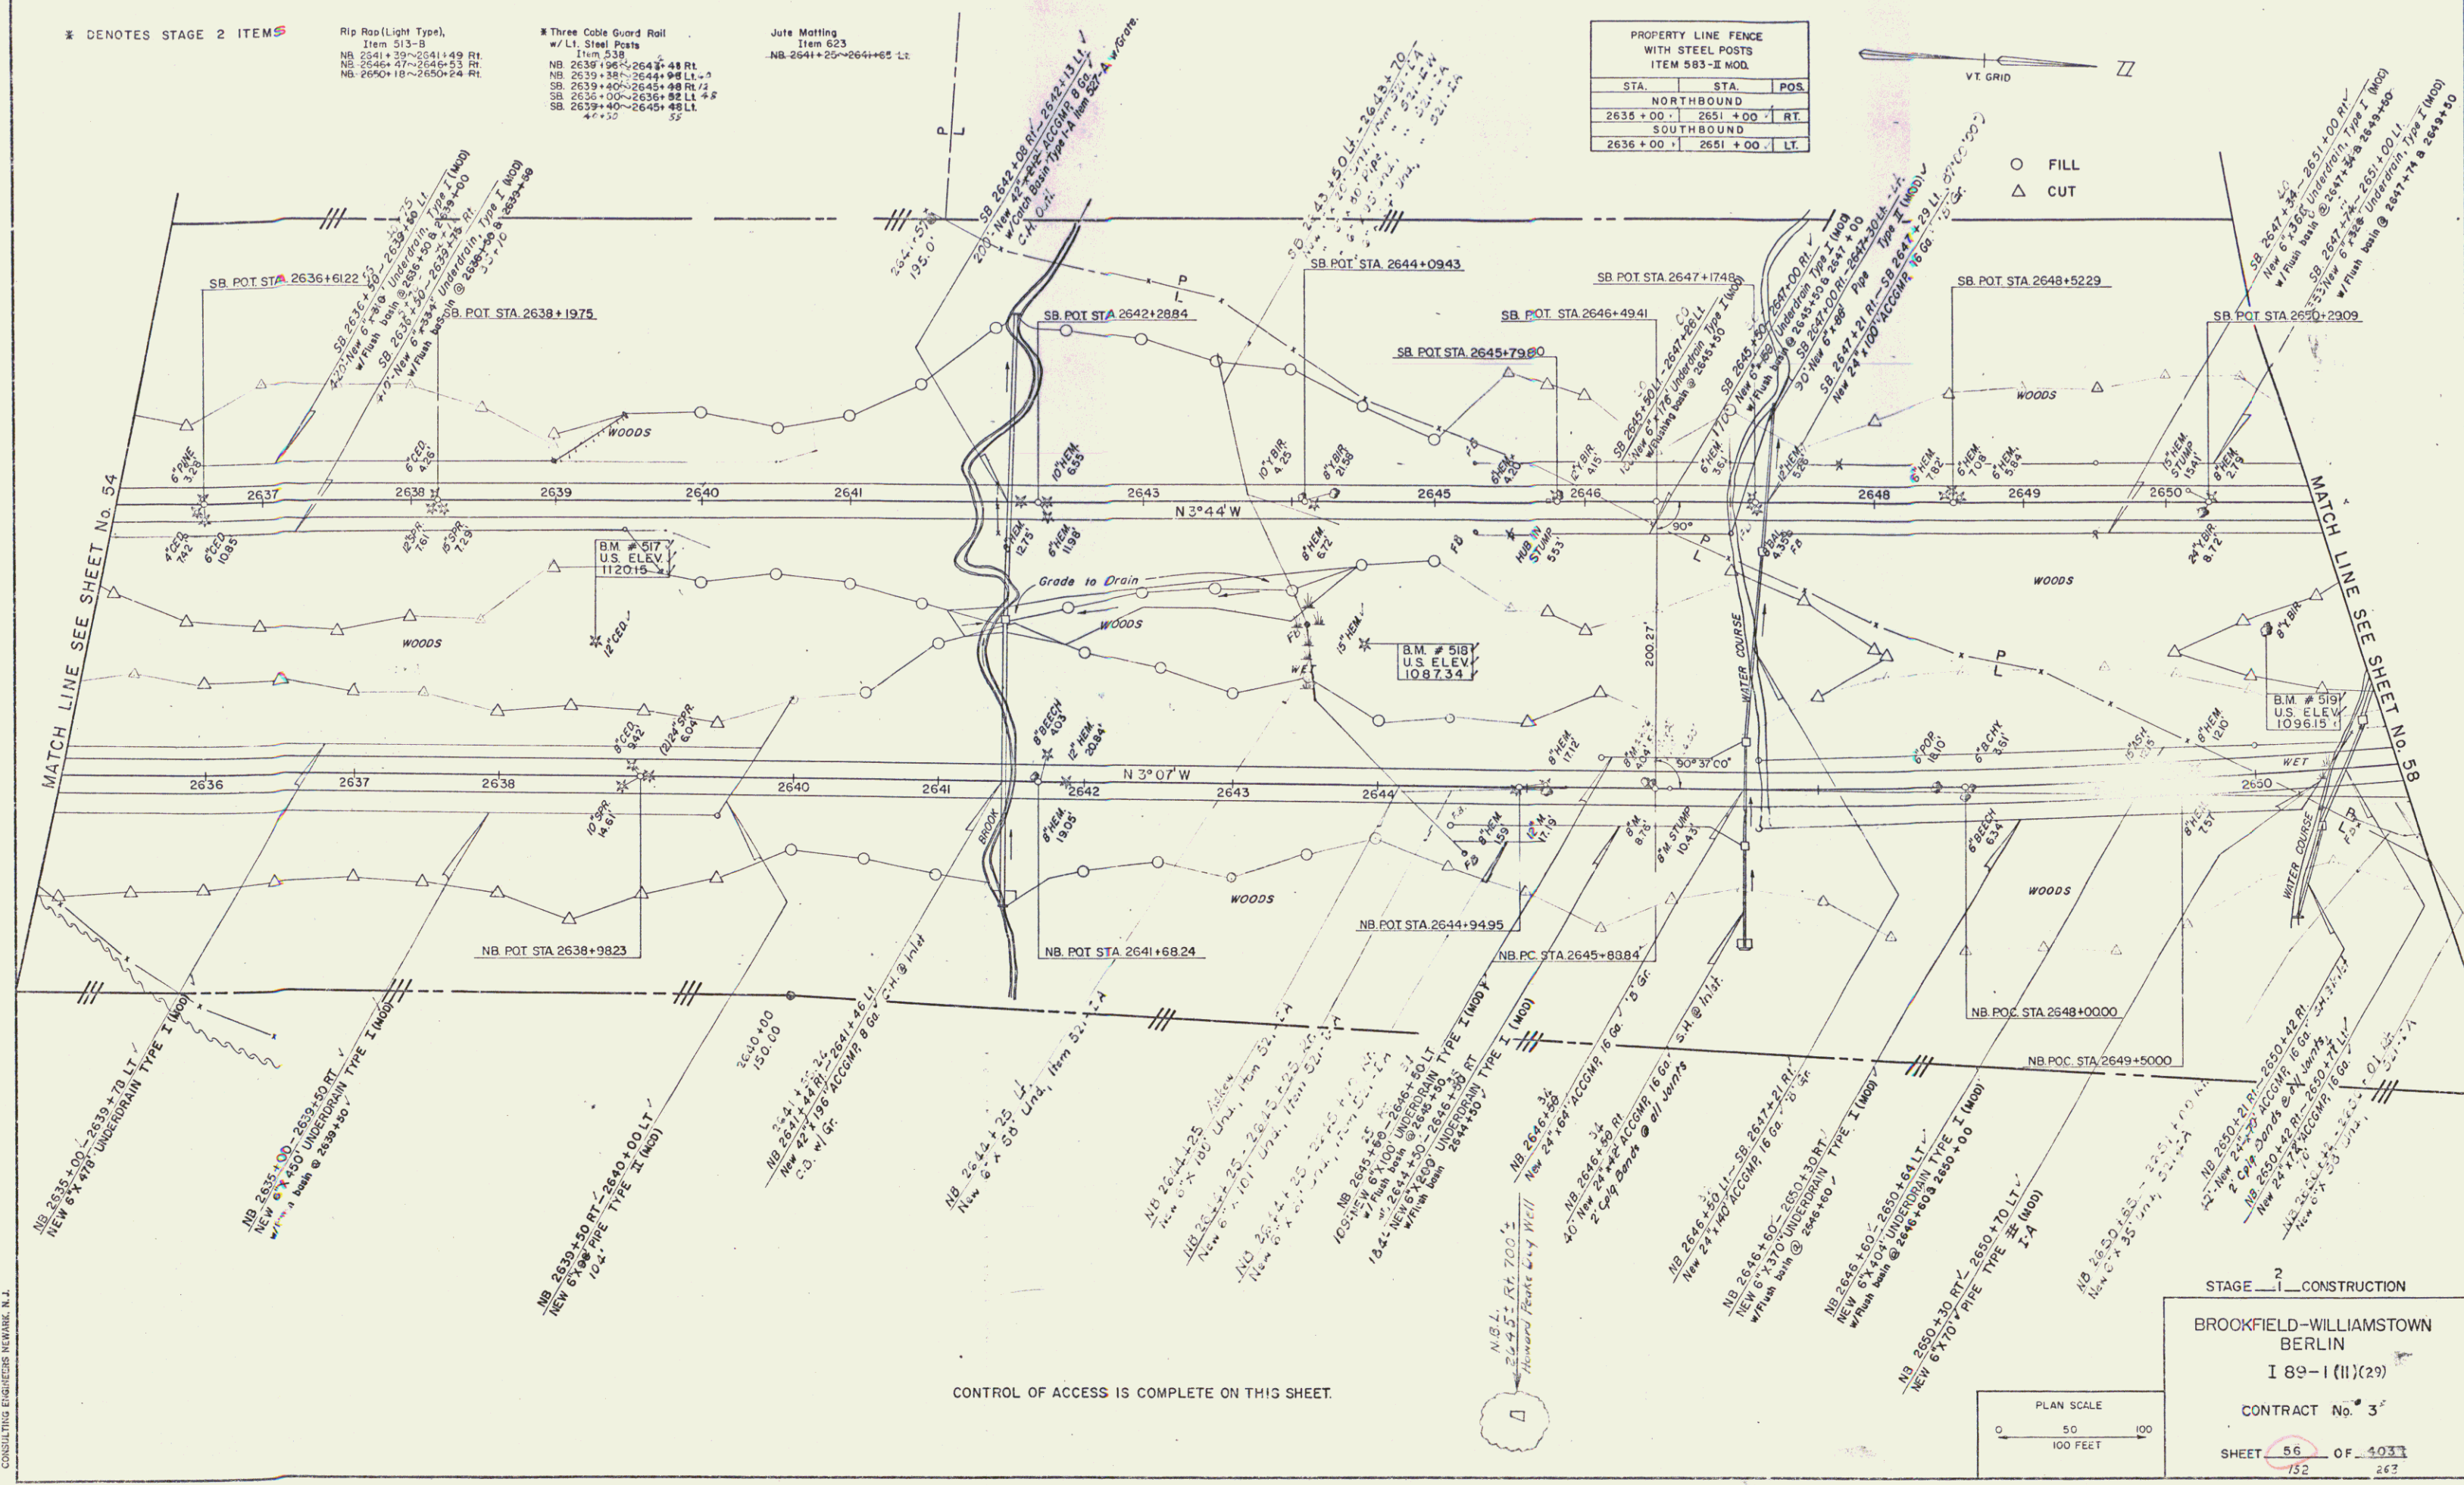

MATCH LINE SEE SHEET No. 54

MATCH LINE SEE SHEET No. 58

CONTROL OF ACCESS IS COMPLETE ON THIS SHEET.

PORTER, O'BRIEN & ARMSTRONG
CONSULTING ENGINEERS NEWARK, N.J.

STAGE 2 CONSTRUCTION

BROOKFIELD-WILLIAMSTOWN
BERLIN

I 89-1 (11)(2)

CONTRACT No. 3

SHEET 56 OF 103

