

SA#1 - 24+00
 BEGIN CONSTRUCTION
 Orig. P.I. 21+55.0 =
 Rev. Surv. Pl. 24+77.00
 Δ 6'38" LT

Stone Fill for Slope
 Protection
 SA #1 31+50-35+00 RT
 NB 35+00-41+00 RT

PROPERTY LINE FENCE
 ITEM 203-II, MOD.
 SB 35+00-41+00 LT
 NB 35+00-41+00 RT

CONSTRUCT DRIVE
 SA#1 34+00 LT

SUBBASE OF SAND, ITEM 202
 NB 35+00-40+00
 SB 35+00-37+50
 SA#1 35+00-36+25


SA #1
 Δ 28'45" LT
 D 3"
 R 1900.06
 T 454.12
 L 891.67
 bank 1/6 ft

2674+95.66
 END PROJECT
 I 89-1(11)(29)
 S.B. & { N 621.47020
 { E 478.91494

35+00
 BEGIN PROJECT
 I 89-1(12)(30)

Note:
 S.A.5 Constr.
 is not included
 in Proj. I 89-1(12)

CONTROL OF ACCESS IS COMPLETE ON THIS SHEET.
 S.A. #1 IS TO BE BUILT IN ITS ENTIRETY
 DURING STAGE I CONSTRUCTION.

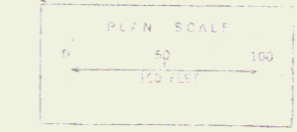

STAGE I CONSTRUCTION	
SURVEYED BY: M. Hutto	DATE: 5/6/03
DRAWN BY: [blank]	DATE: [blank]
TRACED BY: L. Clark	DATE: 5/6/03
BEDLIN-MONTPELIER	
PROJ. 7	NO. 09-1 (30)
SHEET 35	OF 25

Const 40