


SLOPE LOGGING
 Ramp C 17+25 = 21+00 (Island)
 Ramp D 5+06 = 12+00 Lt.
 * DENOTES STAGE II ITEMS

PROPERTY LINE FENCE
 ITEM 583-II, MOD.
 Ramp C 8+00 = 21+00 Lt.

DRILLING & BLASTING OF SOLID ROCK SUB GRADE, Item 115
 Ramp C 14+00 = 14+00 S
 Ramp C 15+26 = 21+00 S
 Ramp D 3+00 = 12+00 S

Job No. 115
 Ramp C 14+00 = 15+45 Lt.
 Ramp C 14+40 = 15+22 Lt.

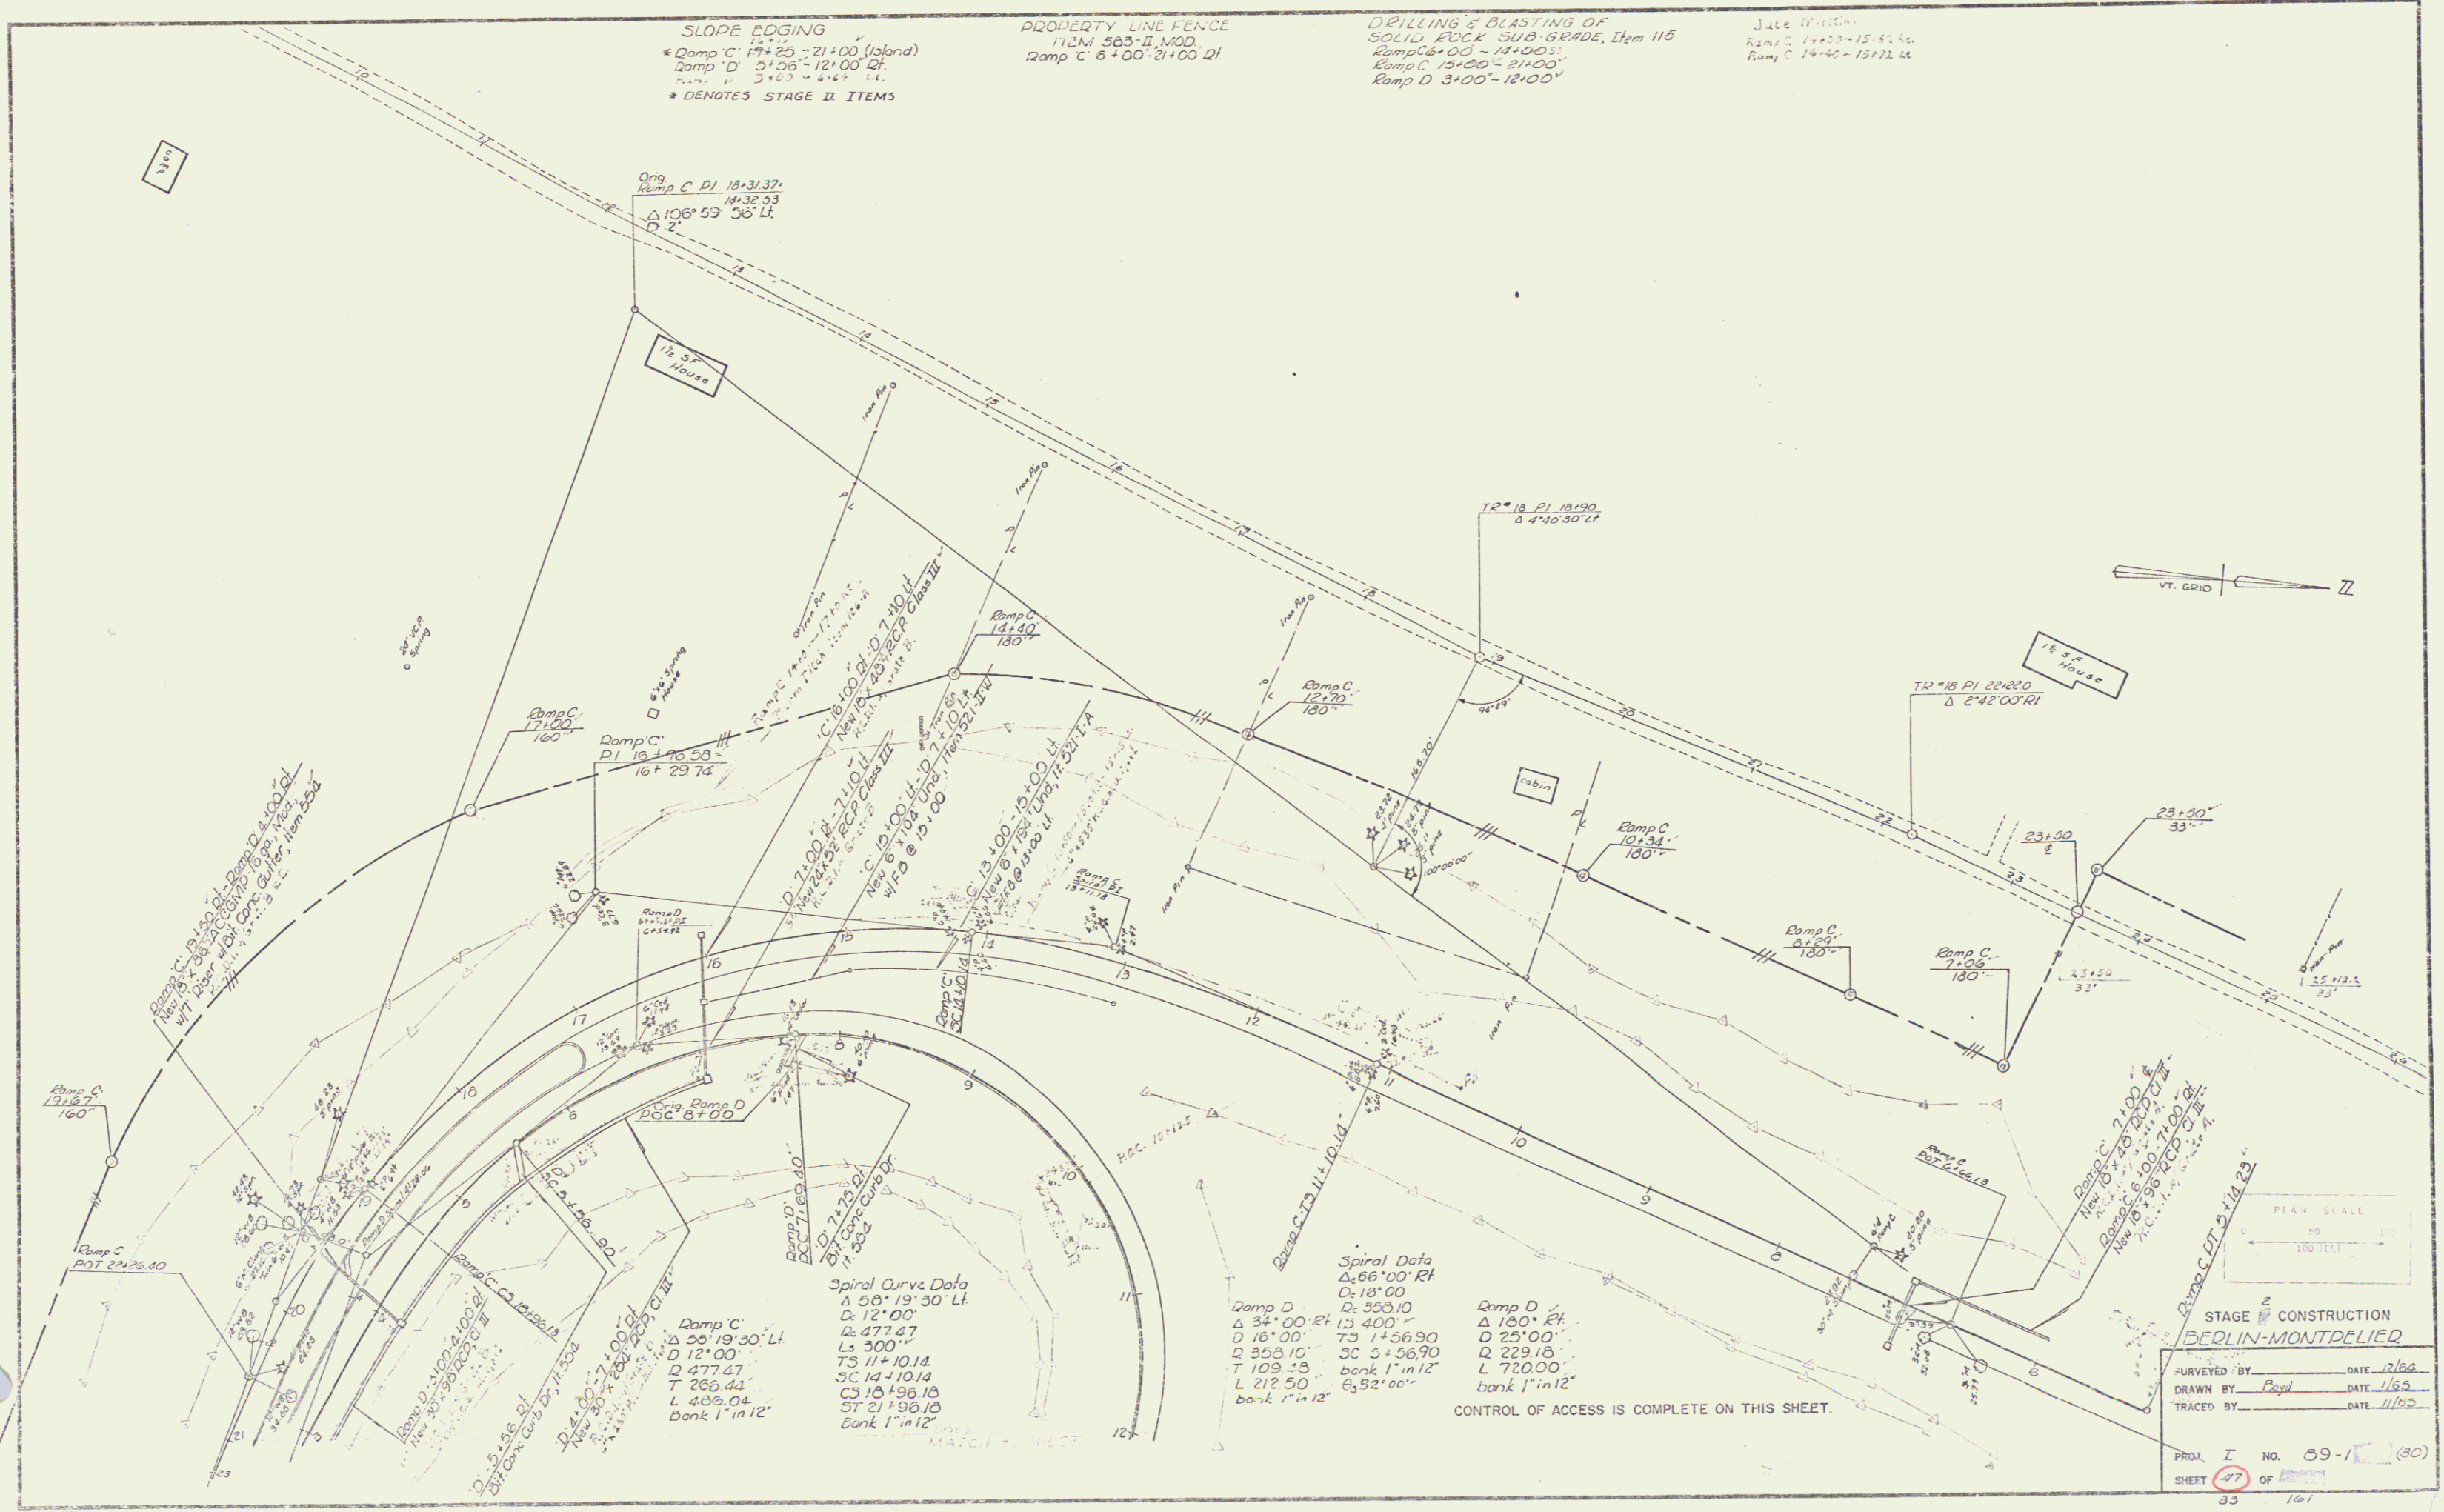

STAGE II CONSTRUCTION
BEDLIN-MONTELLIER

SURVEYED BY: _____ DATE: 1/69
 DRAWN BY: Boyd DATE: 1/69
 TRACED BY: _____ DATE: 1/69

PROJ. NO. 89-1 (80)
 SHEET 77 OF 80
 33 10/1
 const