


Drilling & Blasting of Sand Rock Subgrade
 T.M. # 12 35:00-36:12
 36:30-39:15

CONST. DRIVE
 42+45-43+00 Lt. (Paved)
 4+00 (paved)

Two Cable Guard Rail
 ITEM 541
 35+00-36+40 Rt. Lt.
 38+50-39+00 Rt. Lt.
 40+25-42+97 Rt.
 35+35-35+94 Lt.
 36+63-42+41 Rt.
 2+85-3+44 Lt.

Dev. Data:
 Δ 37° 20' Lt.
 D 10'
 E 372.96'
 T 193.56'
 L 373.33'
 E 31.01'
 Bank 3/4" per ft

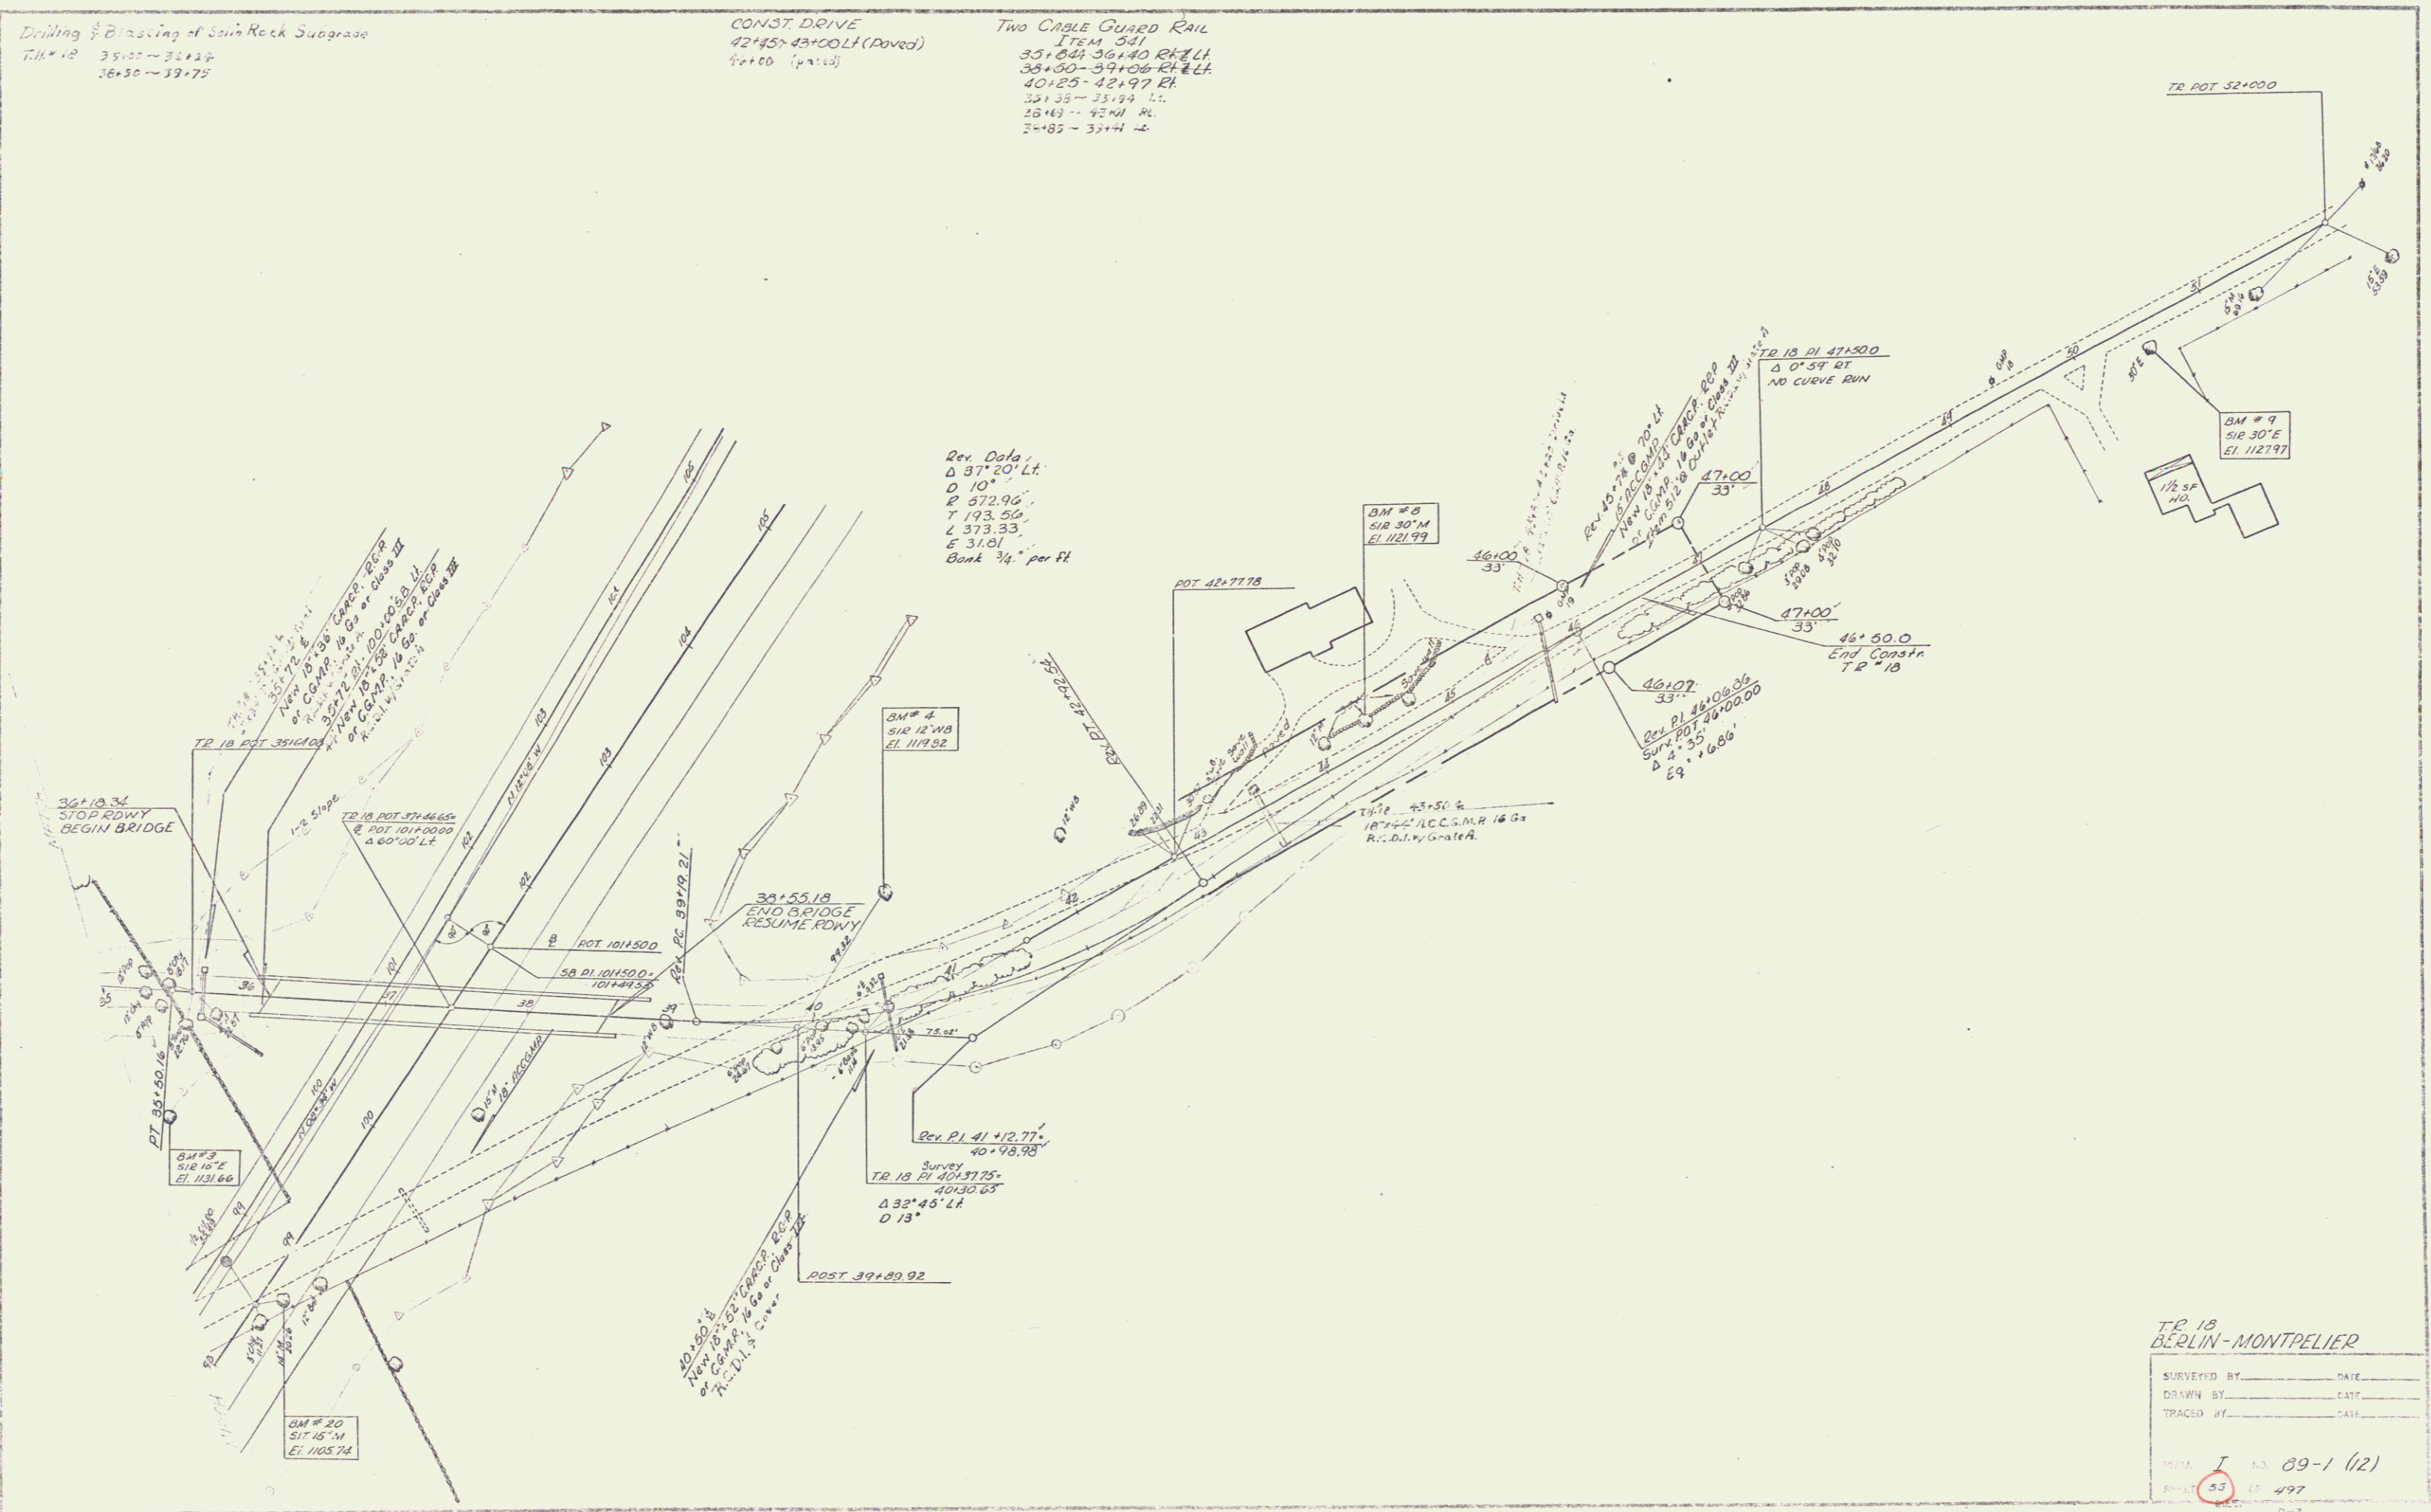

T.P. 18
 BERLIN-MONTPELIER

SURVEYED BY	DATE
DRAWN BY	DATE
TRACED BY	DATE

FORM I 3-3 89-1 (12)
 SHEET 53 OF 497
 CONST