


#1 - EVERETT H. B. KATHERINE WYMAN
(A-B.01) STA 193+32 - 205+10.

Base Line Curve Data
 L = 100.00'
 P = 230.00'
 T = 100.00'
 E = 2.0000'
 M = 200.00'

Curve No. 1
Superelevation Data

Sta 198+50 To 197+50	Tan Runout
197+50 To 20+50	Runout
20+50 To 22+00	Full Superelevation 1/16" per ft.
22+00 To 225+00	Runout
225+00 To 224+00	Tan Runout

NOTE:
Datum Sea Level Based on
Bench Line U.S.C. & G.S. Survey
Level line Vermont 25 (Second
Order)

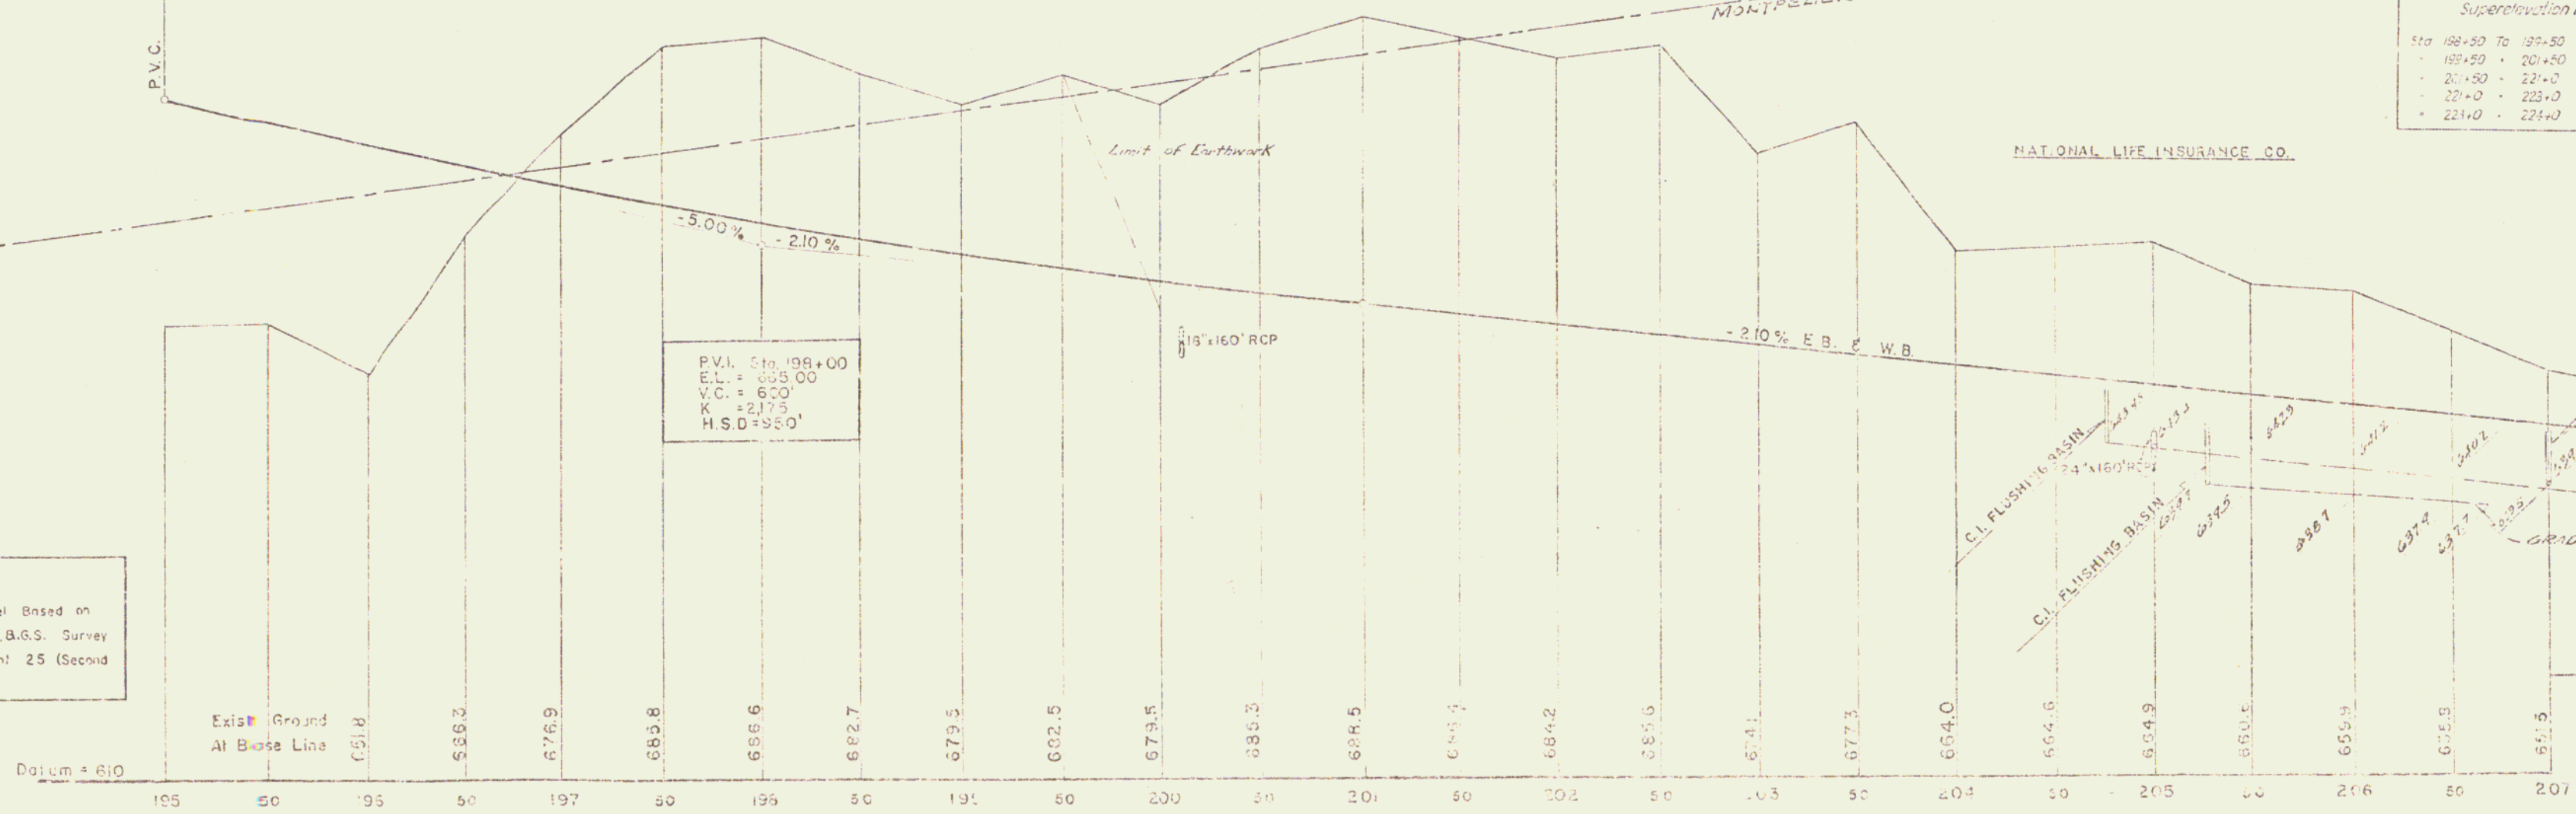

Datum = 610

195	50	95	50	197	50	198	50	199	50	200	50	201	50	202	50	203	50	204	50	205	50	206	50	207	50
651.8	656.2	676.9	685.8	696.6	692.7	679.5	662.5	679.5	685.3	688.5	690.9	684.2	685.5	674.1	677.3	664.0	664.6	654.9	650.6	655.9	651.5	649.5	644.0	642.7	641.5

30
PLAN AND PROFILE
S.M. 200+00 TO STA. 208+00