

GRANITE SLOPE EDGING

RAMP 'N' 52+39 TO 524+40 RT. ✓
 522+42 TO 525+27 LT. ✓
 RAMP 'O' 522+51 TO 524+64 RT. ✓
 522+51 TO 524+35 ISLAND ✓
 RAMP 'M' 523+38 TO 525+55 RT. ✓
 524+25 TO 526+86 LT. ✓
 RAMP 'H' 15+00 TO 18+43 ISLAND ✓
 19+20 TO 27+00 ISLAND ✓




3 CABLE GUARD RAIL WITH STEEL POSTS

RAMP -
 STA 52+00 LT TO 17+50 LT ✓
 STA 52+00 LT TO 26+86 LT ✓
 STA 5+00 RT TO 26+08 RT ✓
 RAMP -
 STA 52+00 RT TO 52+40 RT ✓
 RAMP -
 STA 52+00 LT TO 52+40 LT ✓
 STA 52+00 RT TO 52+40 RT ✓

Doc. No. 1000-21-50 LT

GRANITE SLOPE EDGING (CONTINUED)

RAMP 'O' 523+32 TO 524+65 LT. ✓
 RAMP 'H' 16+35 TO 18+78 LT. ✓
 19+22 TO 20+80 LT. ✓

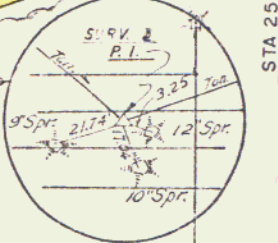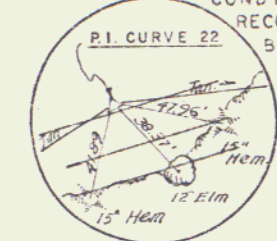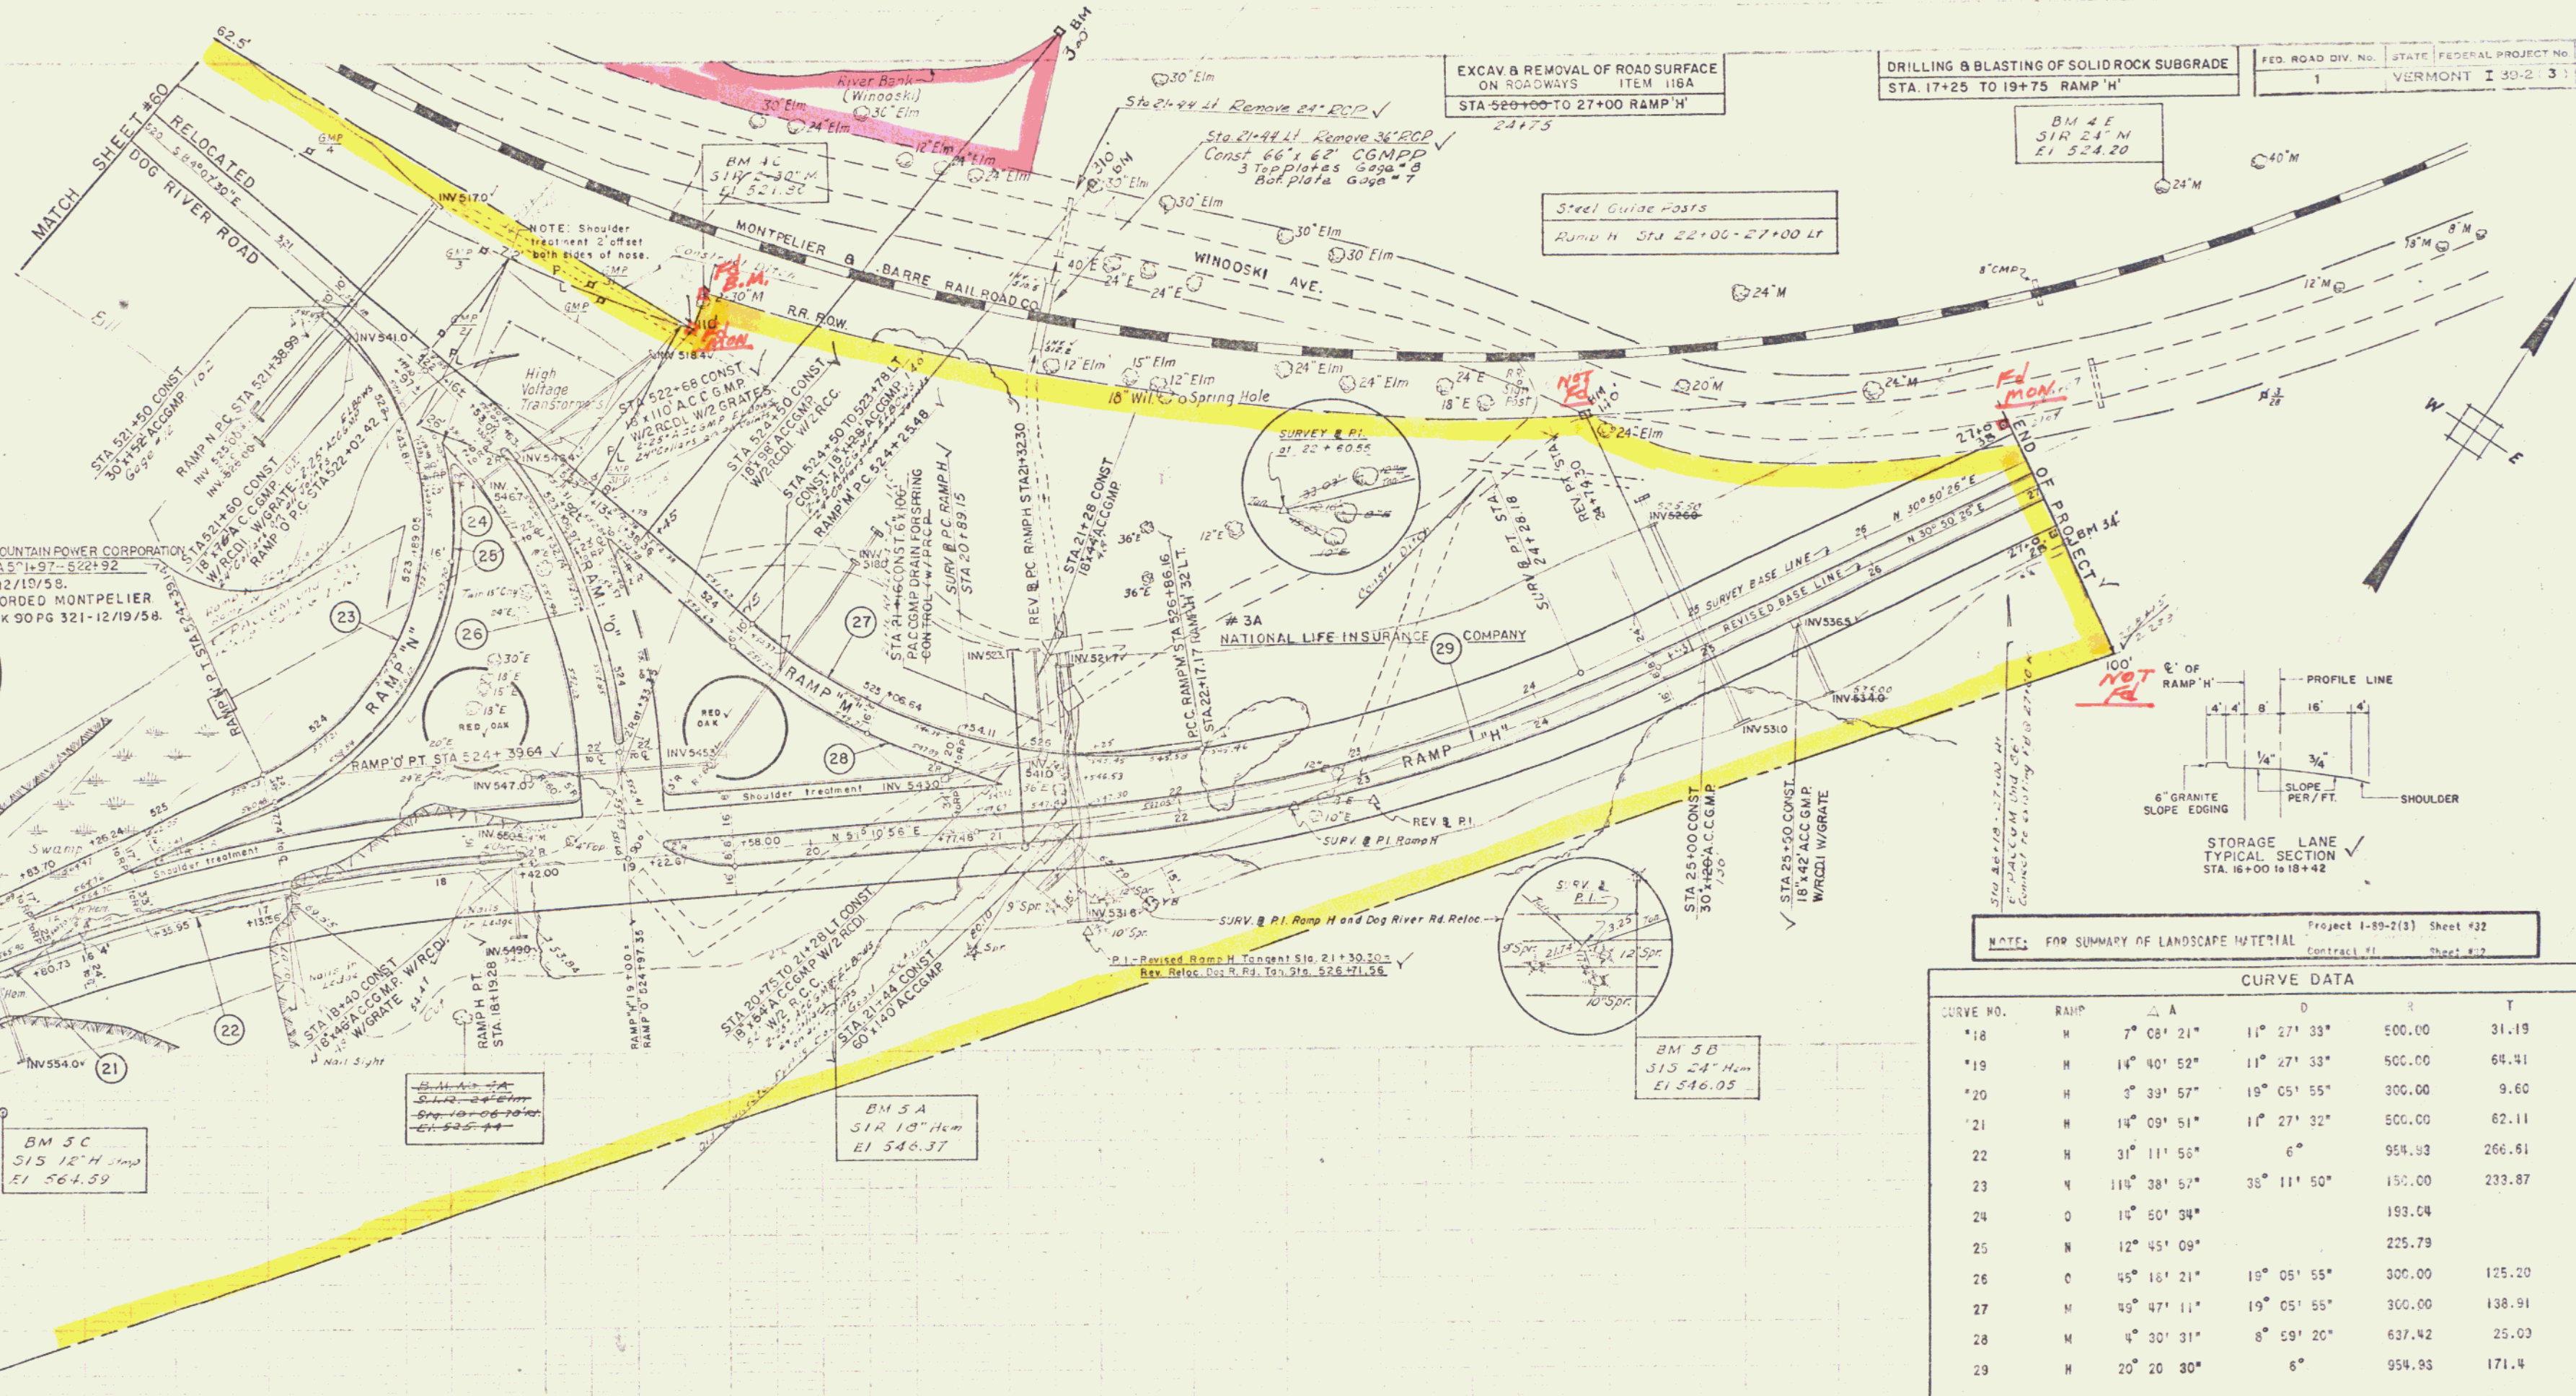

NOTE: FOR SUMMARY OF LANDSCAPE MATERIAL Project I-89-2(3) Sheet 432 Contract #1 Sheet #17

CURVE DATA

CURVE NO.	RAMP	A	D	T	ARC L	
*18	H	7° 08' 21"	11° 27' 33"	500.00	31.19	62.30 ✓
*19	H	14° 40' 52"	11° 27' 33"	500.00	64.41	128.12 ✓
*20	H	3° 39' 57"	19° 05' 55"	300.00	9.60	19.19 ✓
*21	H	14° 09' 51"	11° 27' 32"	500.00	62.11	123.60 ✓
*22	H	31° 11' 56"	6°	954.93	266.61	519.96 ✓
*23	H	119° 38' 57"	35° 11' 50"	150.00	233.87	300.15 ✓
*24	O	14° 50' 34"		193.04		50.01 ✓
*25	N	12° 45' 09"		225.79		50.25 ✓
*26	O	45° 16' 21"	19° 05' 55"	300.00	125.20	237.22 ✓
*27	M	49° 47' 11"	19° 05' 55"	300.00	138.91	200.68 ✓
*28	M	4° 30' 31"	8° 59' 20"	637.42	25.03	50.19 ✓
*29	H	20° 20' 30"	6°	954.93	171.4	339.00 ✓

* SEE MATCH SHEET NO. 56

