

PLAIN GUARD RAIL  
W/ PRESERVATIVE  
TREATMENT  
Sta. 498+00 - 499+00

3 CABLE GUARD RAIL WITH STEEL POSTS  
Sta 498+50 - 504+50 L.V.  
Sta 504+50 - 505+00 L.V.

EXCAVATION & REMOVAL OF ROAD SURFACE  
- ON ROAD -  
ITEM 115A  
- STA. 504+00 - 506+00 L.V. -

#4 EMMA M. SANBORN


QCD dated 4/29/68 BK? Pg?  
All RTI, to City of Montpelier  
from 265' west of 239+90 thence  
205' southeasterly & southerly

Standard ReflectORIZED  
Railroad Advance Warning Signs  
to be erected by State  
Approx. 500 ft. from crossing

Standard ReflectORIZED  
Railroad Advance Warning Signs  
to be erected by State  
Approx. 500 ft. from crossing

New Railroad crossing and Railroad crossing  
signs to be constructed and erected by the  
Central Vermont Railway Inc.

Δ 427-30' RT 126°18'  
D 18'  
R 3/8 31  
T 45-5 623.8  
L 708-3 701.7  
E 491.4

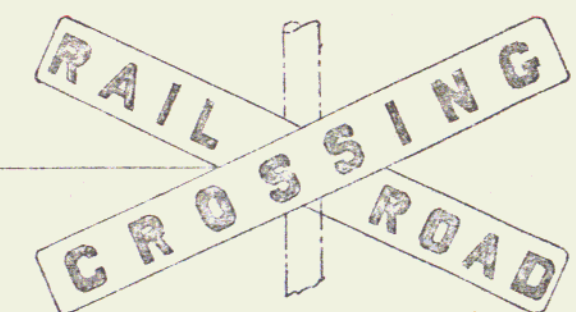

RAILROAD CROSSING SIGN  
Scale 1"=16'

DOG RIVER ROAD  
Project I 50-2(3)  
Sheet 59A of 800  
Cont.