

THREE CABLE GUARD RAIL WITH STEEL POST  
 STA. 359+00 to 375+00 WB R1  
 STA. 359+00 to 361+22 WB L1  
 STA. 359+00 to 375+00 EB L1

REMOVAL & DISPOSAL OF PRESENT GUARD RAIL ITEM 550  
 COVERED BY RELOCATION ROUTE #2

MUCK EXCAVATION STA. 368+90 to 371+30

EXCAV. & REMOVAL OF ROAD SURFACE ON ROADWAYS ITEM 118A  
 COVERED BY RELOCATION ROUTE #2


B.M. No. 64  
 Spot on Reg. 1  
 Elev. 516.30

B.M. No. 85  
 Elev. 505.88

CENTRAL VERMONT RAILROAD

R.O.W. Fence

R.R. R.O.W.

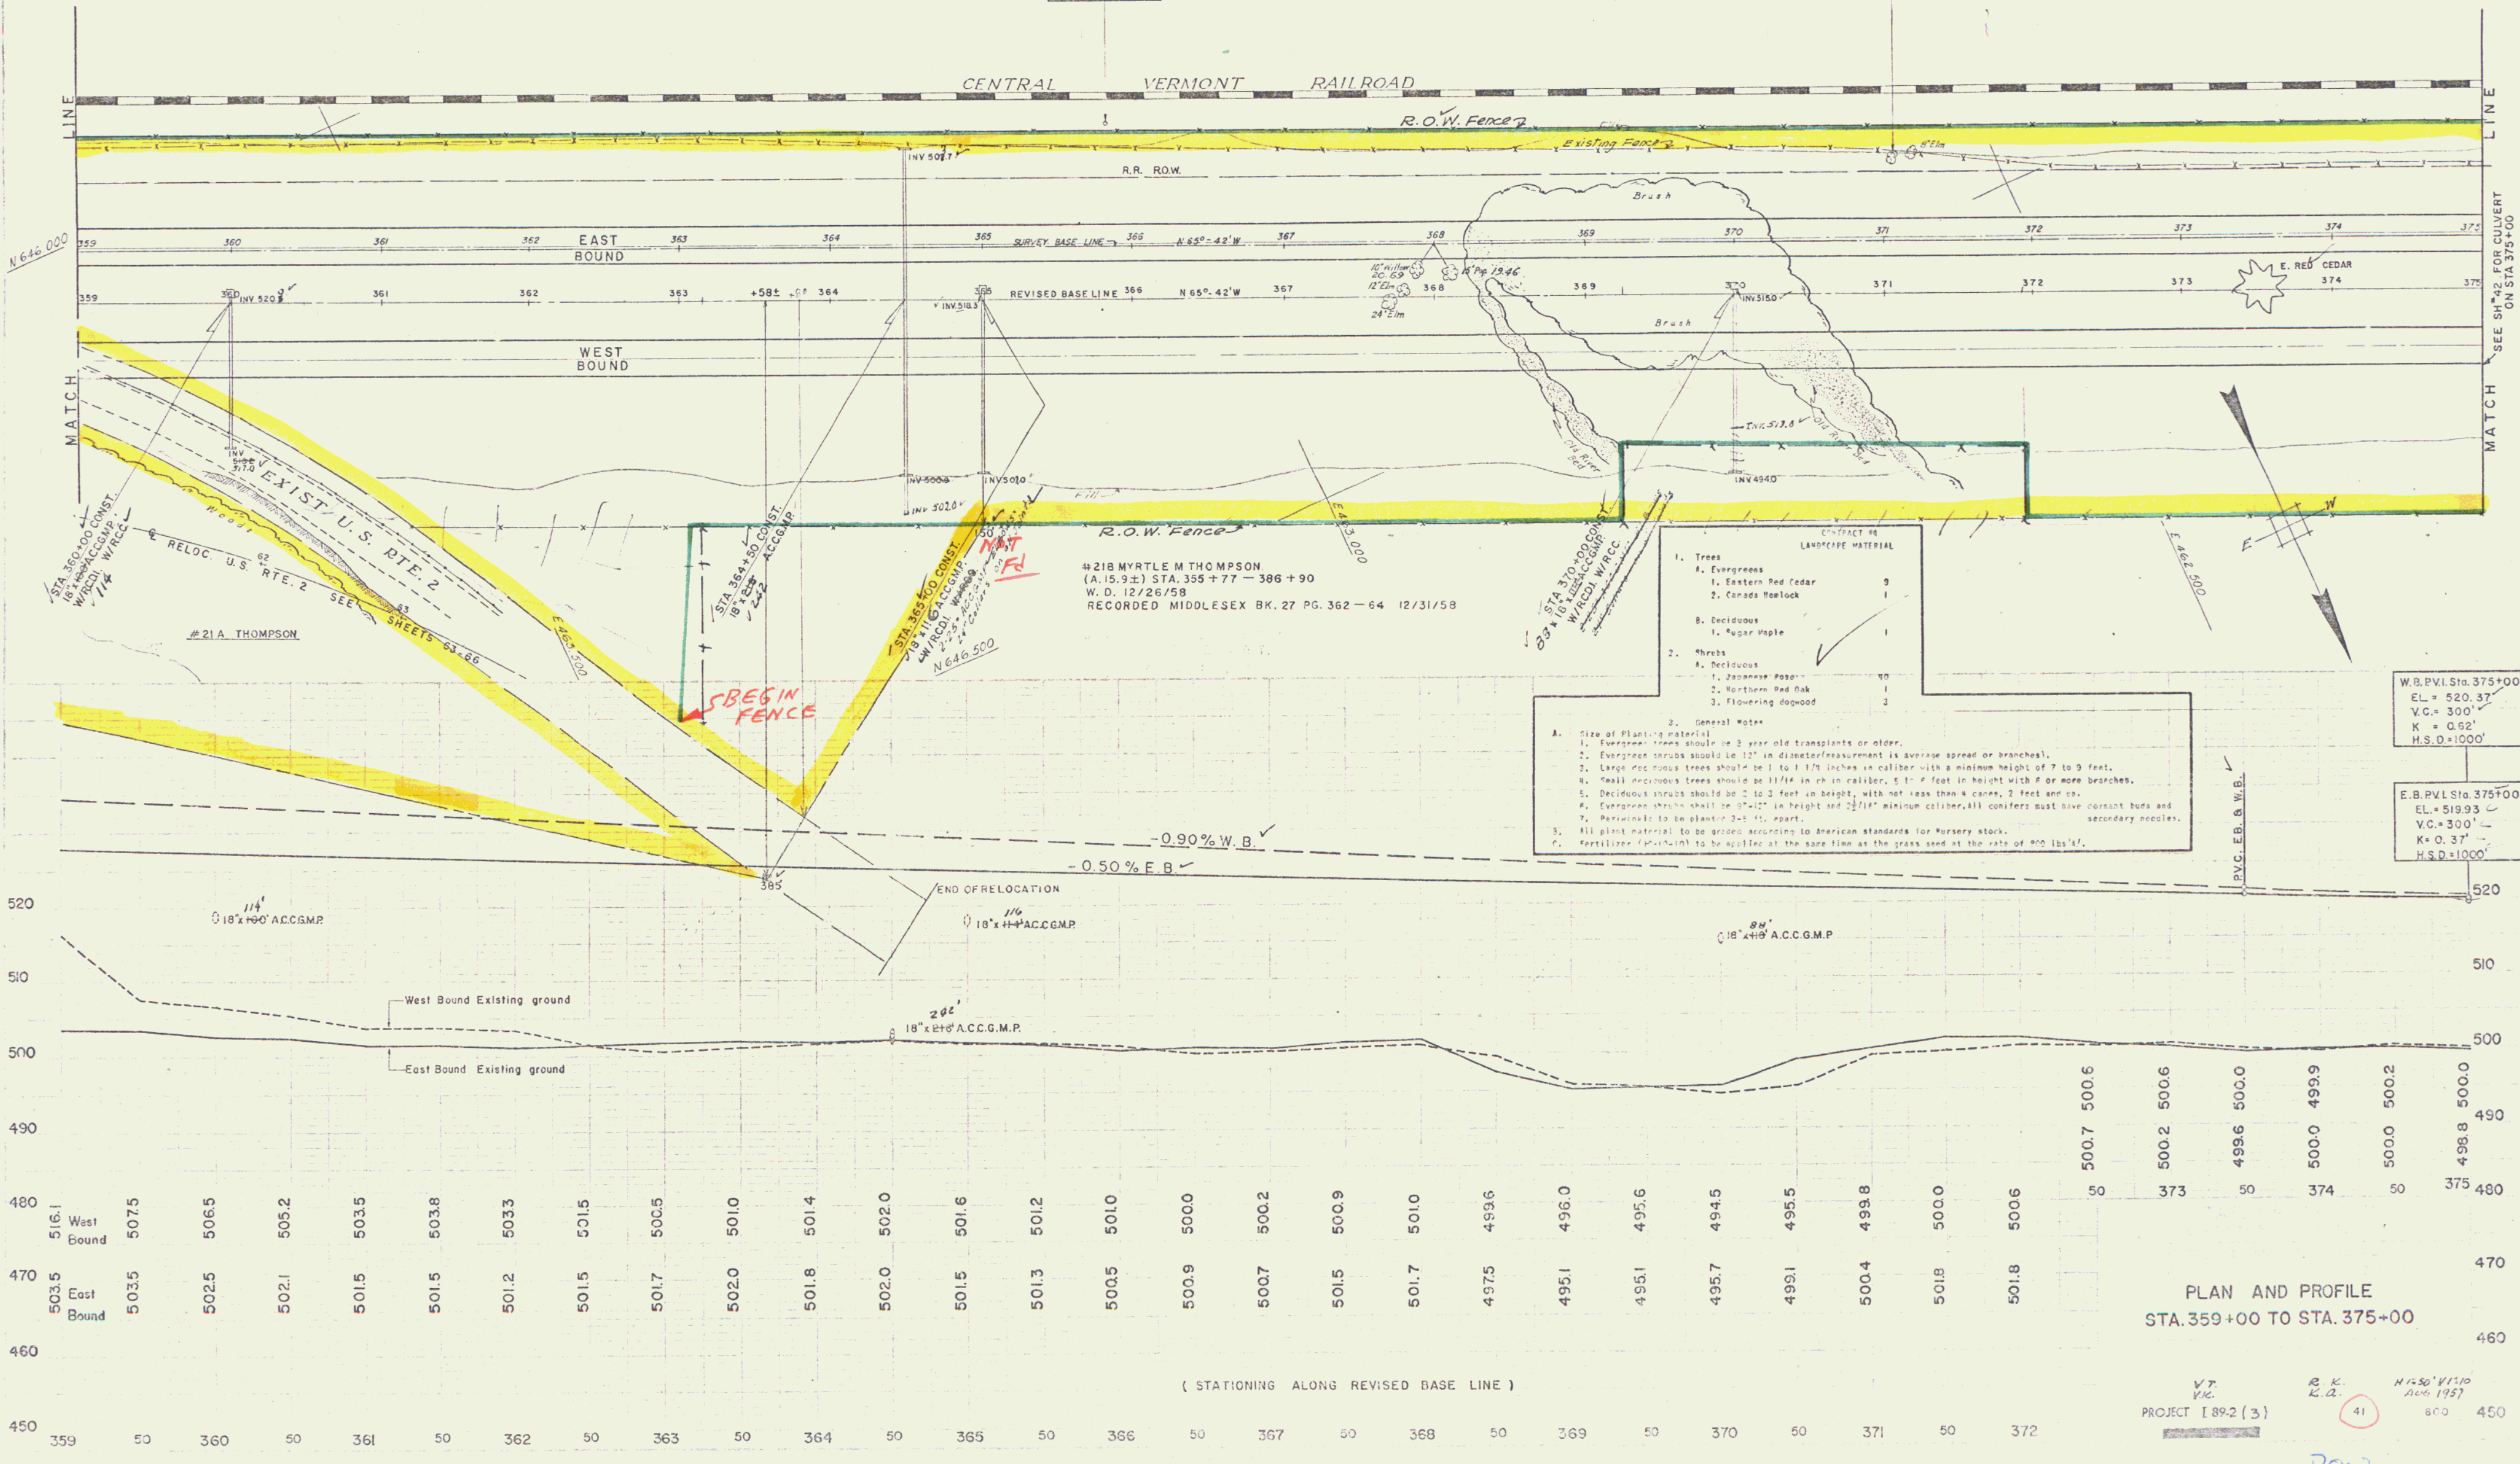

#218 MYRTLE M THOMPSON  
 (A 15.9±) STA. 355+77 - 386+90  
 W. D. 12/26/58  
 RECORDED MIDDLESEX BK. 27 PG. 362 - 64 12/31/58

**LANDSCAPE MATERIAL**

1. Trees

A. Evergreens

1. Eastern Red Cedar 9
2. Canada Hemlock 1

B. Deciduous

1. Sugar maple 1

2. Shrubs

A. Deciduous

1. Japanese Posa 10
2. Northern Red Oak 1
3. Flowering dogwood 3

3. General Notes

1. Size of planting material
1. Evergreen trees should be 3 year old transplants or older.
2. Evergreen shrubs should be 12" in diameter/measure at average spread or branches.
3. Large deciduous trees should be 1 to 1 1/2 inches in caliber with a minimum height of 7 to 9 feet.
4. Small deciduous trees should be 1 1/2" in db in caliber, 5 to 7 feet in height with 6 or more branches.
5. Deciduous shrubs should be 5 to 3 feet in height, with not less than 4 canes, 2 feet apart.
6. Evergreen shrubs should be 12-18" in height and 3/4" minimum caliber, all canes must have constant buds and secondary needles.
7. Perennials to be planted 2-3 ft. apart.
8. All plant material to be graded according to American standards for Nursery stock.
9. Fertilizer (phosphorus) to be applied at the same time as the grass seed at the rate of 100 lbs/af.

W.B. P.V.I. Sta. 375+00  
 EL. = 520.37  
 V.C. = 300'  
 K = 0.62  
 H.S.D. = 1000'

E.B. P.V.I. Sta. 375+00  
 EL. = 519.93  
 V.C. = 300'  
 K = 0.37  
 H.S.D. = 1000'

PLAN AND PROFILE  
 STA. 359+00 TO STA. 375+00

PROJECT [89-2 (3)]  
 41  
 800 450