


PLAN
 DATE: 12/31/58
 SCALE: AS SHOWN
 PROJECT: I-89(2) (3) SHEET #41
 CONTRACT #4

PROFILE
 DATE: 12/31/58
 SCALE: AS SHOWN
 PROJECT: I-89(2) (3) SHEET #41
 CONTRACT #4

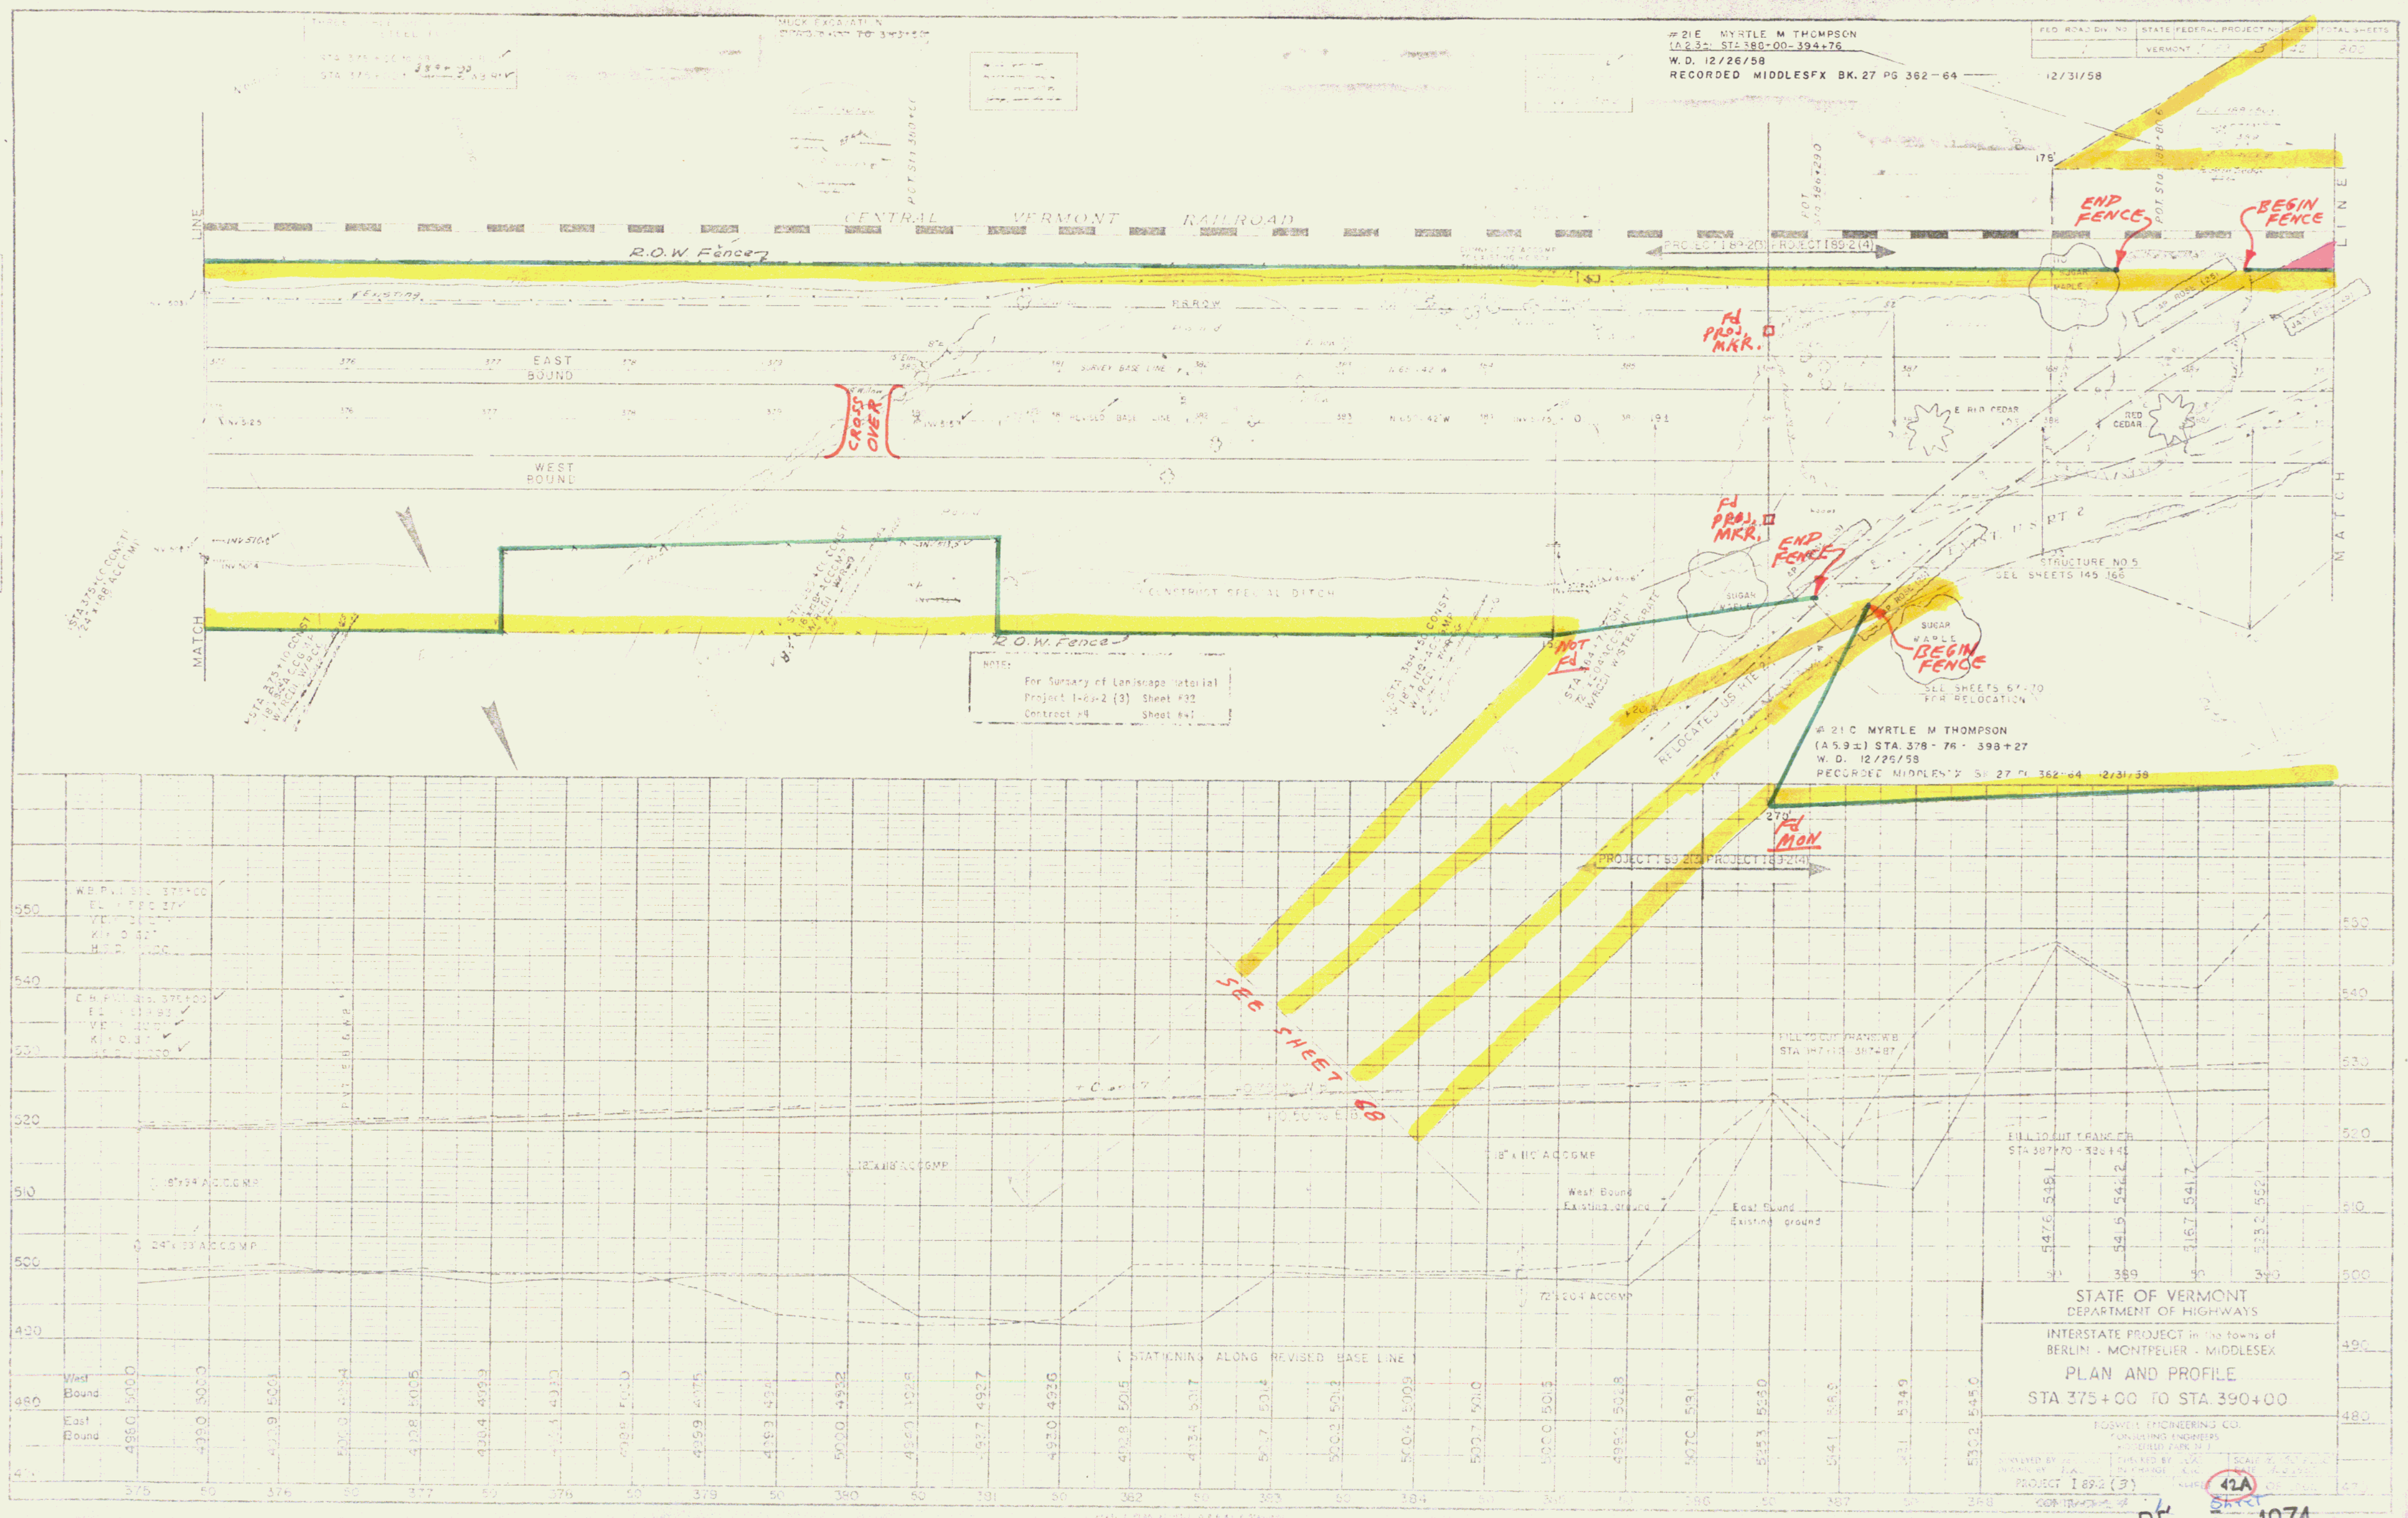

DEC 5 1974