


PROJECT NO. 49A
 DRAWN BY: [Name]
 CHECKED BY: [Name]
 DATE: [Date]

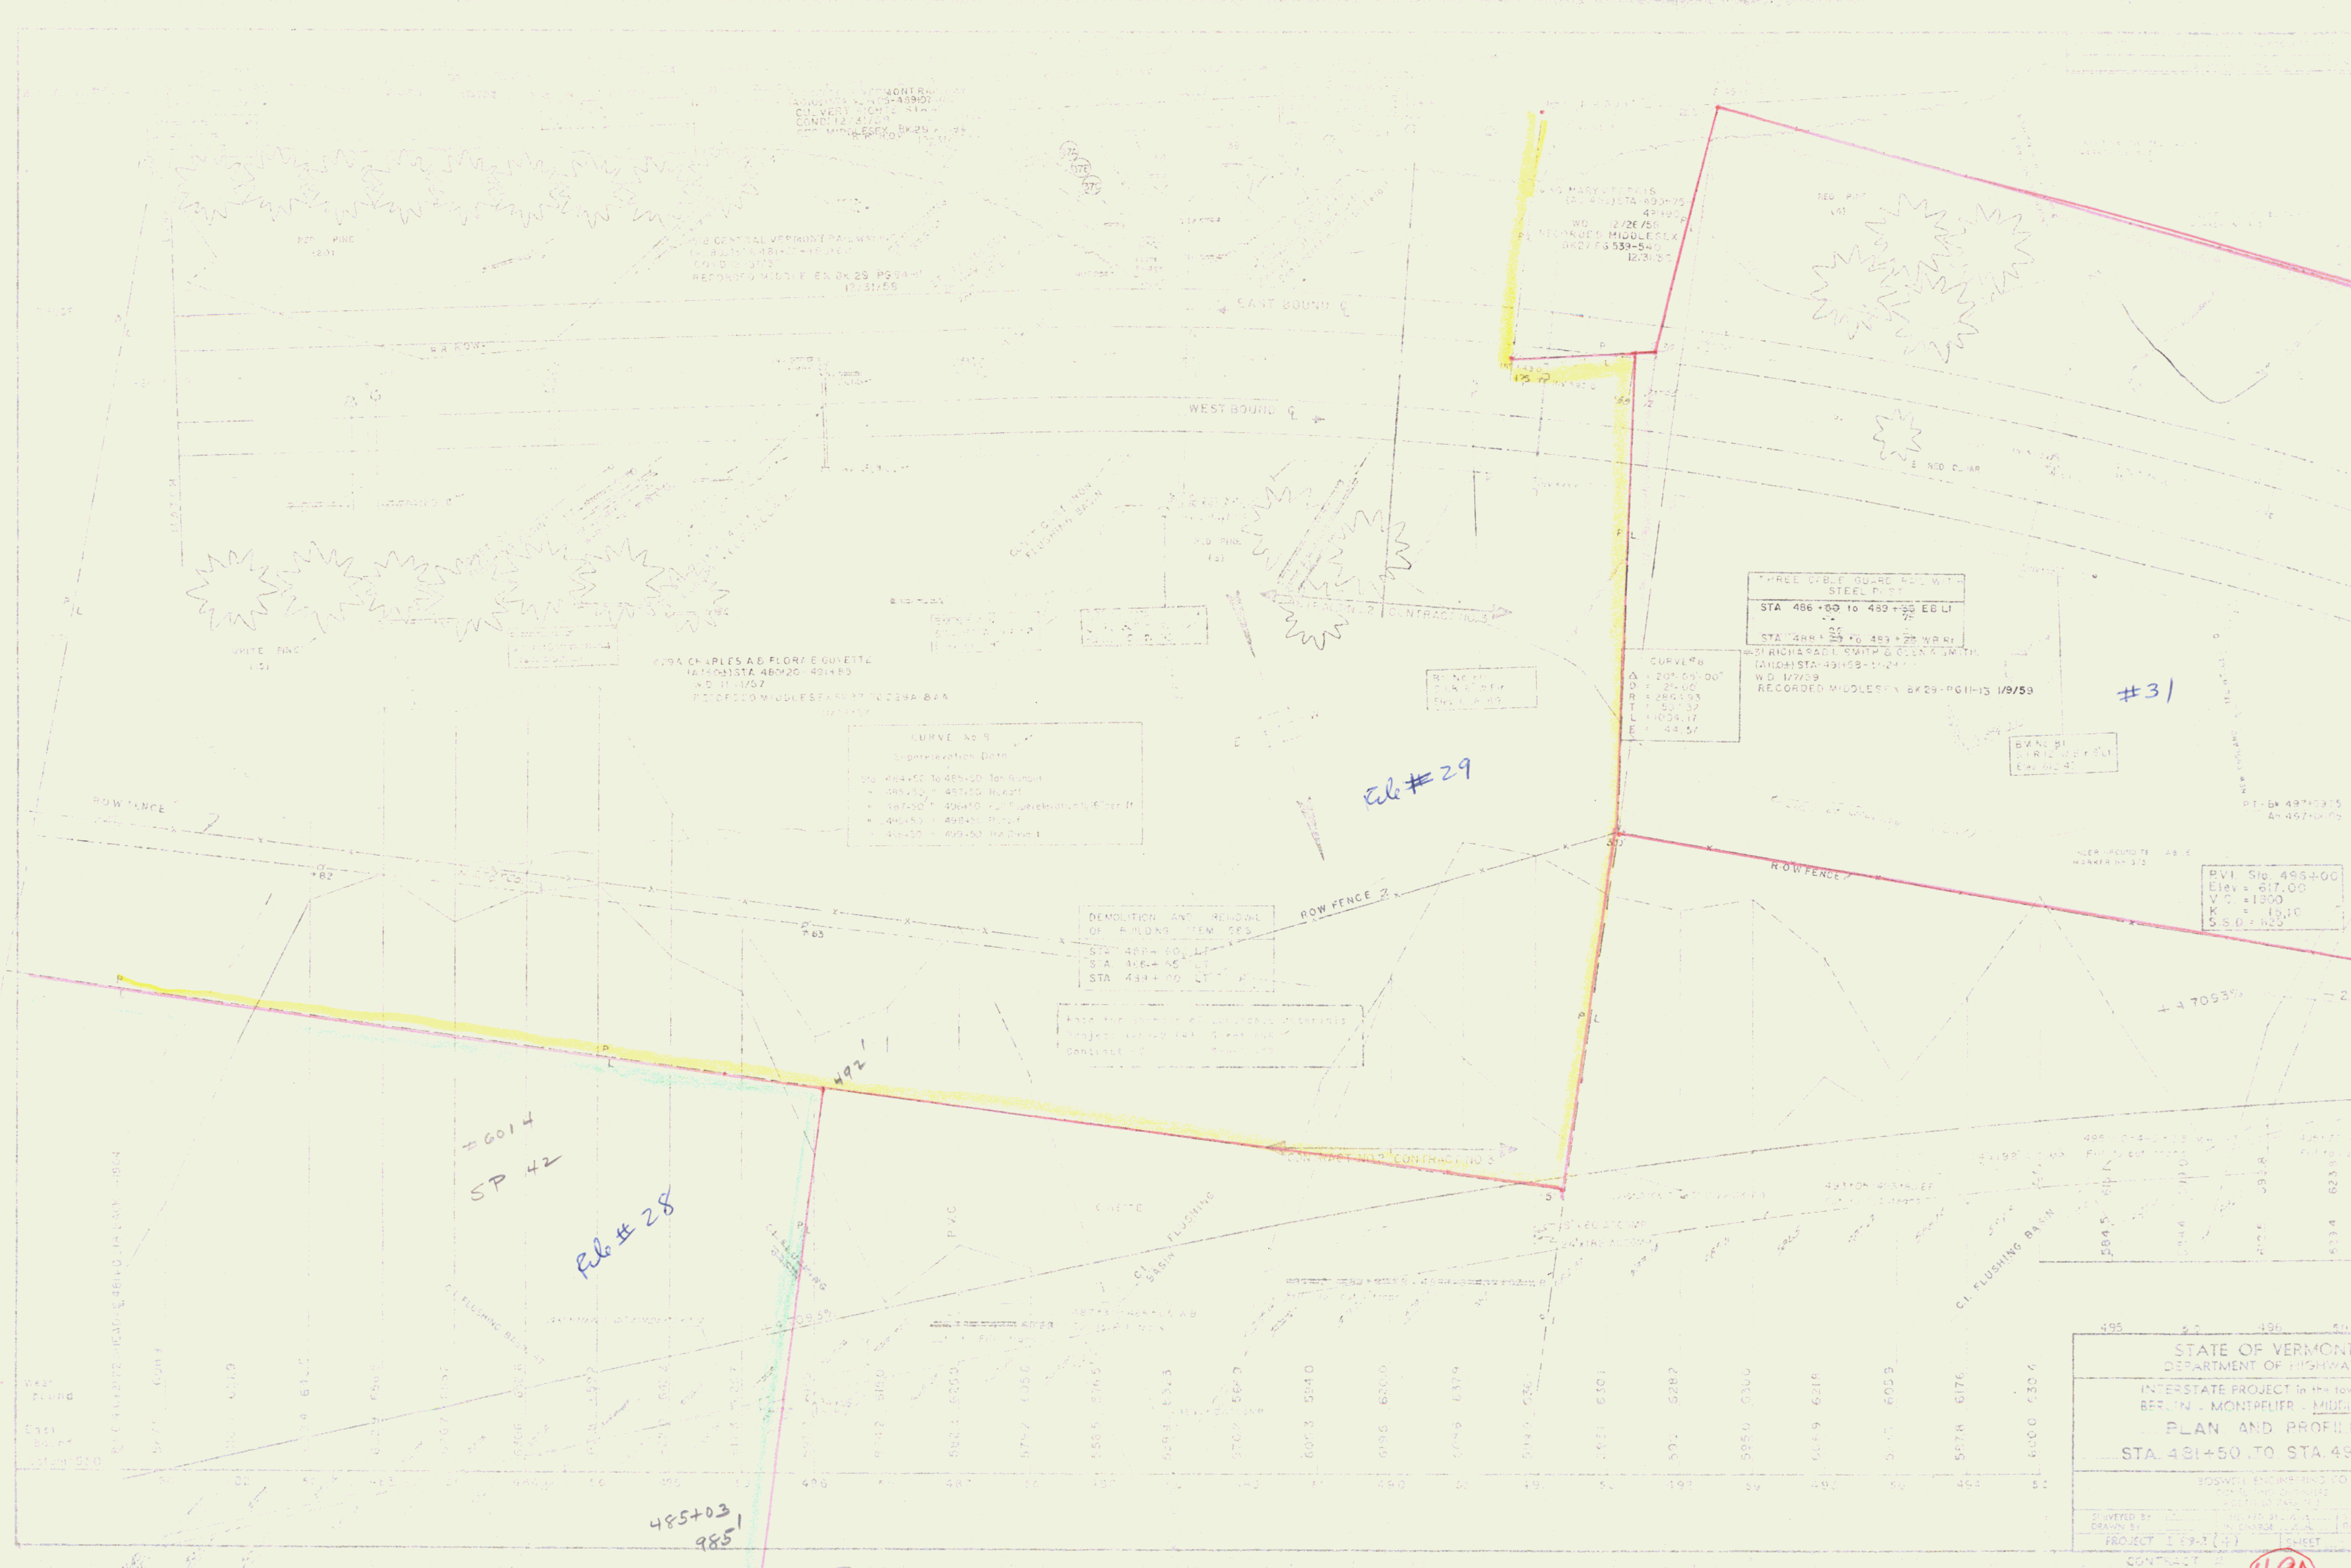

STATE OF VERMONT
 DEPARTMENT OF HIGHWAYS
 INTERSTATE PROJECT in the town of
 BERLIN - MONTPELIER - MIDDLESEX
 PLAN AND PROFILE
 STA 481+50 TO STA 496+00
 EDGEMOND ENGINEERS CO.
 PROJECT 189-1(4) SHEET 49A OF 100
 CONTRACT 49A