


BM. No. 66-C
SIR. 21 Box
E. 584.76

STEEL BEAM GUARD RAIL
STA. 59+50 LT.
STA. 60+25 RT.
STA. 65+00 RT.
R. 64.7, 1065+12.51M

THREE CABLE GUARD RAIL WITH STEEL POST
STA. 59+63 TO 60+00 RT. SIDE
STA. 59+70 - 59+80 LEFT
STA. 59+30 - 60+25 LEFT
STA. 58+15 - 60+11 RIGHT

DRILLING & BLASTING OF SOLID ROCK SUBGRADE
STA. 52+00 TO 56+25
STA. 56+75 TO 58+25
41+00 - 63+10 - 5299

CONSTRUCT DRIVE
STA. 65+30 RT.

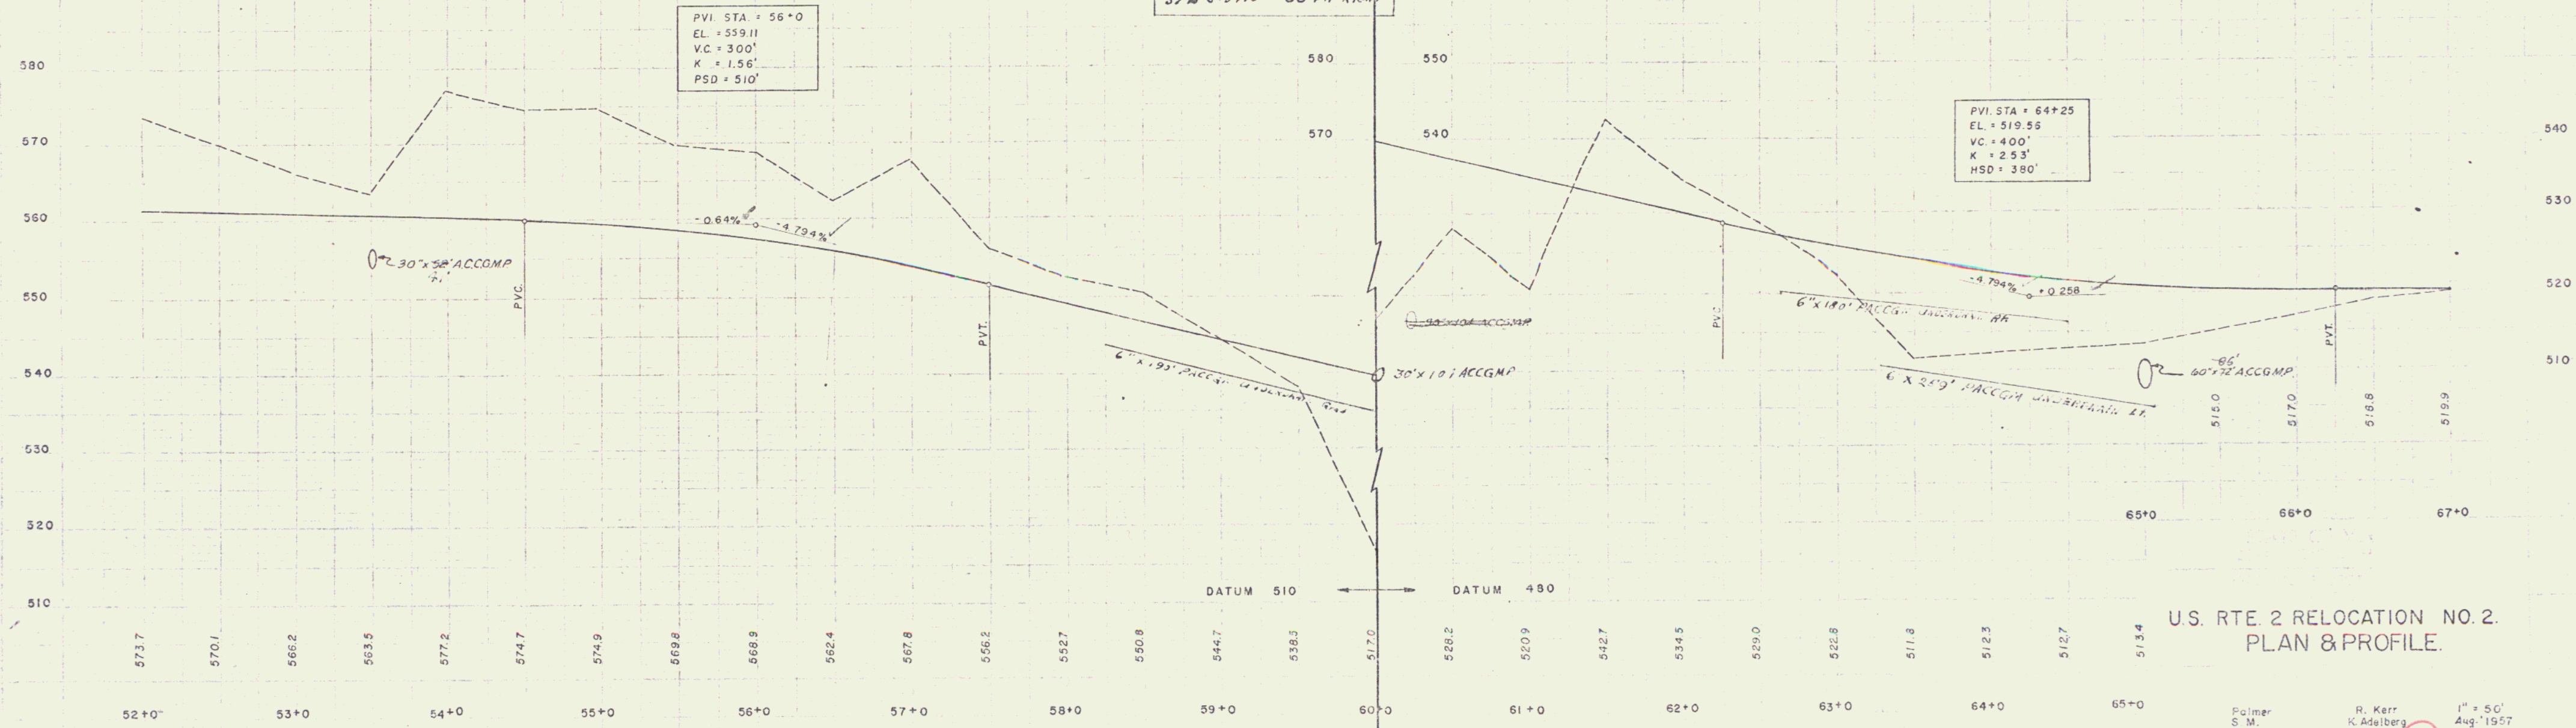

U.S. RTE 2 RELOCATION NO. 2.
PLAN & PROFILE.