
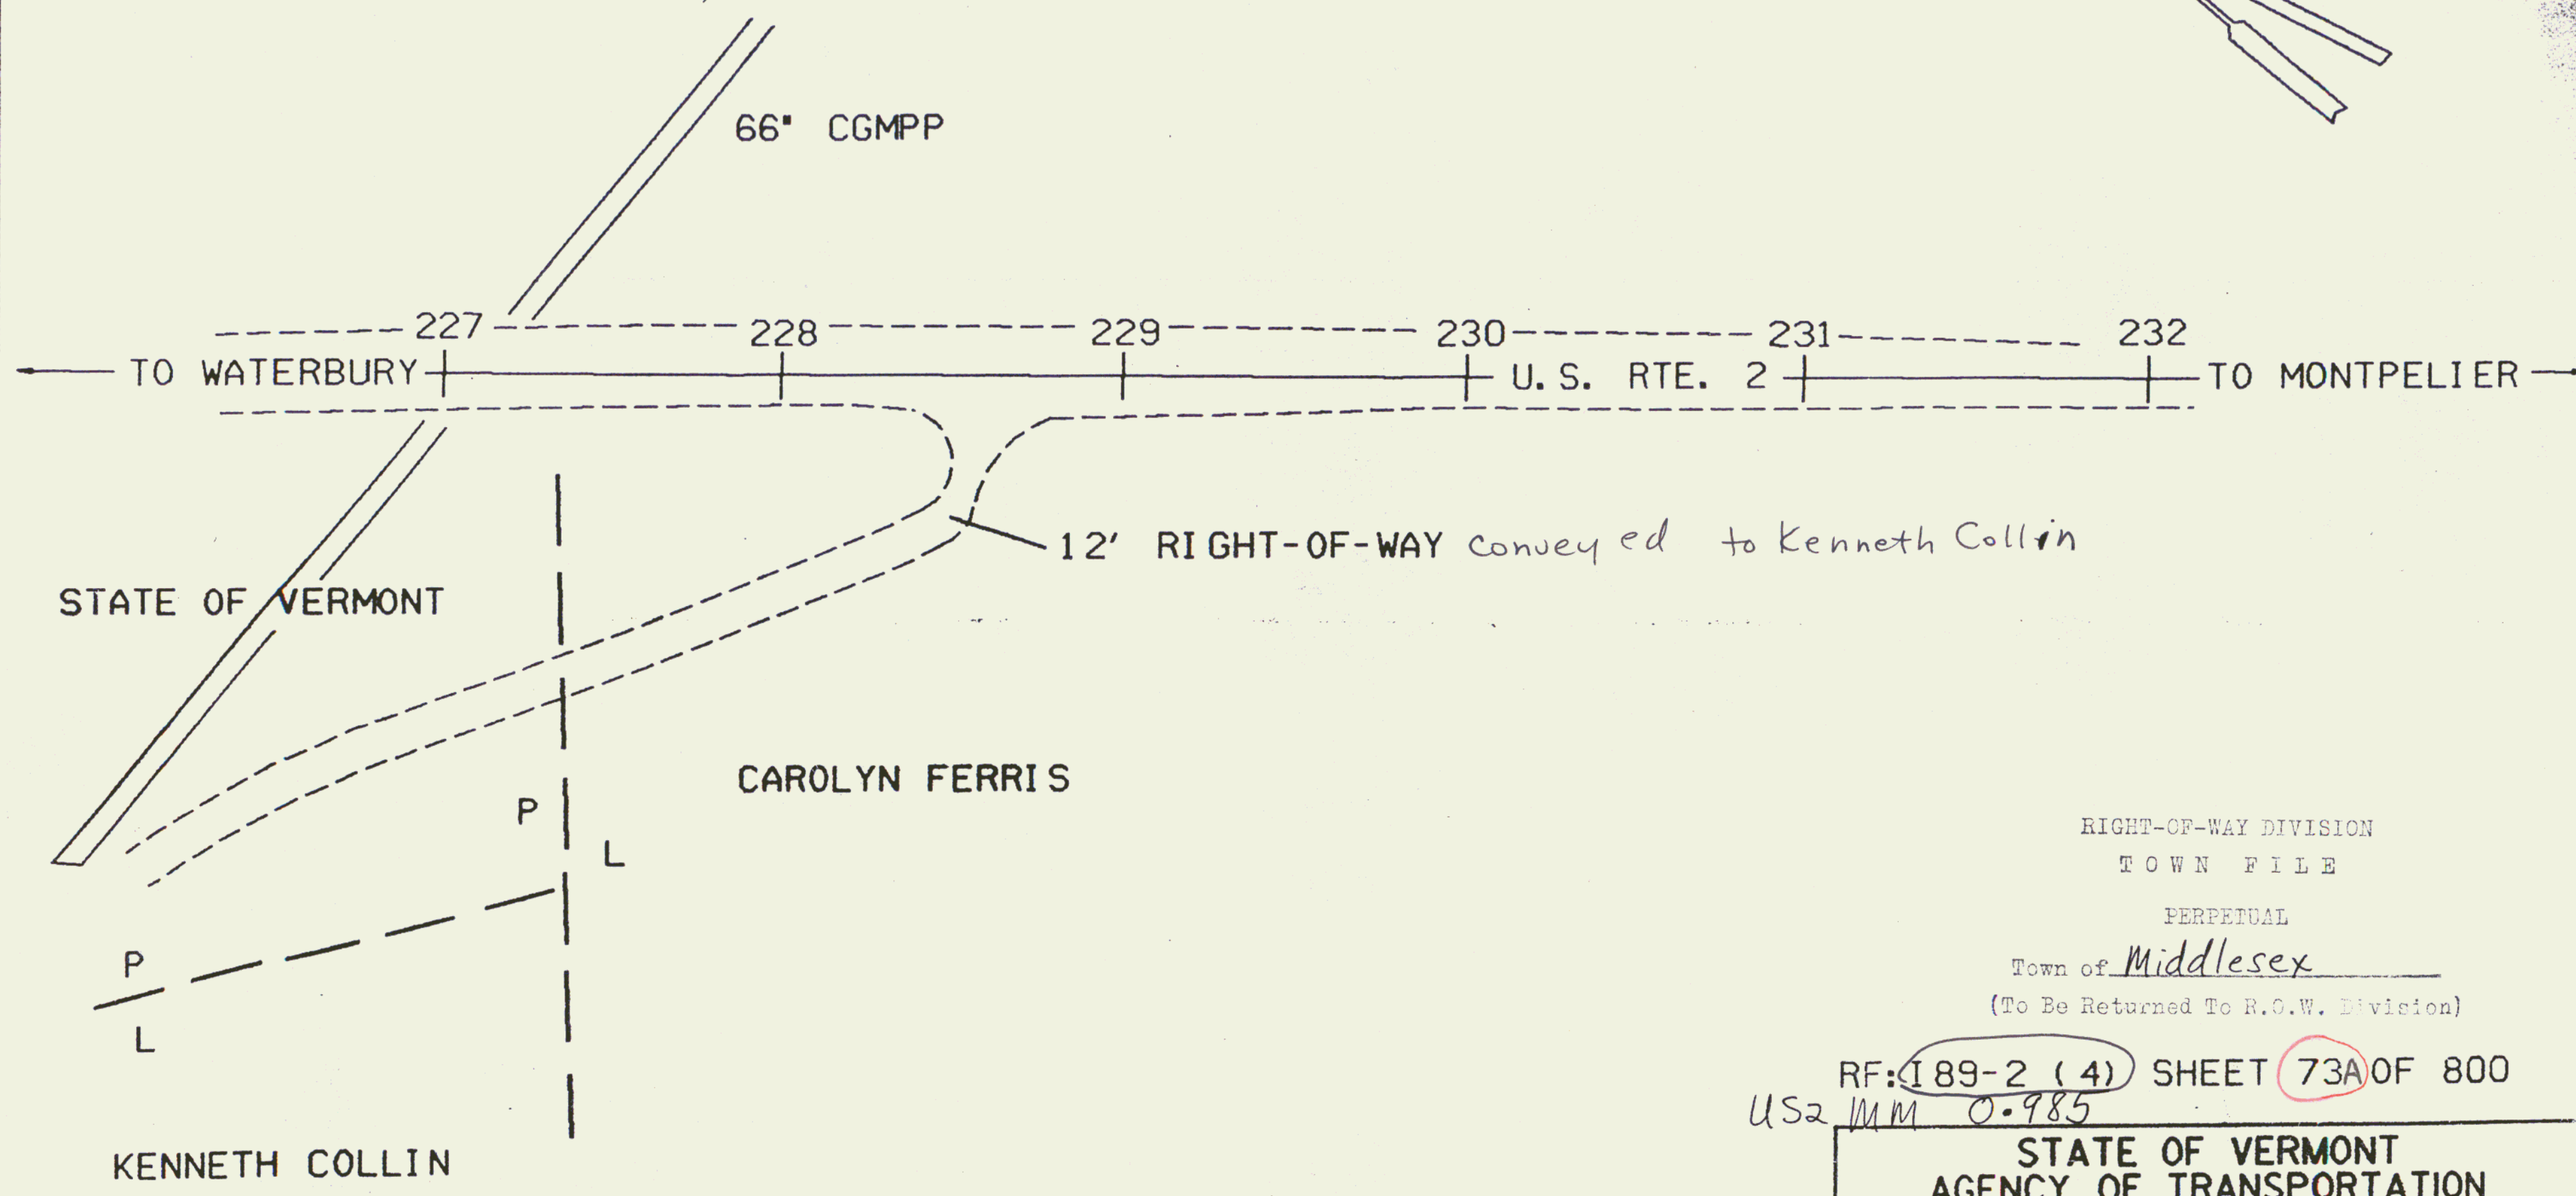


THIS IS THE SAME 12' RIGHT-OF-WAY CONVEYED TO  
 THE STATE OF VERMONT BY LLEWELLYN D & KATHRYN H. FERRIS  
 BY WARRANTY DEED OF EASEMENT DATED 12-26-58  
 AND RECORDED 12-31-58 IN BOOK 27, PAGES 552 & 553  
 OF THE TOWN OF MIDDLESEX LAND RECORDS.

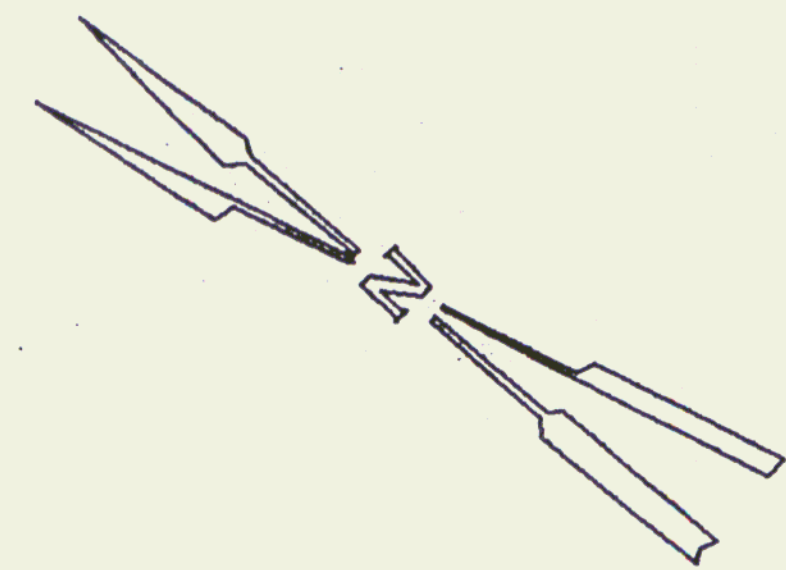

RIGHT-OF-WAY DIVISION  
 TOWN FILE  
 PERPETUAL  
 Town of Middlesex  
 (To Be Returned To R.O.W. Division)

RF: 189-2(4) SHEET 73A OF 800  
 US2 MM 0.985

STATE OF VERMONT AGENCY OF TRANSPORTATION		
TOWN OF MIDDLESEX		
55		
APPROX. SCALE 1" = 50'	DATE 6-12-87	DRAWN BY M.J.F.

