
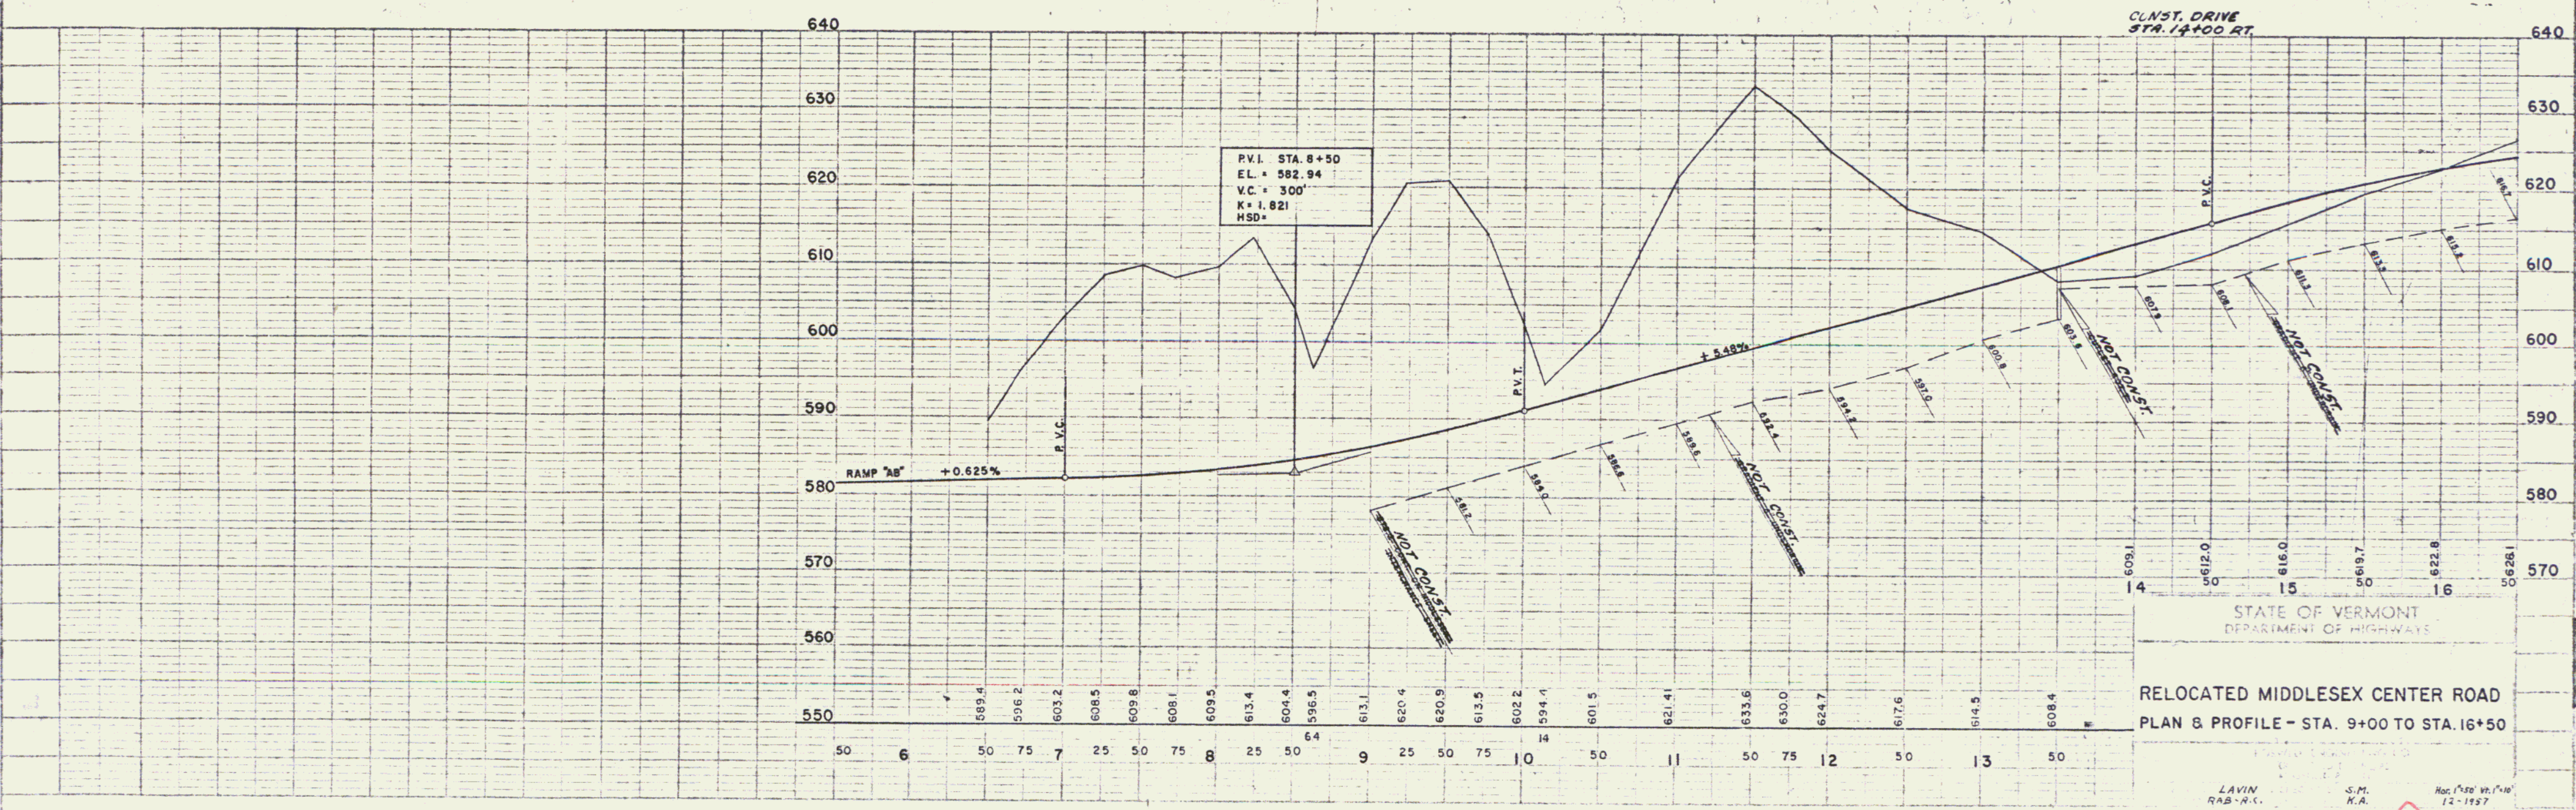


PLAN
LAVIN
E.C.
S.M.
DATE BOOK
NO.

PRINTED
LAVIN
E.C.
S.M.

NOTE: C RELOCATED U.S. RTE. 2 NO. 4 + STA. 0+00
RAMP AB MIDDLESEX INTERCHANGE.
STA. 9+00 RAMP AB = END CONSTRUCTION
189-2(4) BEGINNING CONSTRUCTION
CONTRACT NO. 3 189-2(4) CONTRACT NO. 4.

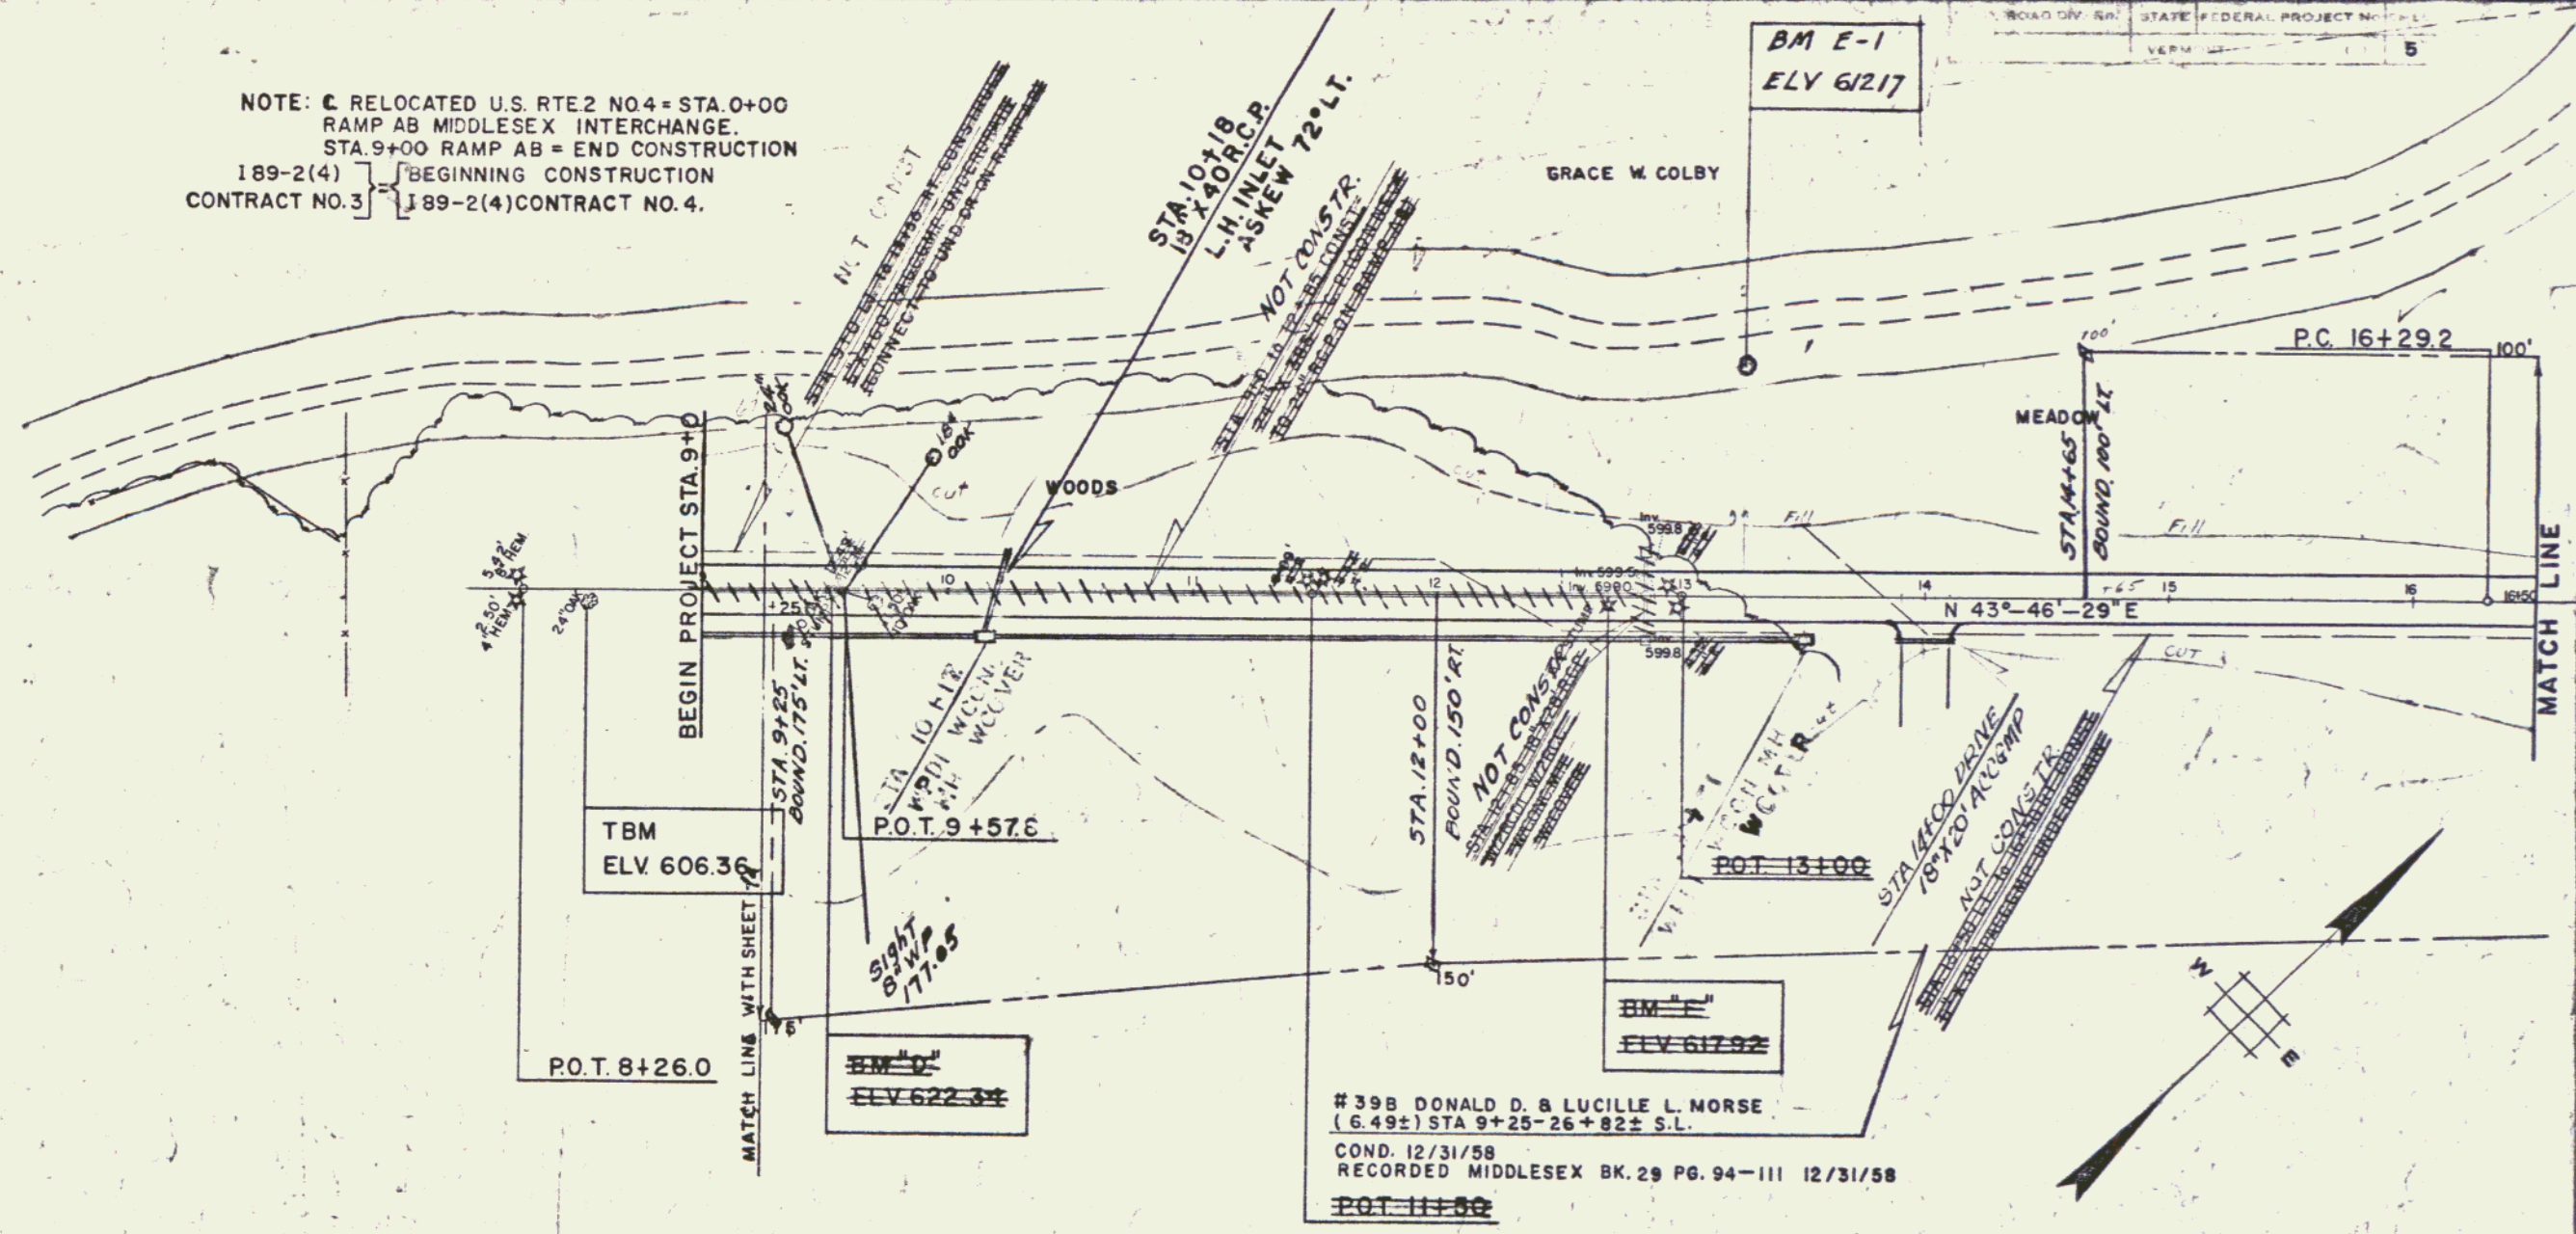

STATE OF VERMONT
DEPARTMENT OF HIGHWAYS
RELOCATED MIDDLESEX CENTER ROAD
PLAN & PROFILE - STA. 9+00 TO STA. 16+50
LAVIN RAB-R.C. S.M. K.A. 12-1957
I 89-2(4) CONTRACT 4

5
const
58