



PLAN
 LAYIN
 E.C.
 S.M.
 DATE: 12/26/58
 SHEET NO. 6

PROFILE
 LAYIN
 E.C.
 S.M.
 DATE: 12/26/58
 SHEET NO. 6

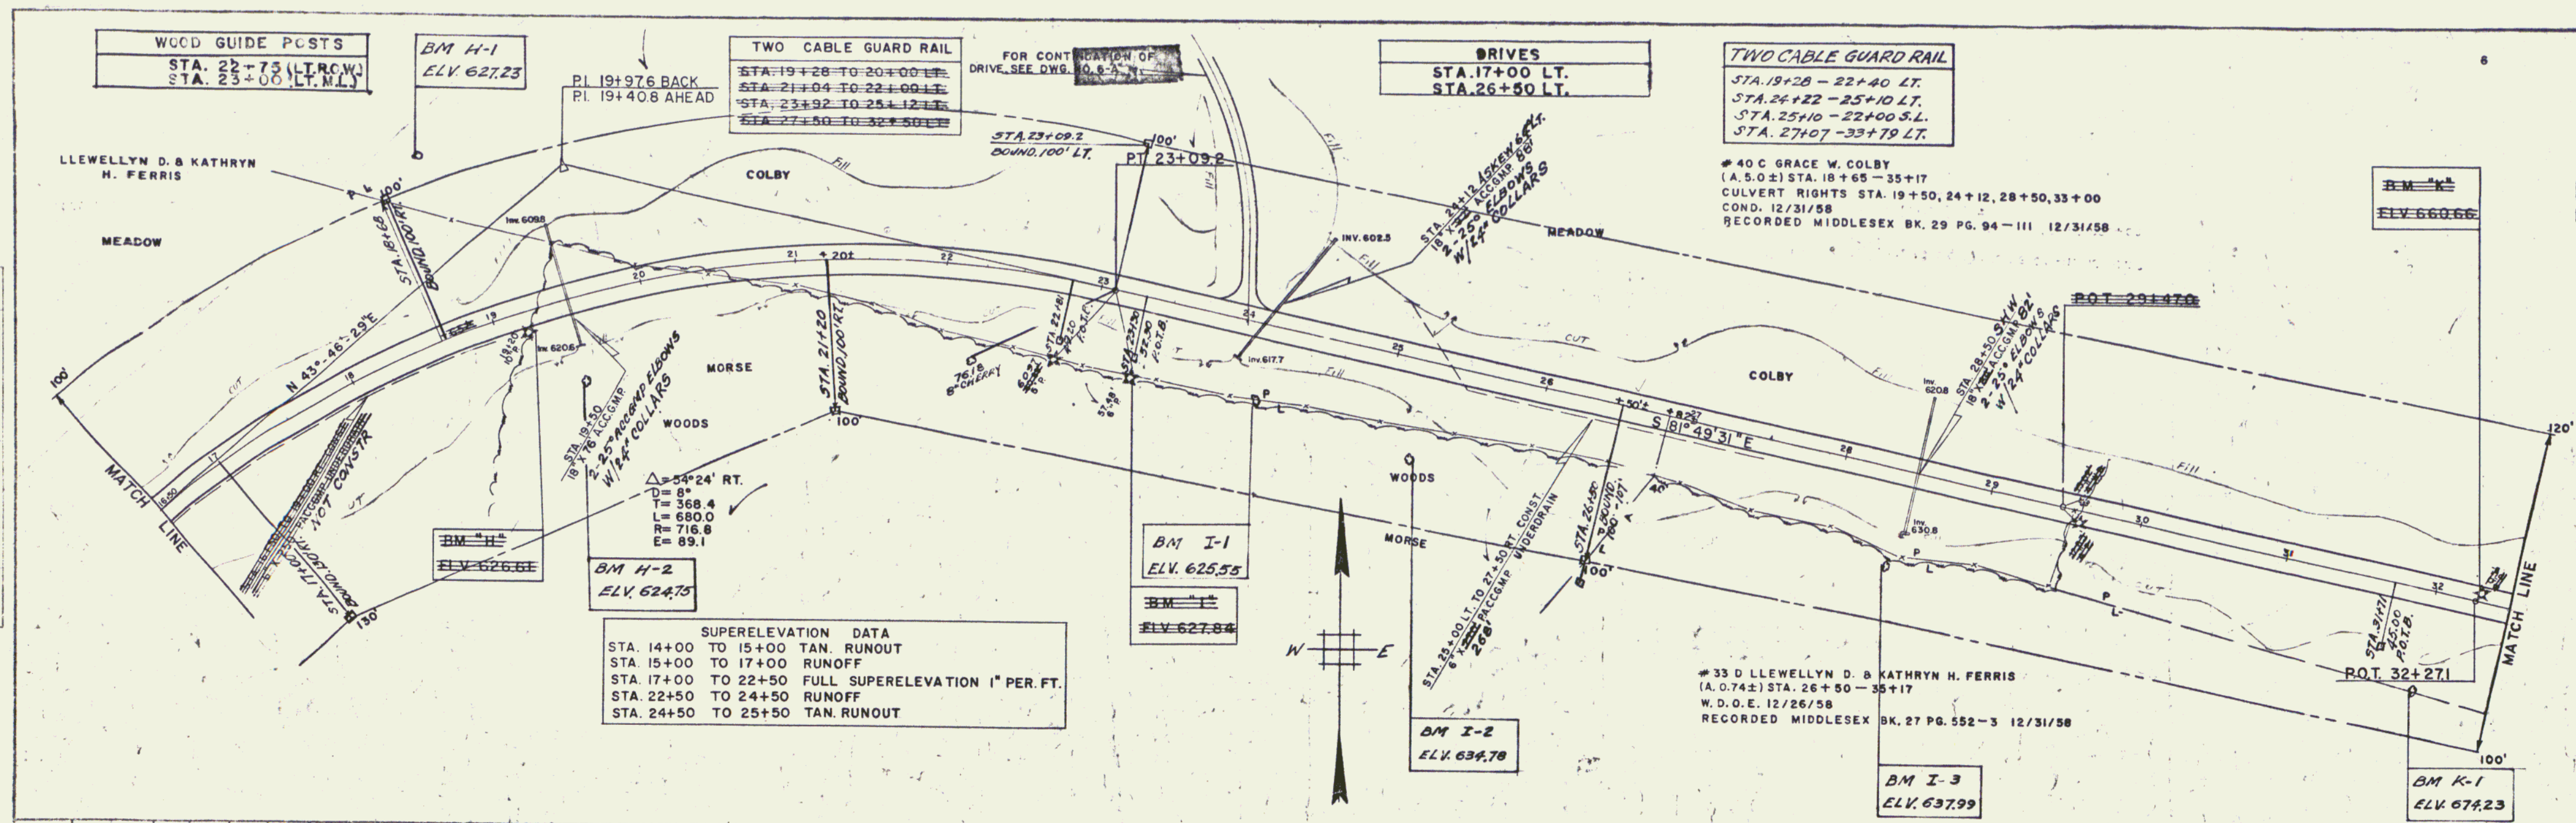

SUPERELEVATION DATA

STA. 14+00 TO 15+00	TAN. RUNOUT
STA. 15+00 TO 17+00	RUNOFF
STA. 17+00 TO 22+50	FULL SUPERELEVATION 1" PER. FT.
STA. 22+50 TO 24+50	RUNOFF
STA. 24+50 TO 25+50	TAN. RUNOUT

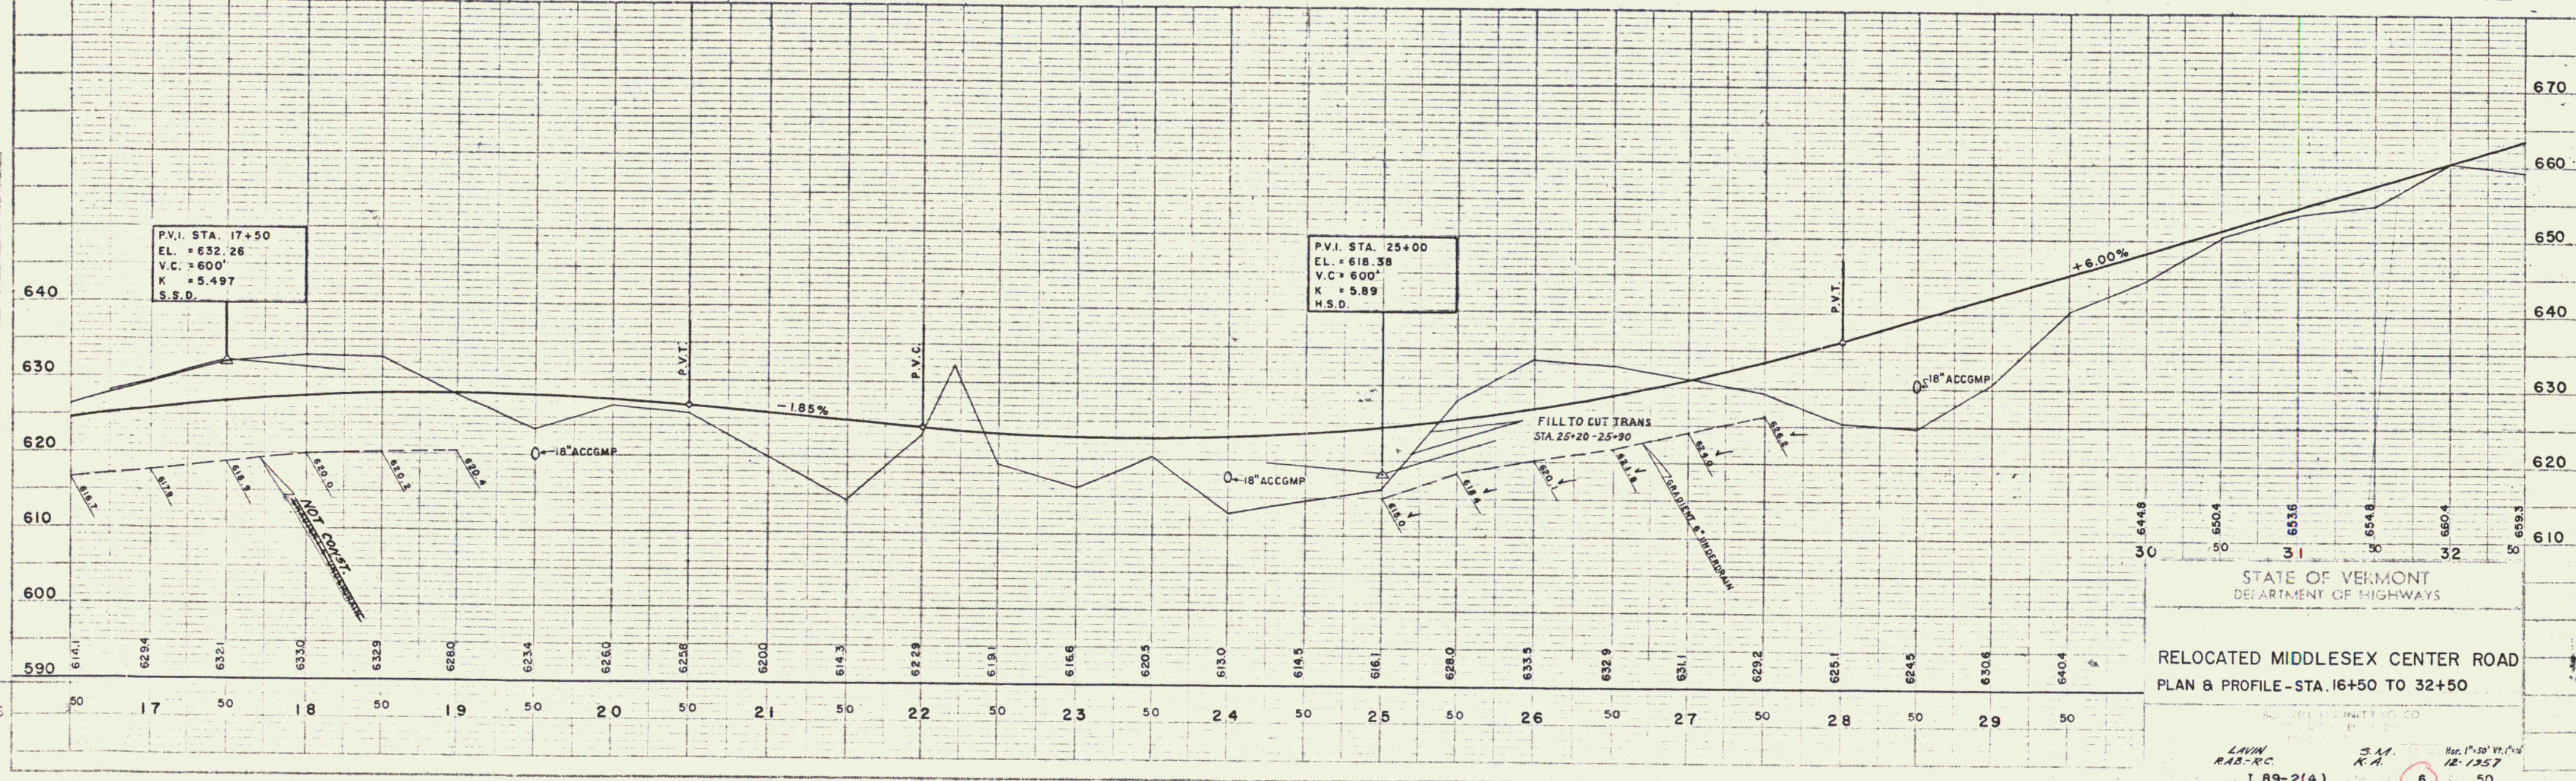

STATE OF VERMONT
 DEPARTMENT OF HIGHWAYS

**RELOCATED MIDDLESEX CENTER ROAD
 PLAN & PROFILE - STA. 16+50 TO 32+50**

CONTRACT 4
 189-2(4)
 6
 50

Const
 59