
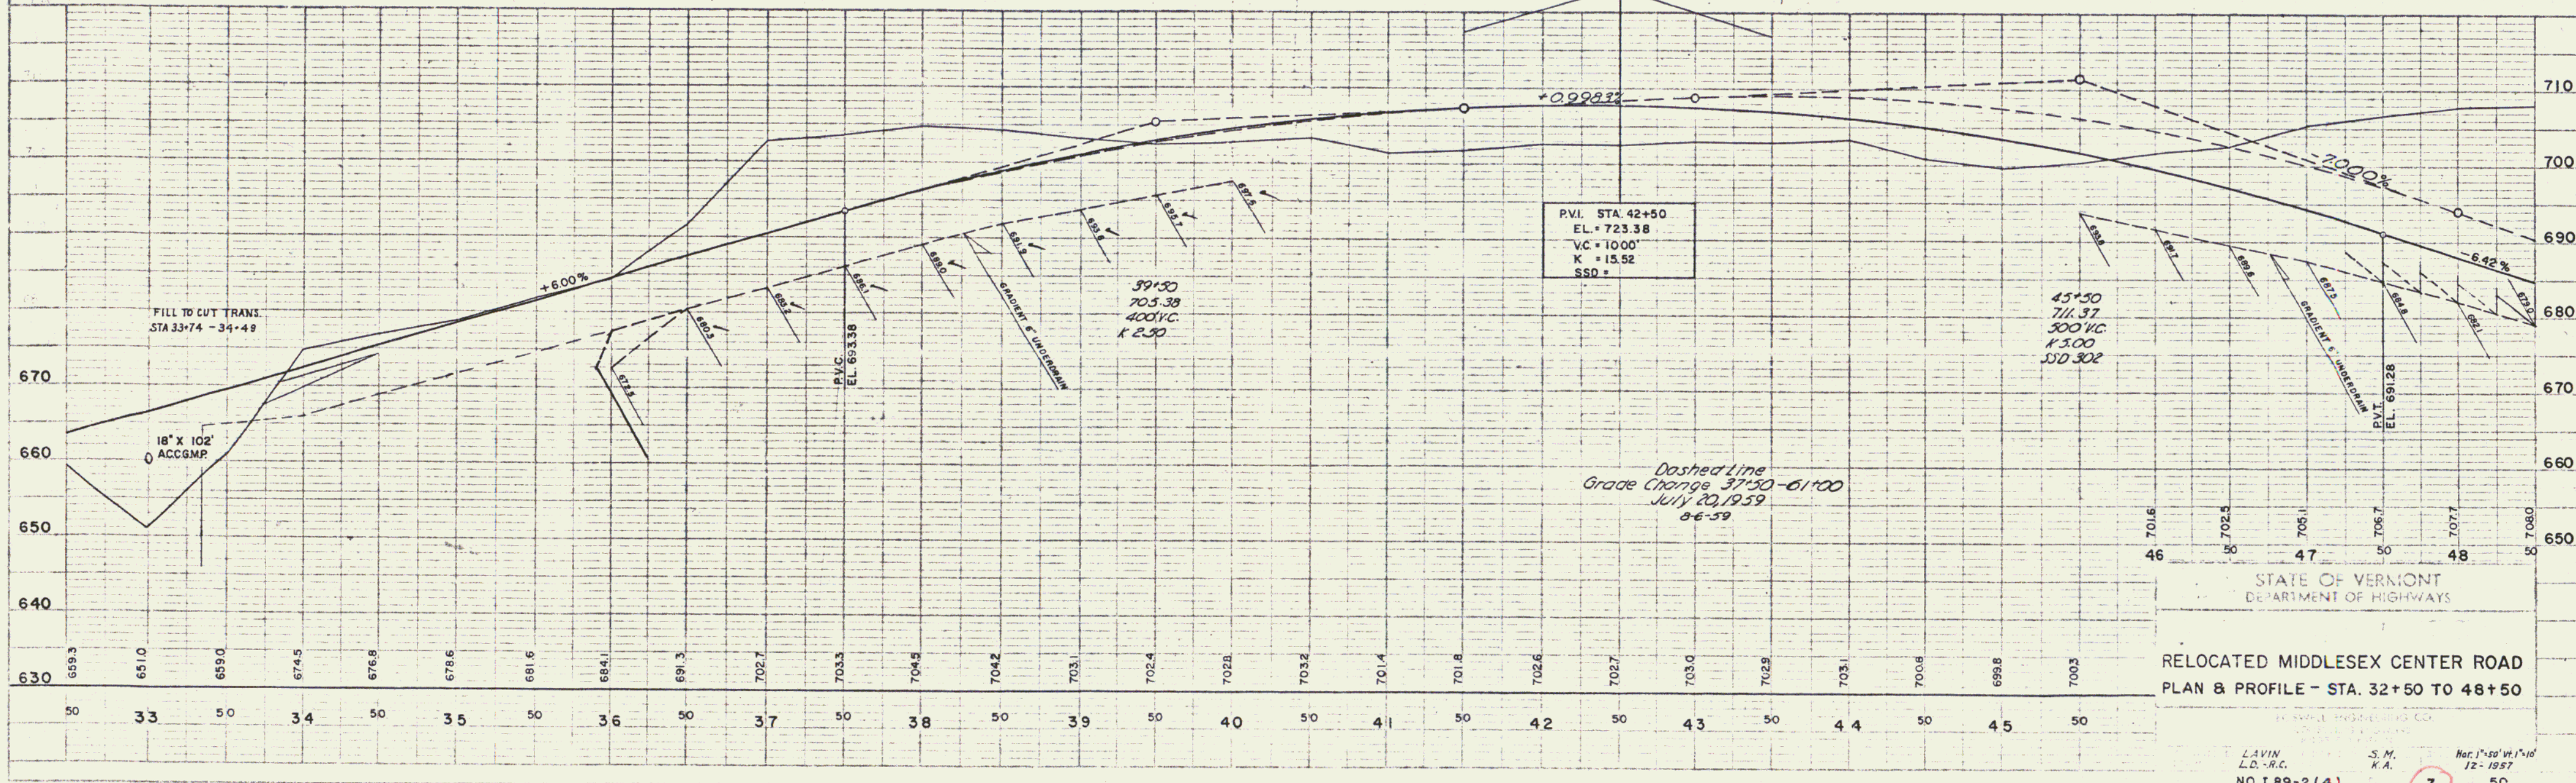


PLAN
 12-57
 L.A.V.
 12-57
 S.M.
 12-57

PROFILE
 12-57
 L.A.V.
 12-57
 S.M.
 12-57

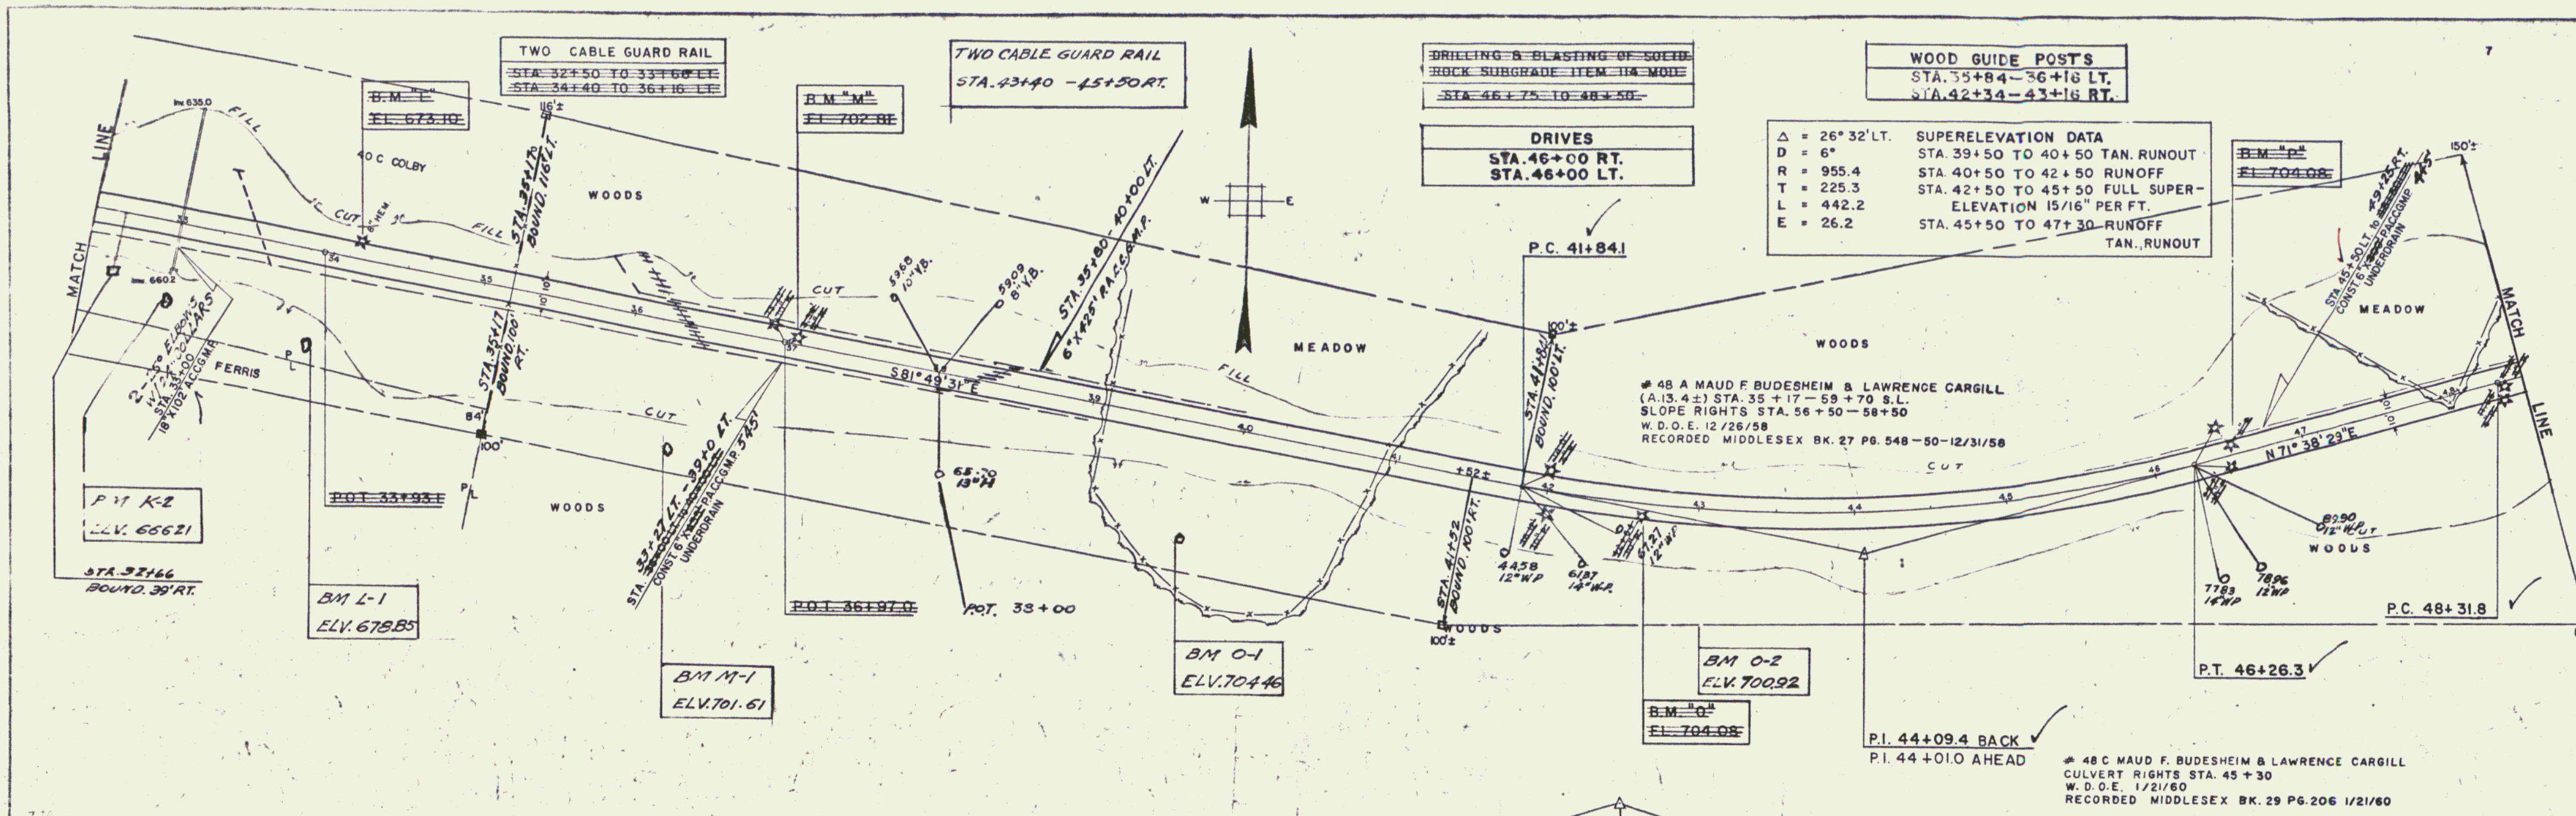

STATE OF VERMONT
 DEPARTMENT OF HIGHWAYS

RELOCATED MIDDLESEX CENTER ROAD
 PLAN & PROFILE - STA. 32+50 TO 48+50

NO. 1 89-2 (4)
 CONTRACT 4

LAVIN
 L.D.-R.C.
 S.M.
 K.A.
 12-1957

7

50

const
 61