

STATE OF VERMONT
DEPARTMENT OF HIGHWAYS

PROPOSED IMPROVEMENT

INTERSTATE PROJECT IN THE TOWNS OF
MIDDLESEX - WATERBURY

COUNTY OF WASHINGTON
CONTRACT NO. 1


Interstate 89 PROJECT NO. 1-89-2(5)

BEGINNING APPROXIMATELY 1.791 MILES SOUTHERLY OF THE MIDDLESEX-WATERBURY TOWN LINE AND EXTENDING NORTHERLY AND NORTHWESTERLY 2.627 MILES.
LENGTH OF ROADWAY - 13,868.60 FEET = 2.627 MILES
LENGTH OF CONTRACT - 13,868.60 FEET = 2.627 MILES

DESIGN DESIGNATION

A.D.T. (1958)	= 3,980
A.D.T. (1975)	= 8,000
D.H.V.	= 1,270
D	= 39%
T	= 6.5% M
V	= 70 M.P.H.

Legend:
 = LIMITED ACCESS PURCHASE
 = NON LIMITED ACCESS PURCHASE
 = AS BUILT R.O.W. FENCE

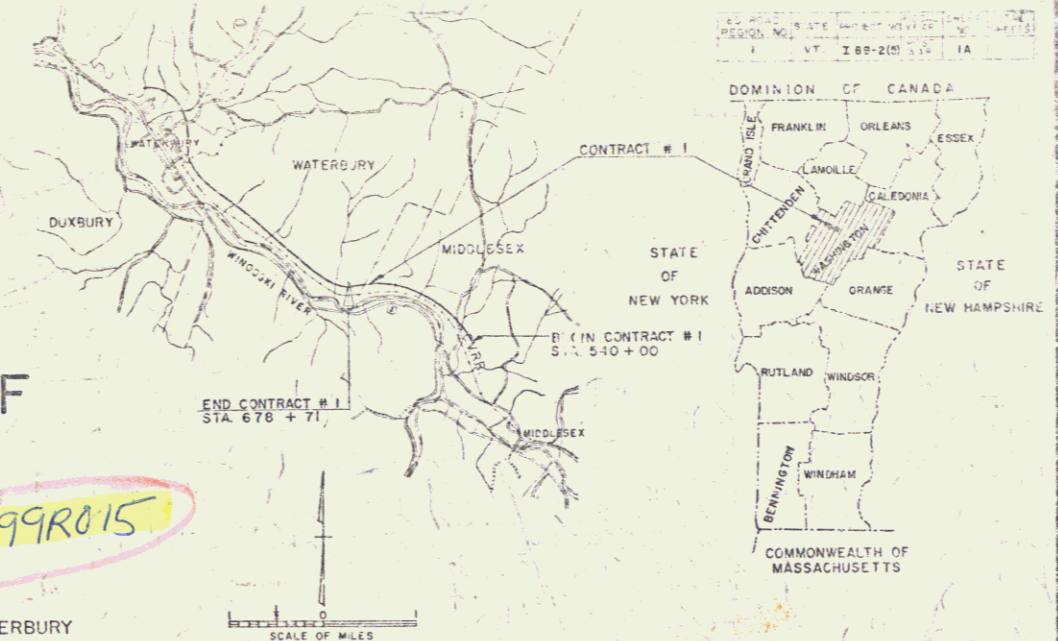

- 7 PLANK
- 8 ITEM DETAIL & DRAINAGE SHEETS

- 22-24
- 25-27
- 28-30
- 1495-1497
- 1498-1499

PROJECT NAME & NUMBER TYPE PAVT. AREA

MIDDLESEX- 1-89-2(5) 3" BITUMINOUS 73,979 sq. yd.

WATERBURY Contract 1 CONC. PAVEMENT

RECORD PLANS

MATERIALS

SUBBASE OF GRAVEL - ROBY PIT - WATERBURY, VERMONT.

SUBBASE OF SAND - MIDDLESEX PIT - MIDDLESEX, VERMONT.

SUBBASE OF CRUSHED ROCK - FULLER QUARRY - BOLTON, VERMONT.

CRUSHED STONE BASE COURSE - FULLER QUARRY - BOLTON, VT.

GRAVEL BACKFILL - CARAVAN PIT - MORETOWN, VERMONT.

GRAVEL SHOULDERS - TOWN OF WATERBURY PIT - WATERBURY, VT.

SINED TAR - HUGGINS

BACK ASPHALT - ESSO - EVENETT, MASSACHUSETTS.

WINDSOR CONCRETE PAVEMENT

CONC. CURB - L.V. PIKE & SON - DUXBURY (PLANT), VERMONT.

CONCRETE CLASS "B" - A.G. ANDERSON, REELY MIX - WATERBURY, V.T.

REINF. STEEL - SCHERER STEEL CO. - E. HARTFORD, CONNECTICUT.

EXTRA STR. REINFCO. IC. PIPE - HUYE PIPE CORP. - SPRINGFIELD, MASS.

ASPH. LTD. CURB GALV. MLT. PIPE - N.E. VET. CULV. CO. - W. RIVER JCT., VT.


PROPERTY LINE FENCE, PLANK GUARD RAIL &

SIGNS - NATIONAL FENCE CO. - MERIDEN, CONNECTICUT.

CABLE FOR GUARD RAIL - PAULSEN - WEBBER CORDAGE CORP. - SUNBURY, PENNA.

TREES & SHRUBS - PUTNEY NURSERY INC. - PUTNEY, VERMONT.

CONTRACTOR - THE LANE CONSTRUCTION CORP.
MERIDEN, CONNECTICUT.
RESIDENT ENGINEER - JOHN SMYRSKI
INSPECTORS - JOSEPH ST. PETER - ELDON
MORRISON - KENNETH MASON
RECORD PLANS - ALEXANDER G. SPITALE
CONTRACT DATED - APRIL 17, 1959.
CONTRACT STARTED - MAY 25, 1959.
CONTRACT COMPLETED - JULY 14, 1961.
CONTRACT ACCEPTED - JULY 14, 1961.

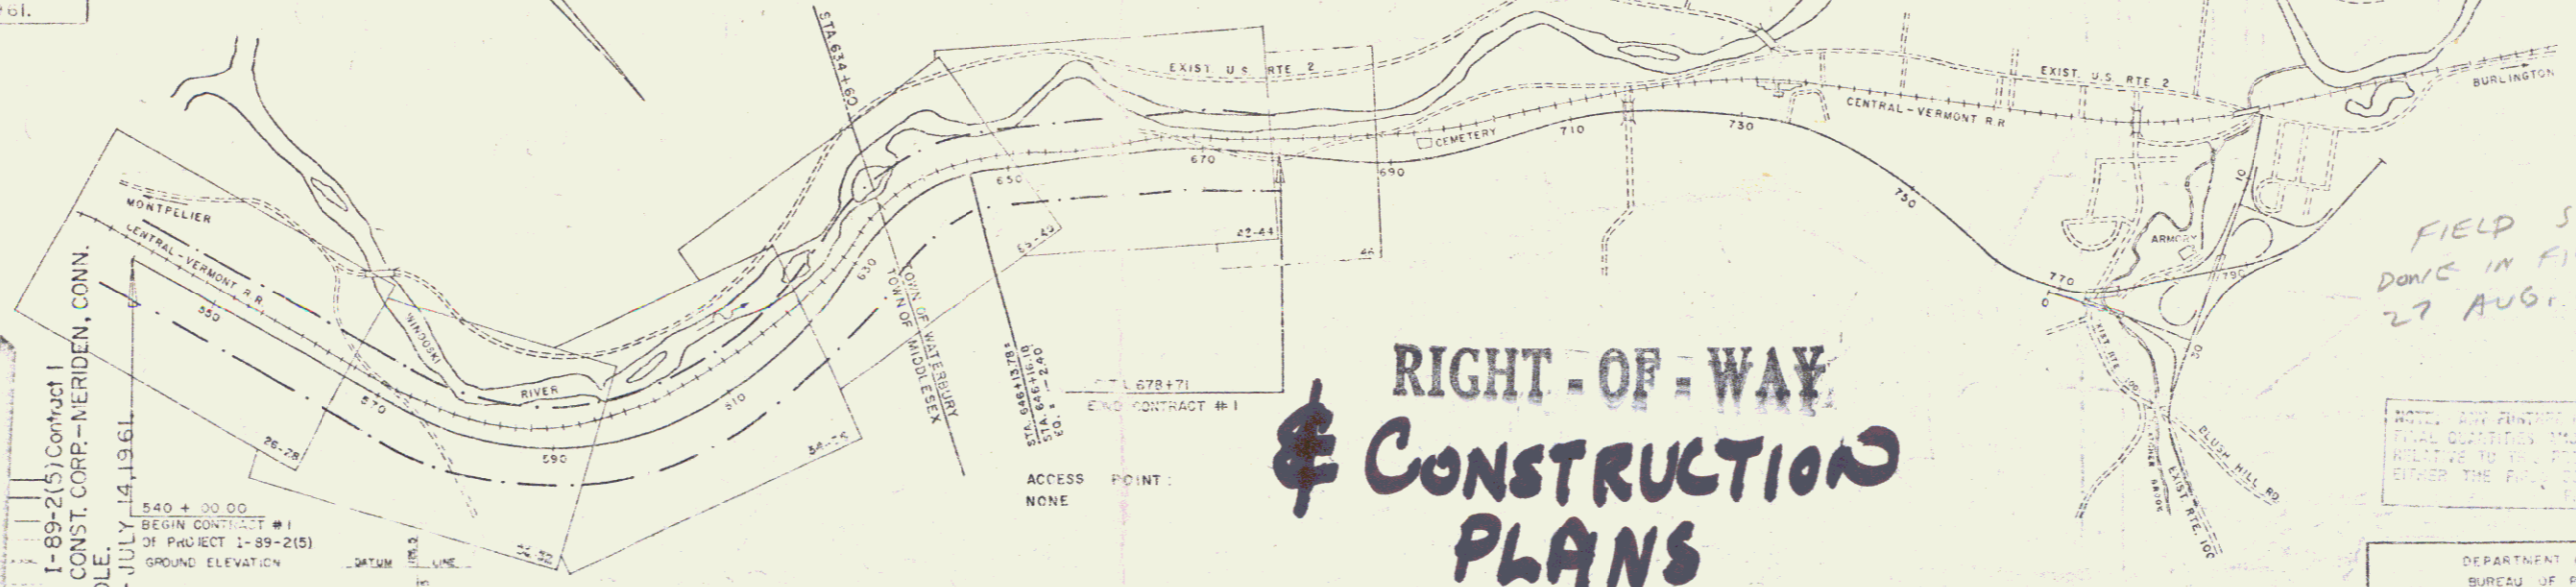

FIELD SET
DANIC IN FIELD
27 AUG. 1974

STATE OF VERMONT LICENSE NO. 272

DATE 12/22/59

DATE 12/22/59

DATE 12/22/59

DATE 12/22/59

DATE 1/20/59

CONTRACT NO. 1-89-2(5)

SHEET 1 OF 316

Middlesex - Waterbury I 89-2(5) C-1
Station 540 to ~ 670+71