


LANDSCAPE MATERIAL
TREES
598+85 RT. 130' W. BIRCH (1)
599+00 RT. 115' W. BIRCH (1)
599+40 RT. 110' W. BIRCH (1)

THREE CABLE GUARD RAIL w/ STEEL POSTS
Left 590+00 to 595+50
Right 601+00 to 604+00
601+00 to 604+00

PROPERTY LINE FENCE w/ STEEL POSTS
Left 593+00
Right 590+00 to 604+00
597+00 to 604+00

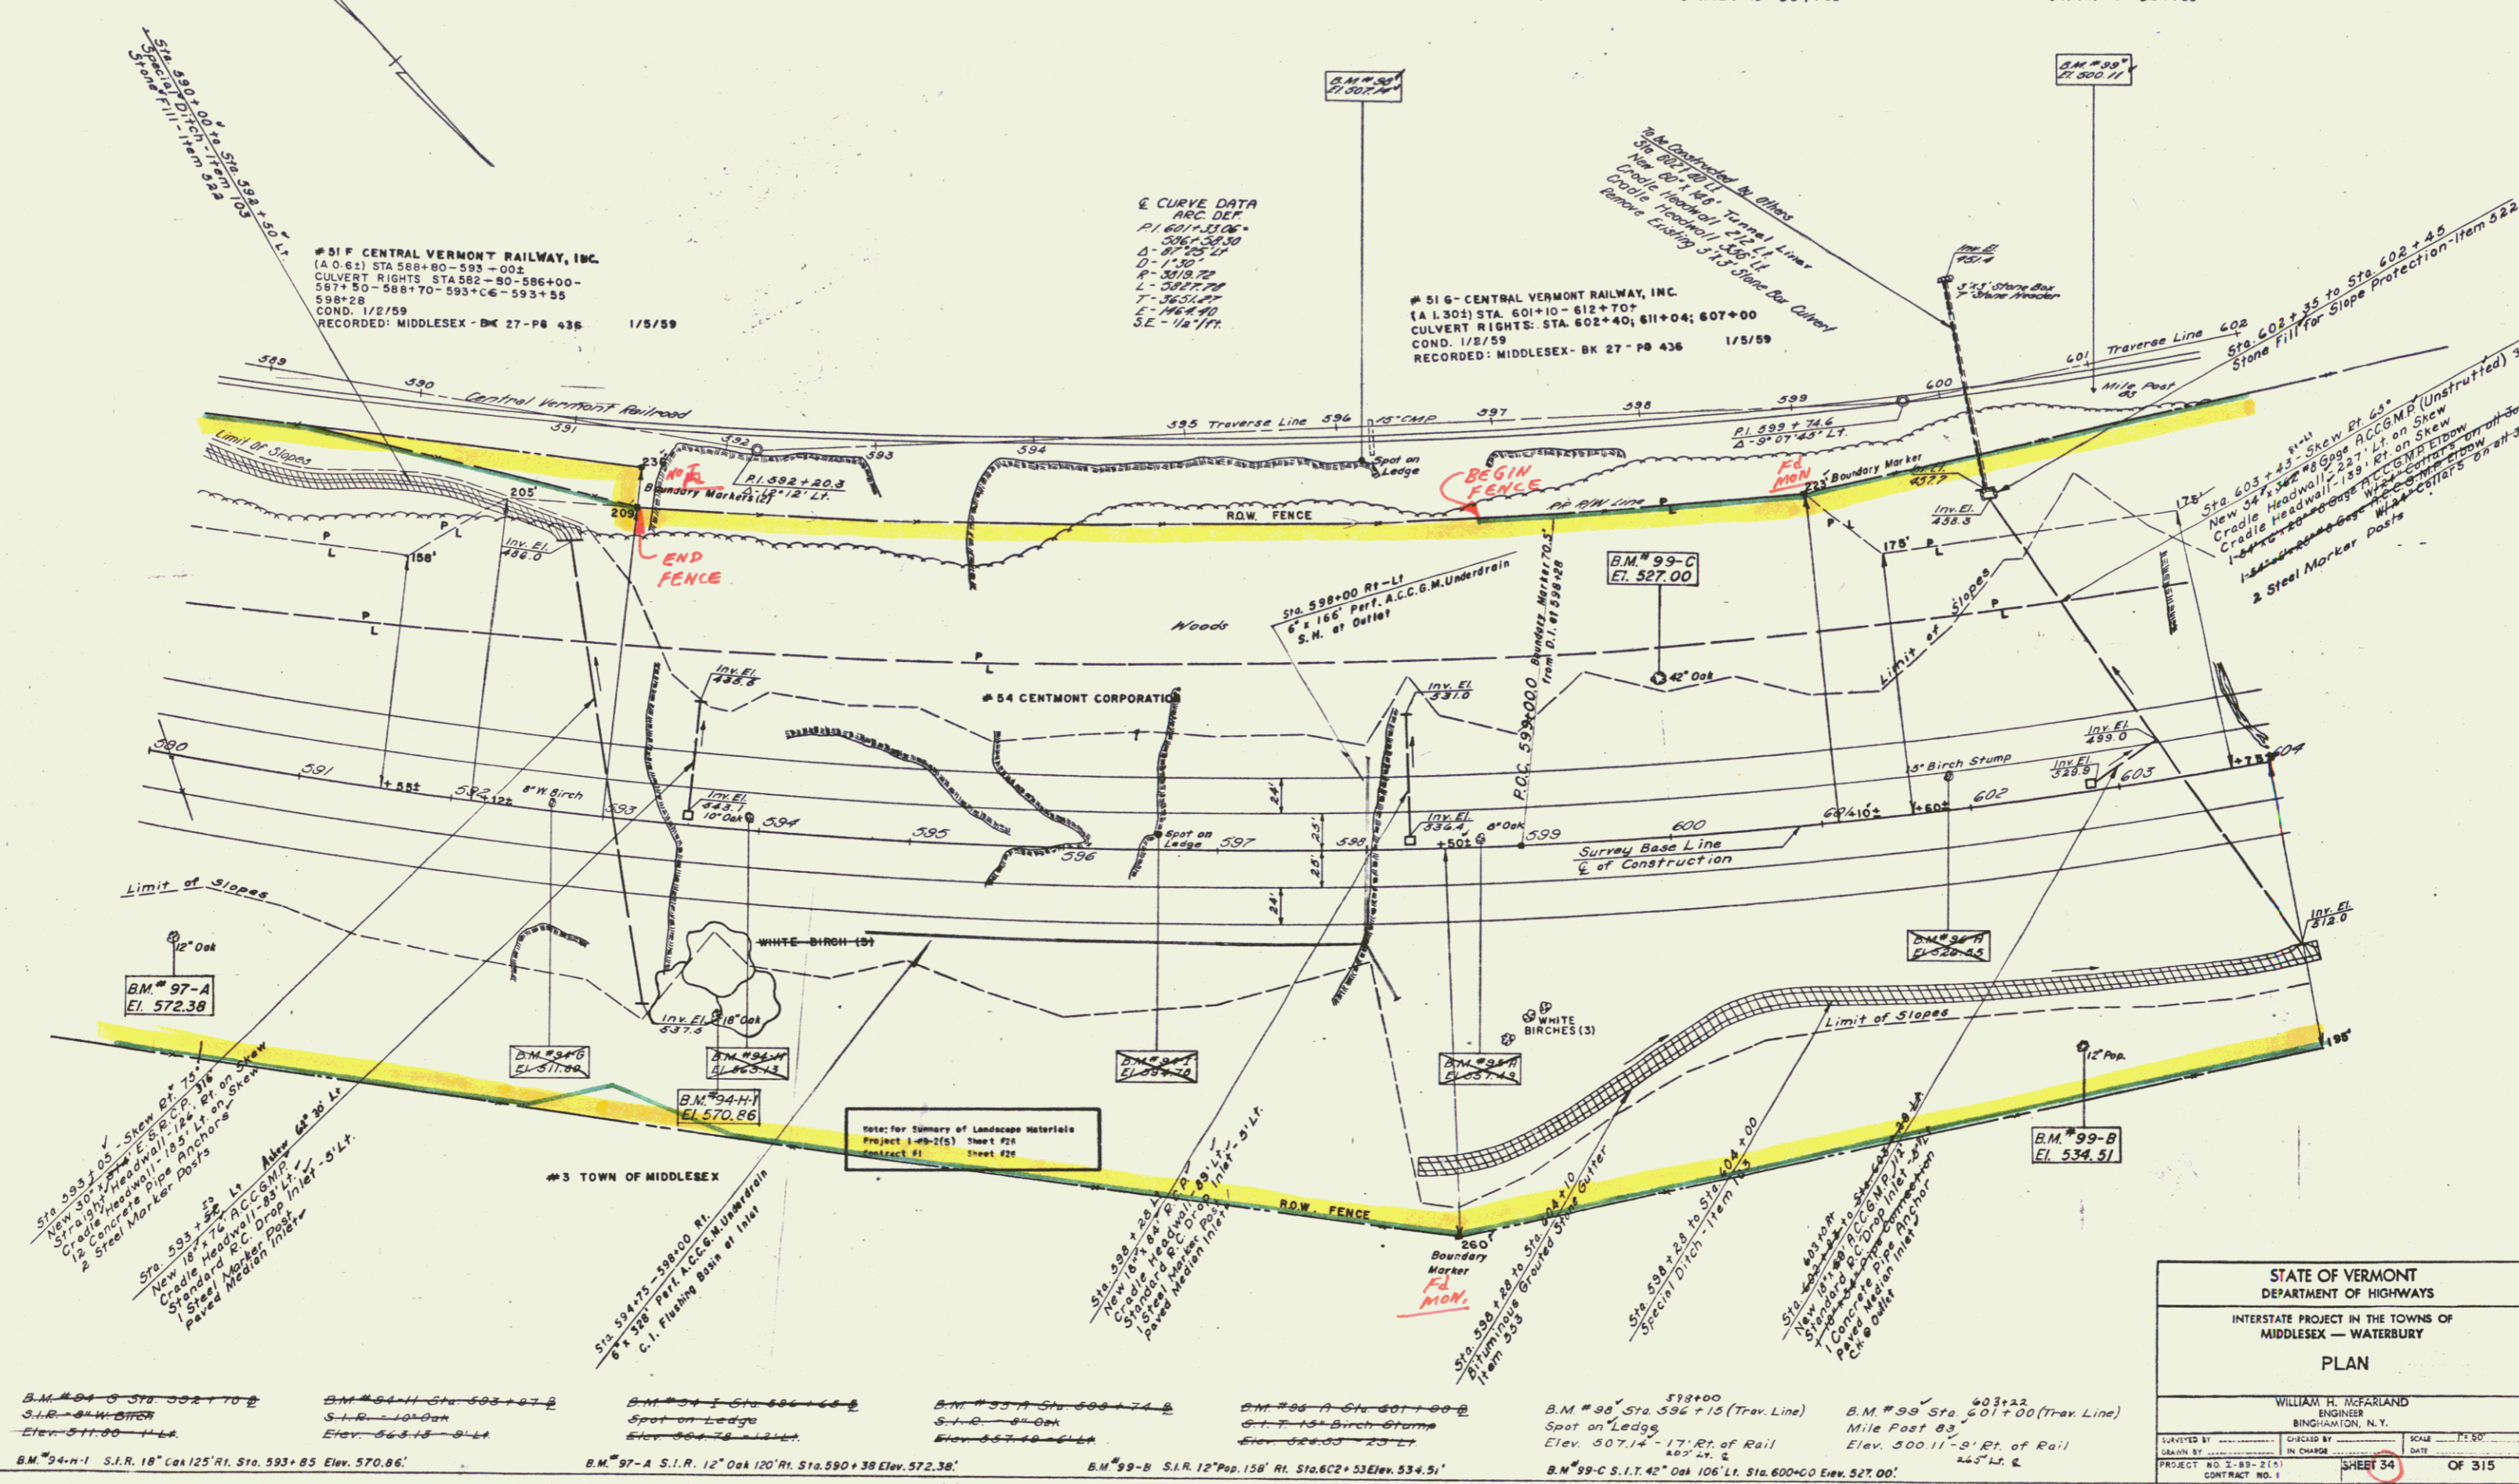

51 F CENTRAL VERMONT RAILWAY, INC.
(A.O. 62) STA 588+80-593+00
CULVERT RIGHTS STA 582-80-586+00-
587+50-588+70-593+00-593+55
598+28
COND. 1/2/59
RECORDED: MIDDLESEX - BK 27 - PG 436 1/5/59

Q CURVE DATA
ARC DEF
P.I. 601+51.0
336+34.0
D=110
R=350.72
L=362.70
T=363.47
E=106.40
SE=1/4" PT.

51 G CENTRAL VERMONT RAILWAY, INC.
(A.I. 305) STA 601+10-612+70
CULVERT RIGHTS: STA. 602+40; 611+04; 607+00
COND. 1/2/59
RECORDED: MIDDLESEX - BK 27 - PG 436 1/5/59

Sta. 593+05 - Skew Pt. 73.1
New 30' x 12' x 18" ACCOMP.
Culvert, 12' x 12' x 18" on Skew
12' x 12' x 18" Anchored
2 Steel Marker Posts
Sta. 593+22 - L4
New 10' x 7' ACCOMP.
Culvert, 10' x 7' x 18" on Skew
Standard R.C. Pipe
1 Steel Marker Post
1 Paved Median Inlet

Note: For Summary of Landscape Materials
Project 149-1(5) Sheet #21
Project #1 Sheet #21

STATE OF VERMONT DEPARTMENT OF HIGHWAYS	
INTERSTATE PROJECT IN THE TOWNS OF MIDDLESEX - WATERBURY	
PLAN	
WILLIAM H. McFARLAND ENGINEER BINGHAMTON, N.Y.	
DESIGNED BY	SCALE 1" = 50'
DRAWN BY	DATE
CHECKED BY	IN CHARGE
PROJECT NO. I-89-211	SHEET 34
CONTRACT NO. 1	OF 315

- B.M. #94-C Sta. 592+70.0 S.I.R. - 8" W. BIRCH Elev. 571.80 - 1.44
- B.M. #94-H-1 S.I.R. 18" x 12" 125' Rt. Sta. 593+85 Elev. 570.86
- B.M. #94-H-2 S.I.R. 18" x 12" 125' Rt. Sta. 593+85 Elev. 570.86
- B.M. #94-H-3 S.I.R. 18" x 12" 125' Rt. Sta. 593+85 Elev. 570.86
- B.M. #94-H-100 S.I.R. 18" x 12" 125' Rt. Sta. 593+85 Elev. 570.86