


Q CURVE DATA
 Arc Def
 P.I. 601+33.06
 Δ = 87°23'11"
 R = 3,019.72
 L = 5027.70
 T = 3651.27
 E = 1464.40
 S.E. 1/4 174

PROPERTY LINE FENCE WITH STEEL POSTS
 Right
 618+00 TO 620+00
 618+00 TO 620+00
 618+00 TO 620+00
 618+00 TO 620+00

THREE CABLE GUARD RAIL WITH STEEL POSTS
 Left Right
 621+00 TO 624+00
 621+00 TO 624+00

LANDSCAPE MATERIAL
 TREES
 618+50 RT. 105' W. BIRCH (1)
 618+70 RT. 115' W. BIRCH (1)
 618+80 RT. 100' W. BIRCH (1)
 SNRUBS
 630+70-632+00 FT. 10' begin
 BLACK HAW. (71)

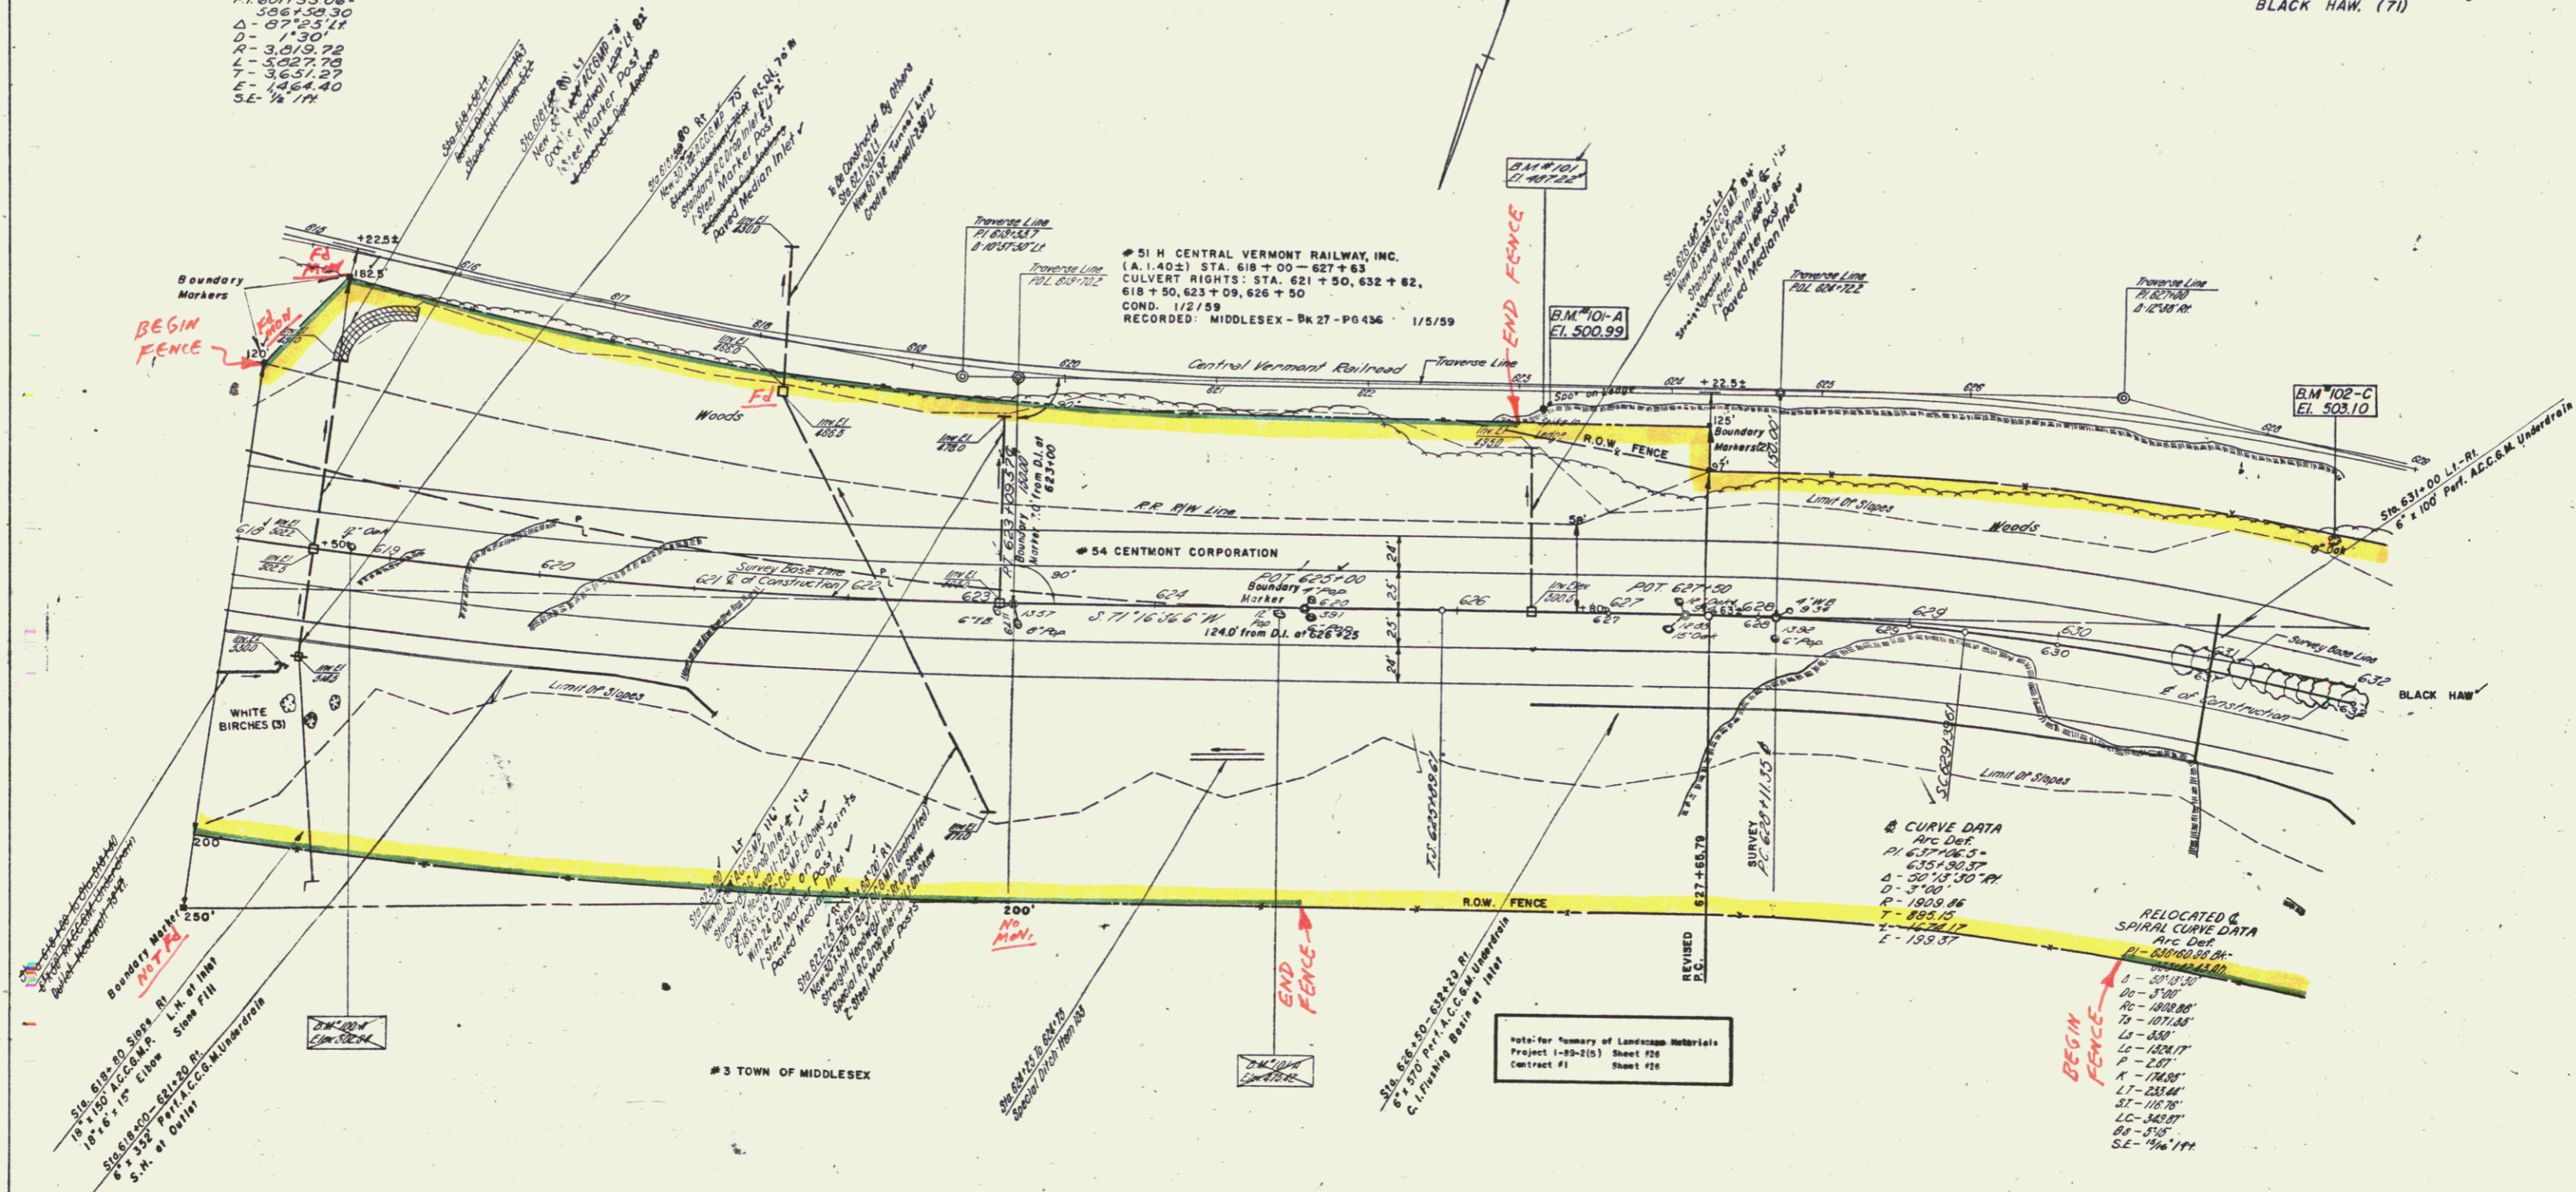

Boundary Markers
 518 618+00 S. 1/4
 10' x 15' E. Stone Pile
 518 618+00 S. 1/4
 6' x 9' S. 1/4
 S. 1/4 of 174

3 TOWN OF MIDDLESEX

518 626+60 S. 1/4
 10' x 15' E. Stone Pile
 518 626+60 S. 1/4
 6' x 9' S. 1/4
 S. 1/4 of 174

Q CURVE DATA
 Arc Def
 P.I. 631+06.0
 Δ = 50°15'30"
 R = 1,000.00
 L = 895.15
 T = 628.11
 E = 199.37

RELOCATED & SPIRAL CURVE DATA
 Arc Def
 P.I. 631+06.0
 Δ = 50°15'30"
 R = 1,000.00
 L = 895.15
 T = 628.11
 E = 199.37

B.M. 101-A S.O.L. 137' Lt. Sta. 626+60 Elev. 500.99'
 B.M. 101-B S.O.L. 137' Lt. Sta. 626+60 Elev. 500.99'
 B.M. 101-C S.O.L. 137' Lt. Sta. 626+60 Elev. 500.99'

B.M. 101-A S.O.L. 137' Lt. Sta. 626+60 Elev. 500.99'

B.M. 102-C S.I.T. 0° 00' 103' Lt. Sta. 631+62 Elev. 503.10'

STATE OF VERMONT DEPARTMENT OF HIGHWAYS			
INTERSTATE PROJECT IN THE TOWNS OF MIDDLESEX — WATERBURY			
PLAN			
WILLIAM H. McFARLAND ENGINEER BINGHAMTON, N. Y.			
DRAWN BY	CHECKED BY	SCALE	F. 150'
PROJECT NO. 188-1(3)	IN CHARGE	DATE	
CONTRACT NO.		SHEET 38	OF 315

8